


PROFILE SURVEYED BY DATE
 NOTE BOOK PLOTTED
 GRADES CHECKED B.M. * NOTED
 NO. STRUCTURE NOTATIONS CHFD



PROFILE SURVEYED BY DATE
 NOTE BOOK PLOTTED
 GRADES CHECKED B.M. * NOTED
 NO. STRUCTURE NOTATIONS CHFD

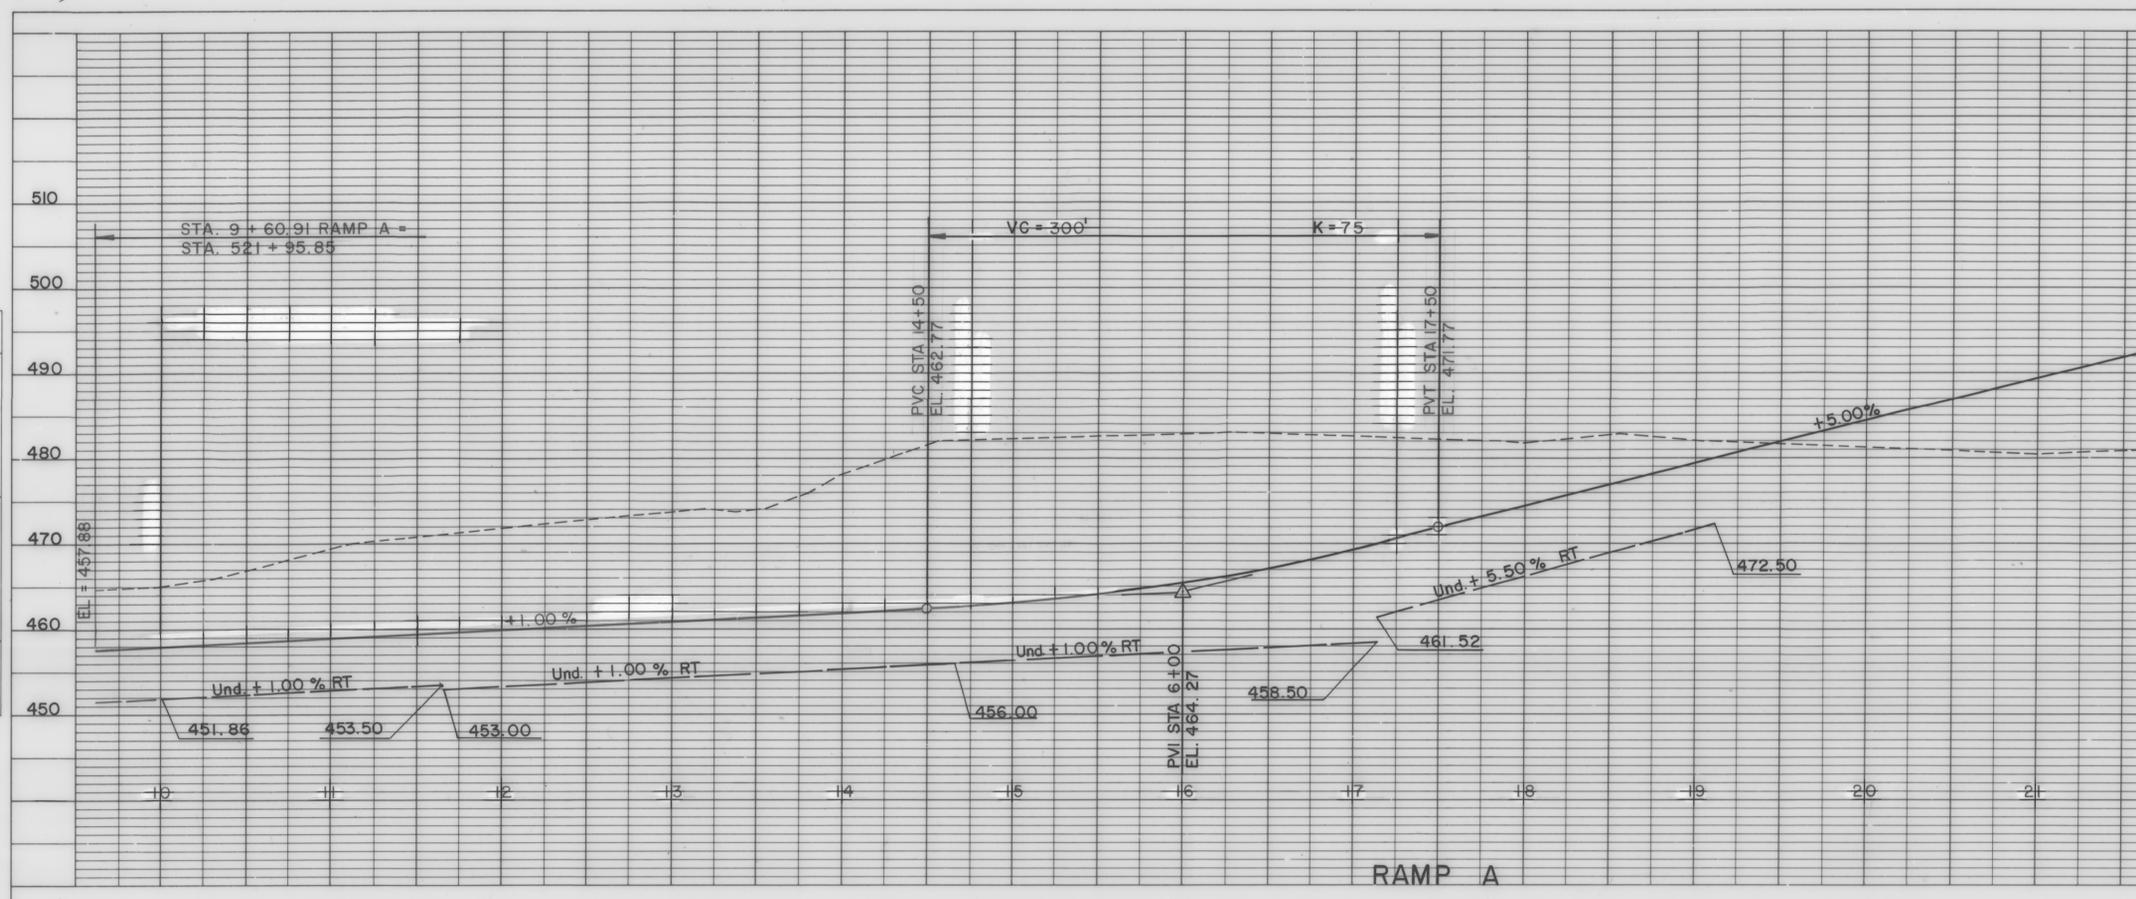