



PROFILE SURVEYED BY DATE
 PLOTTED GRADES CHECKED
 NOTE BOOK NO. B.M. # NOTED
 STRUCTURE NOTATIONS SH/10

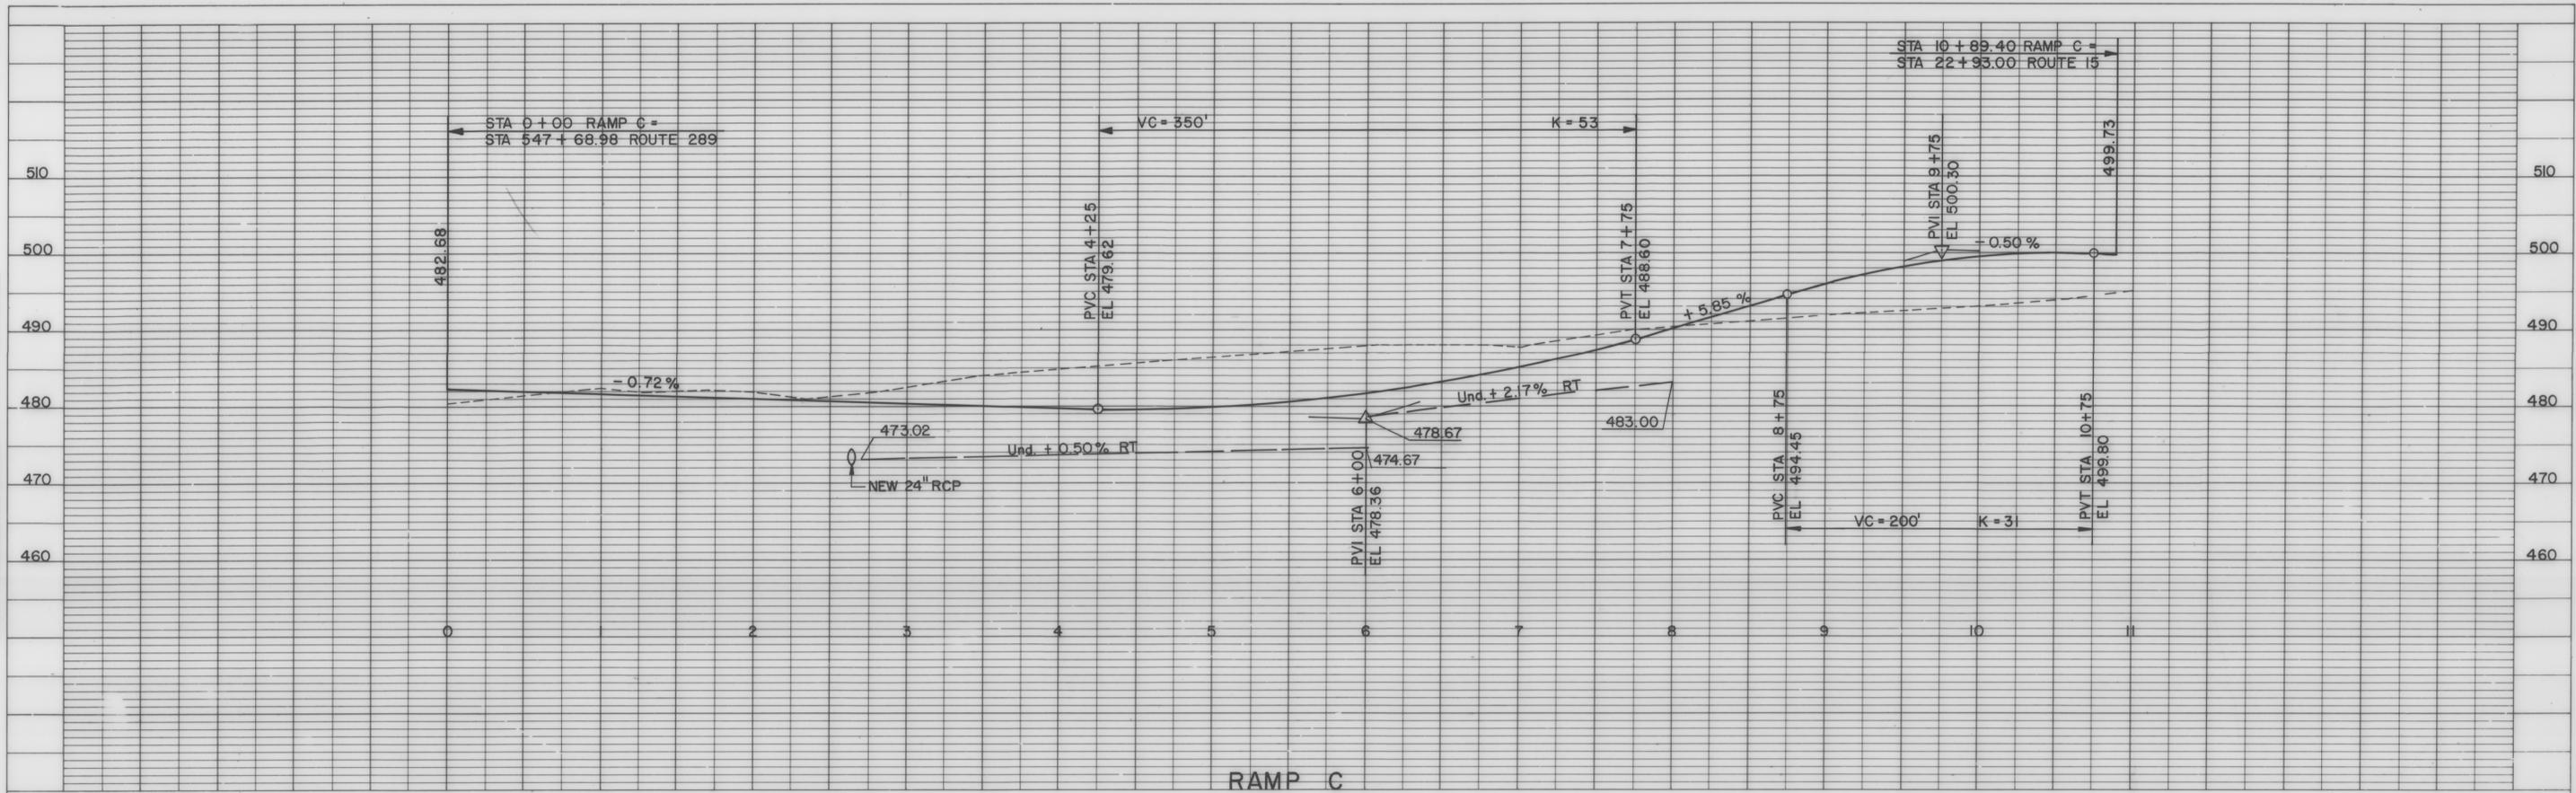

RAMP C

PROFILE SURVEYED BY DATE
 PLOTTED GRADES CHECKED
 NOTE BOOK NO. B.M. # NOTED
 STRUCTURE NOTATIONS SH/10

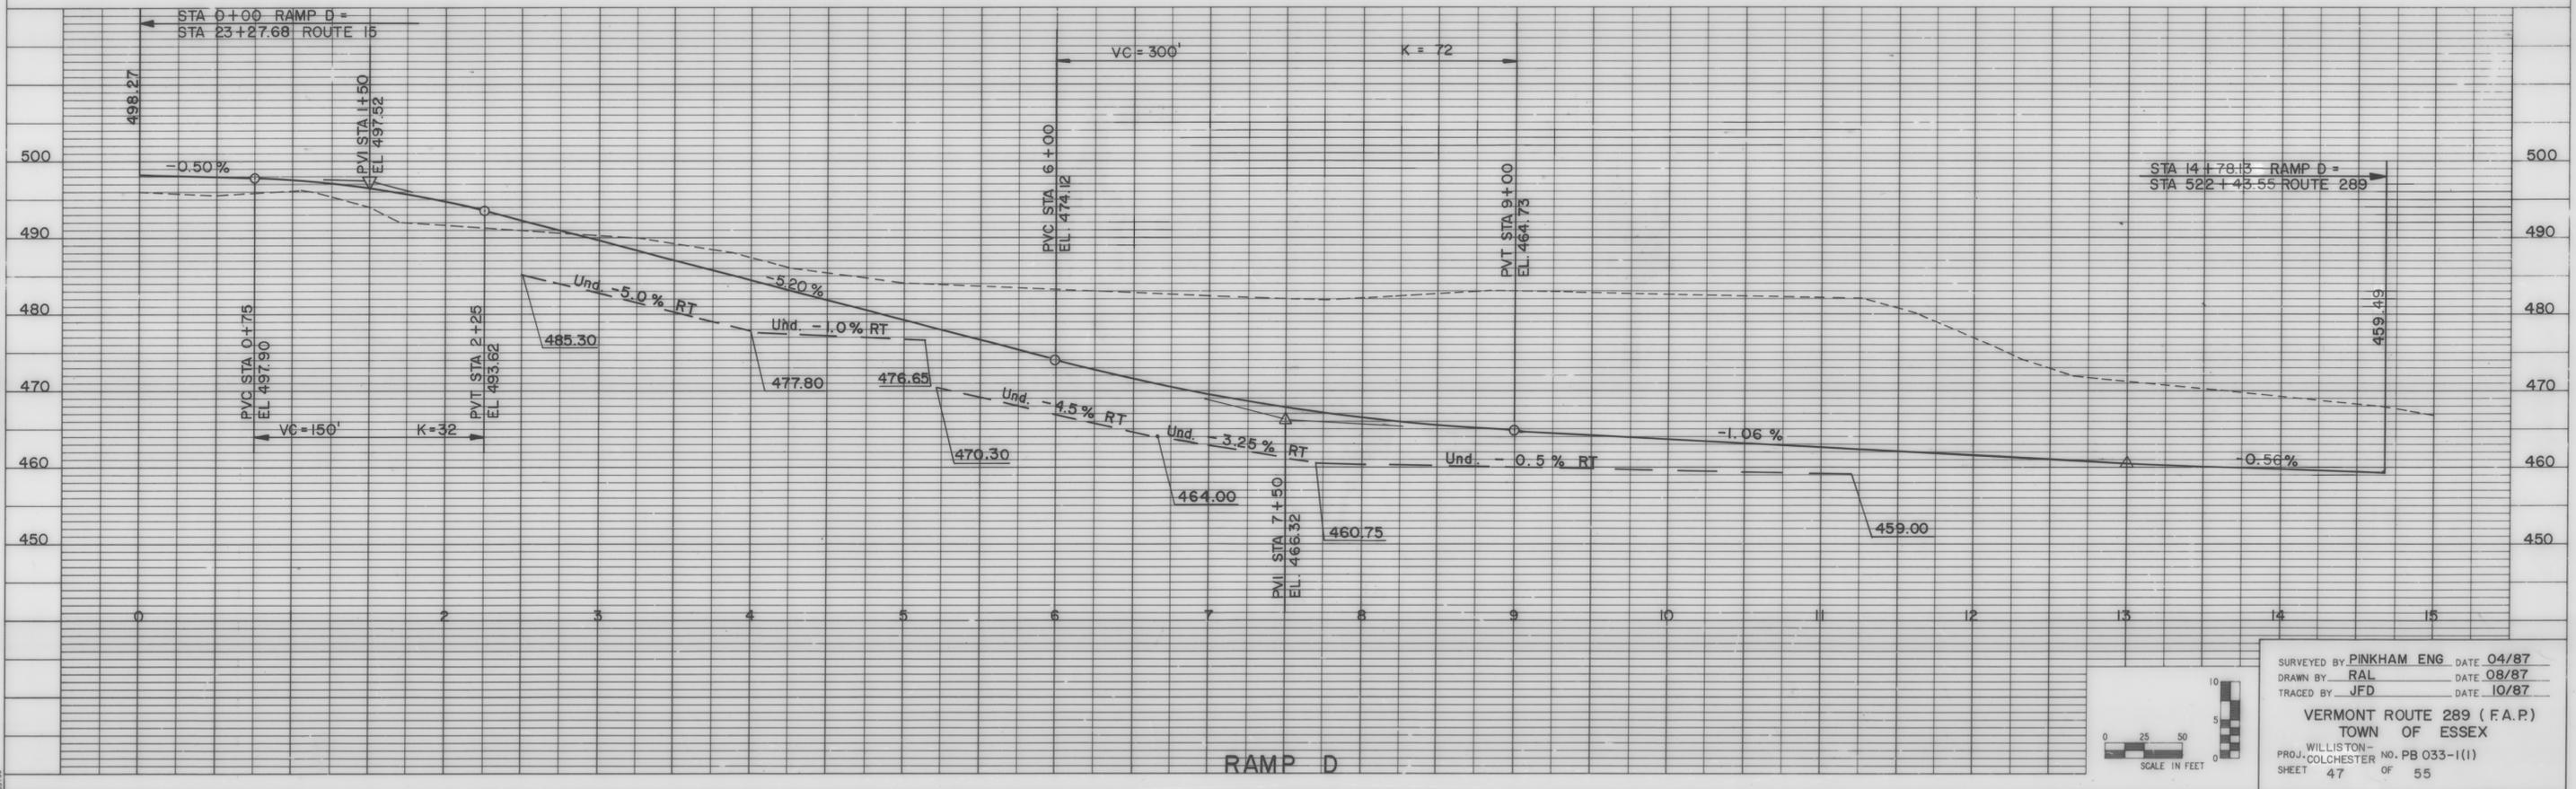

RAMP D



SURVEYED BY PINKHAM ENG. DATE 04/87
 DRAWN BY RAL DATE 08/87
 TRACED BY JFD DATE 10/87
 VERMONT ROUTE 289 (F.A.P.)
 TOWN OF ESSEX
 WILLISTON-COLCHESTER NO. PB 033-1(1)
 SHEET 47 OF 55