



PROFILE SURVEYED BY DATE  
 NOTE BOOK PLOTTED GRADES CHECKED  
 NO. B.M.'S NOTED STRUCTURE NOTATIONS CH'VD

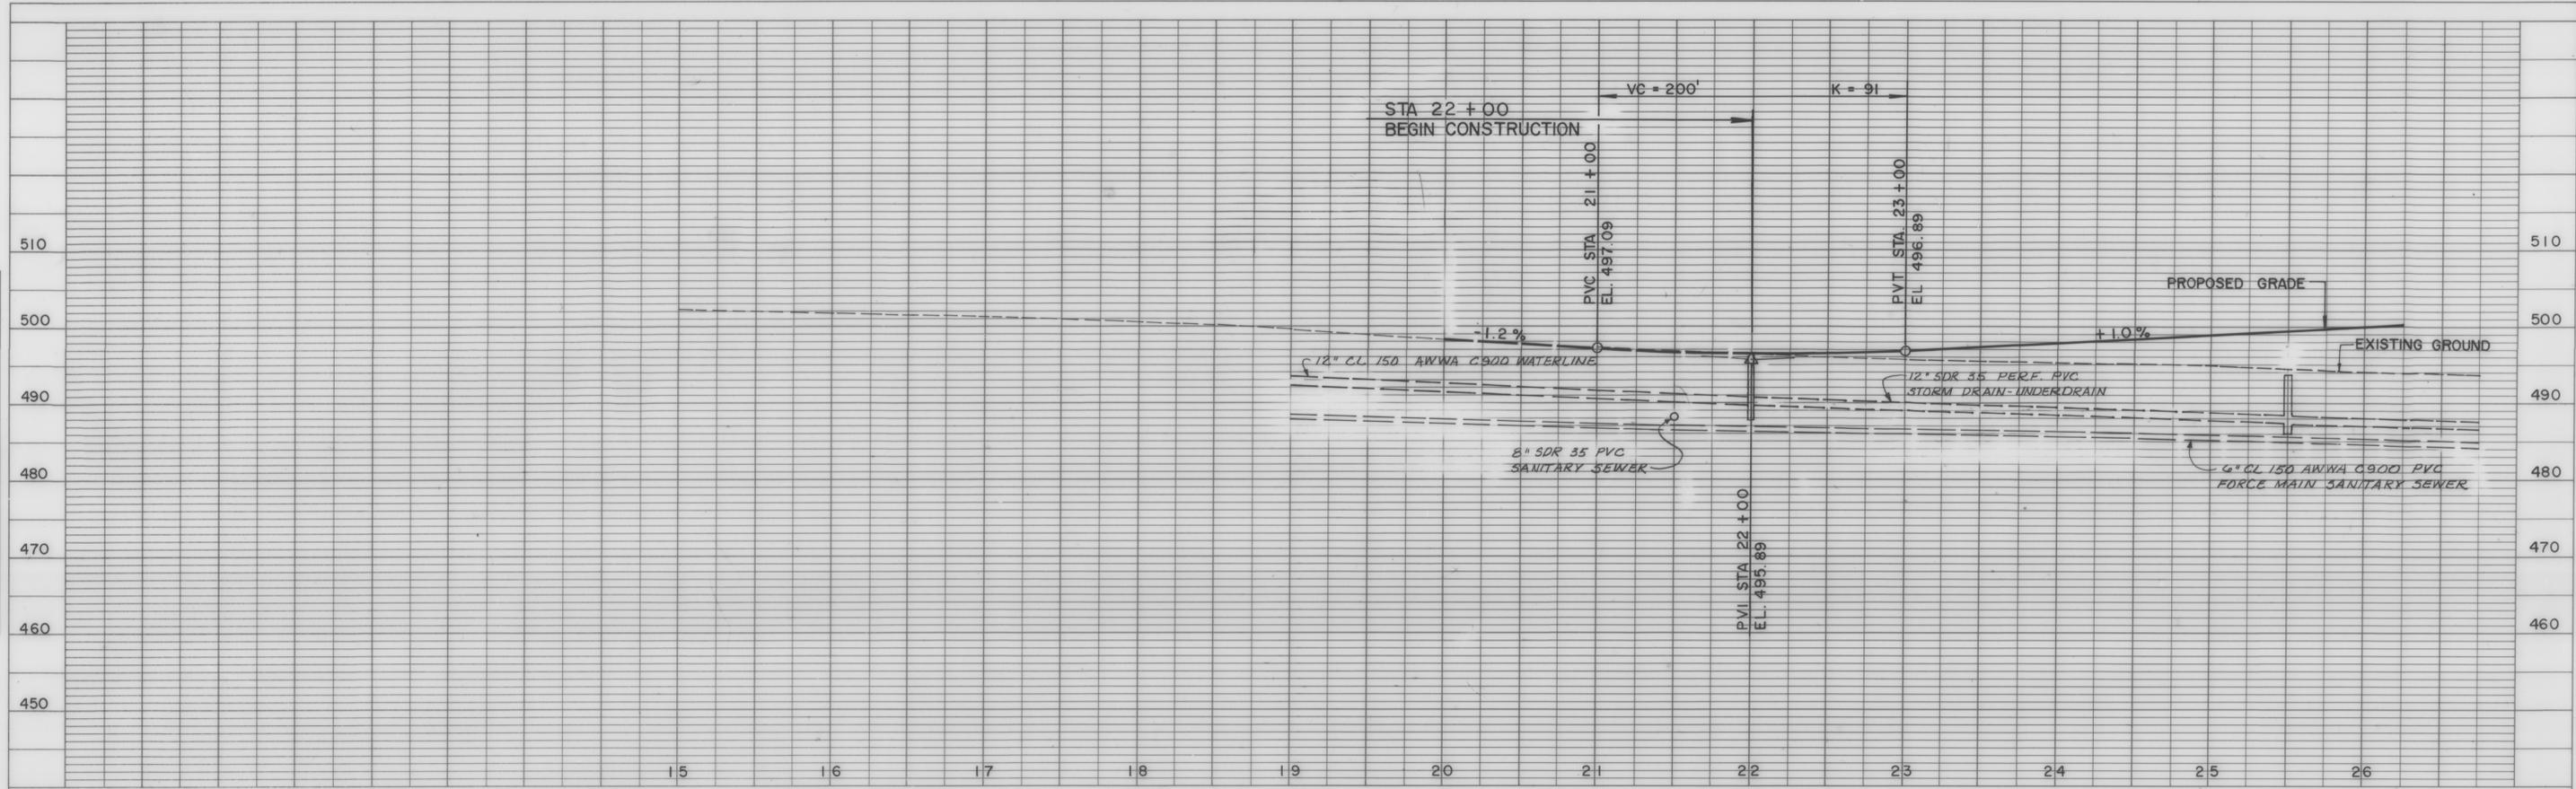

PROFILE SURVEYED BY DATE  
 NOTE BOOK PLOTTED GRADES CHECKED  
 NO. B.M.'S NOTED STRUCTURE NOTATIONS CH'VD

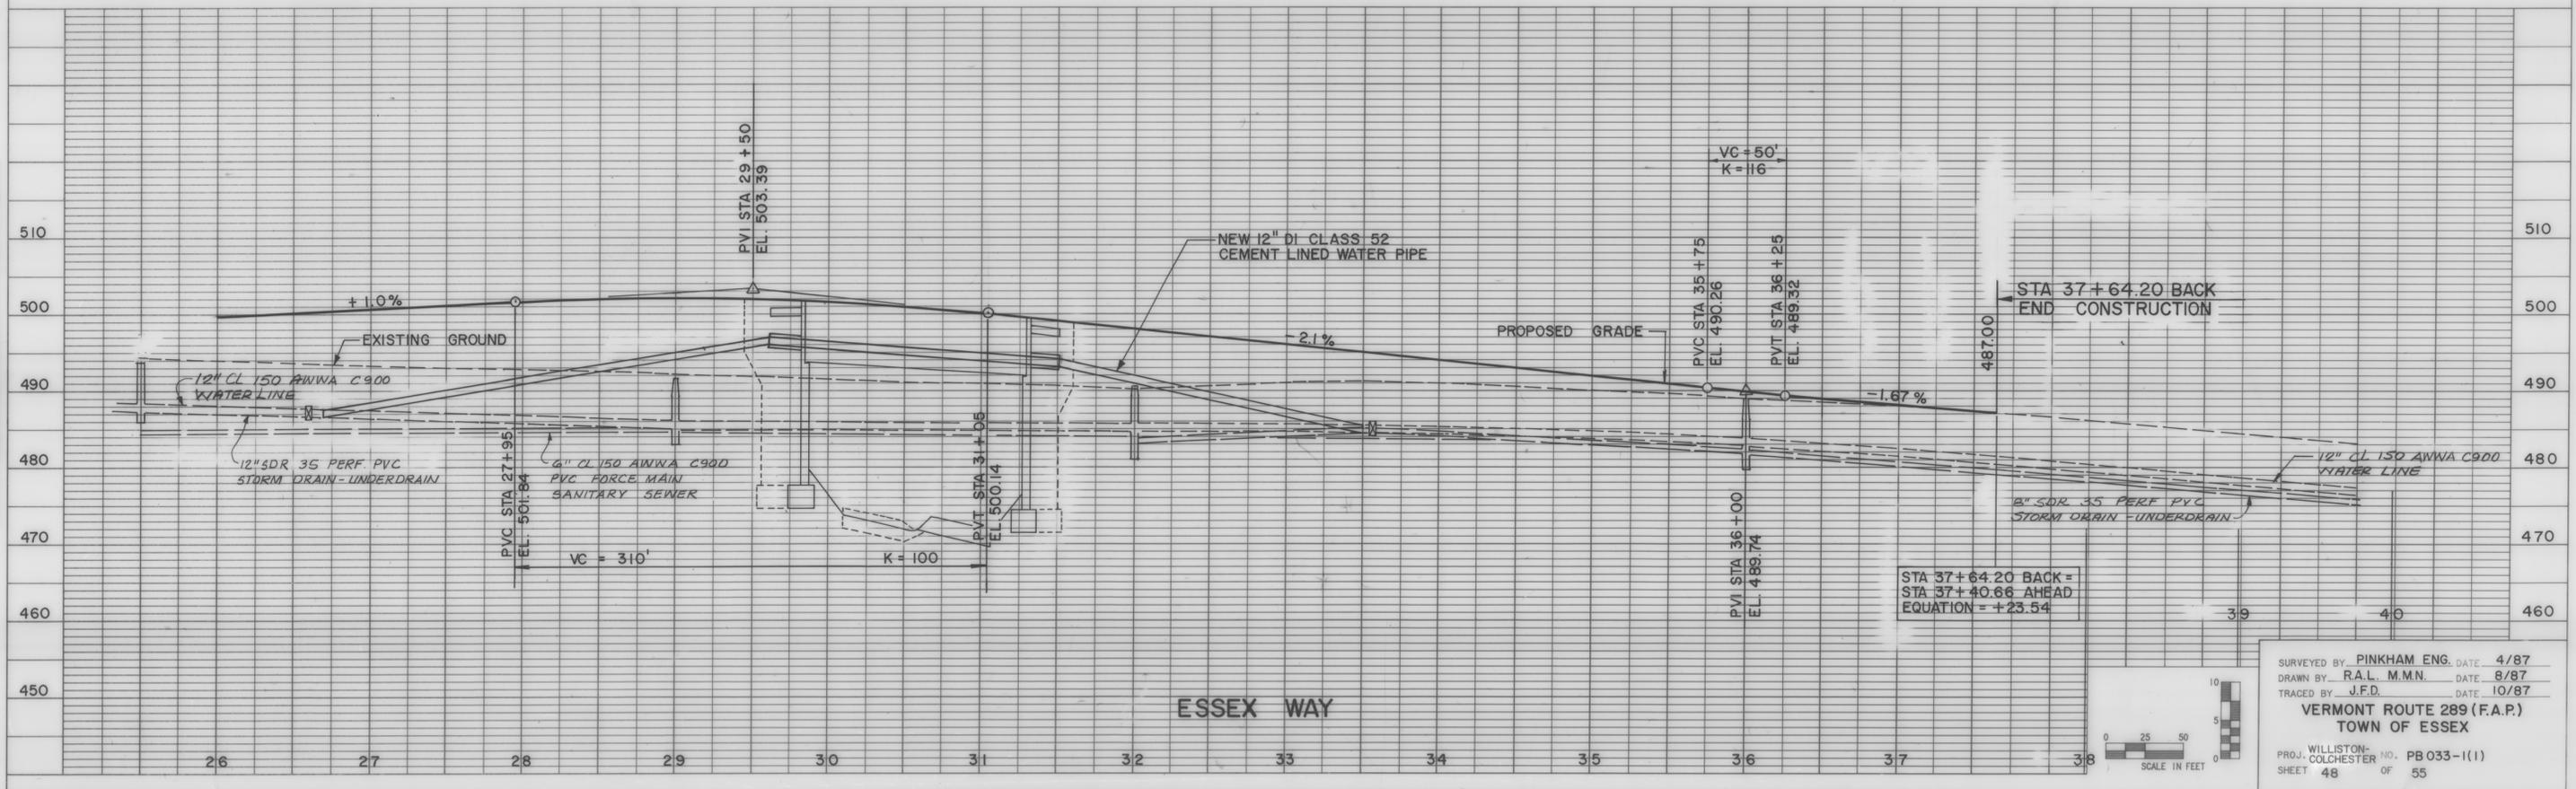

SURVEYED BY PINKHAM ENG. DATE 4/87  
 DRAWN BY R.A.L. M.M.N. DATE 8/87  
 TRACED BY J.F.D. DATE 10/87  
**VERMONT ROUTE 289 (F.A.P.)**  
**TOWN OF ESSEX**  
 PROJ. WILLISTON-COLCHESTER NO. PB 033-1(1)  
 SHEET 48 OF 55