



PROFILE SURVEYED BY DATE
 NOTE BOOK PLOTTED
 GRADES CHECKED
 B.M. # NOTED
 STRUCTURE NOTATION CH'VD
 NO.

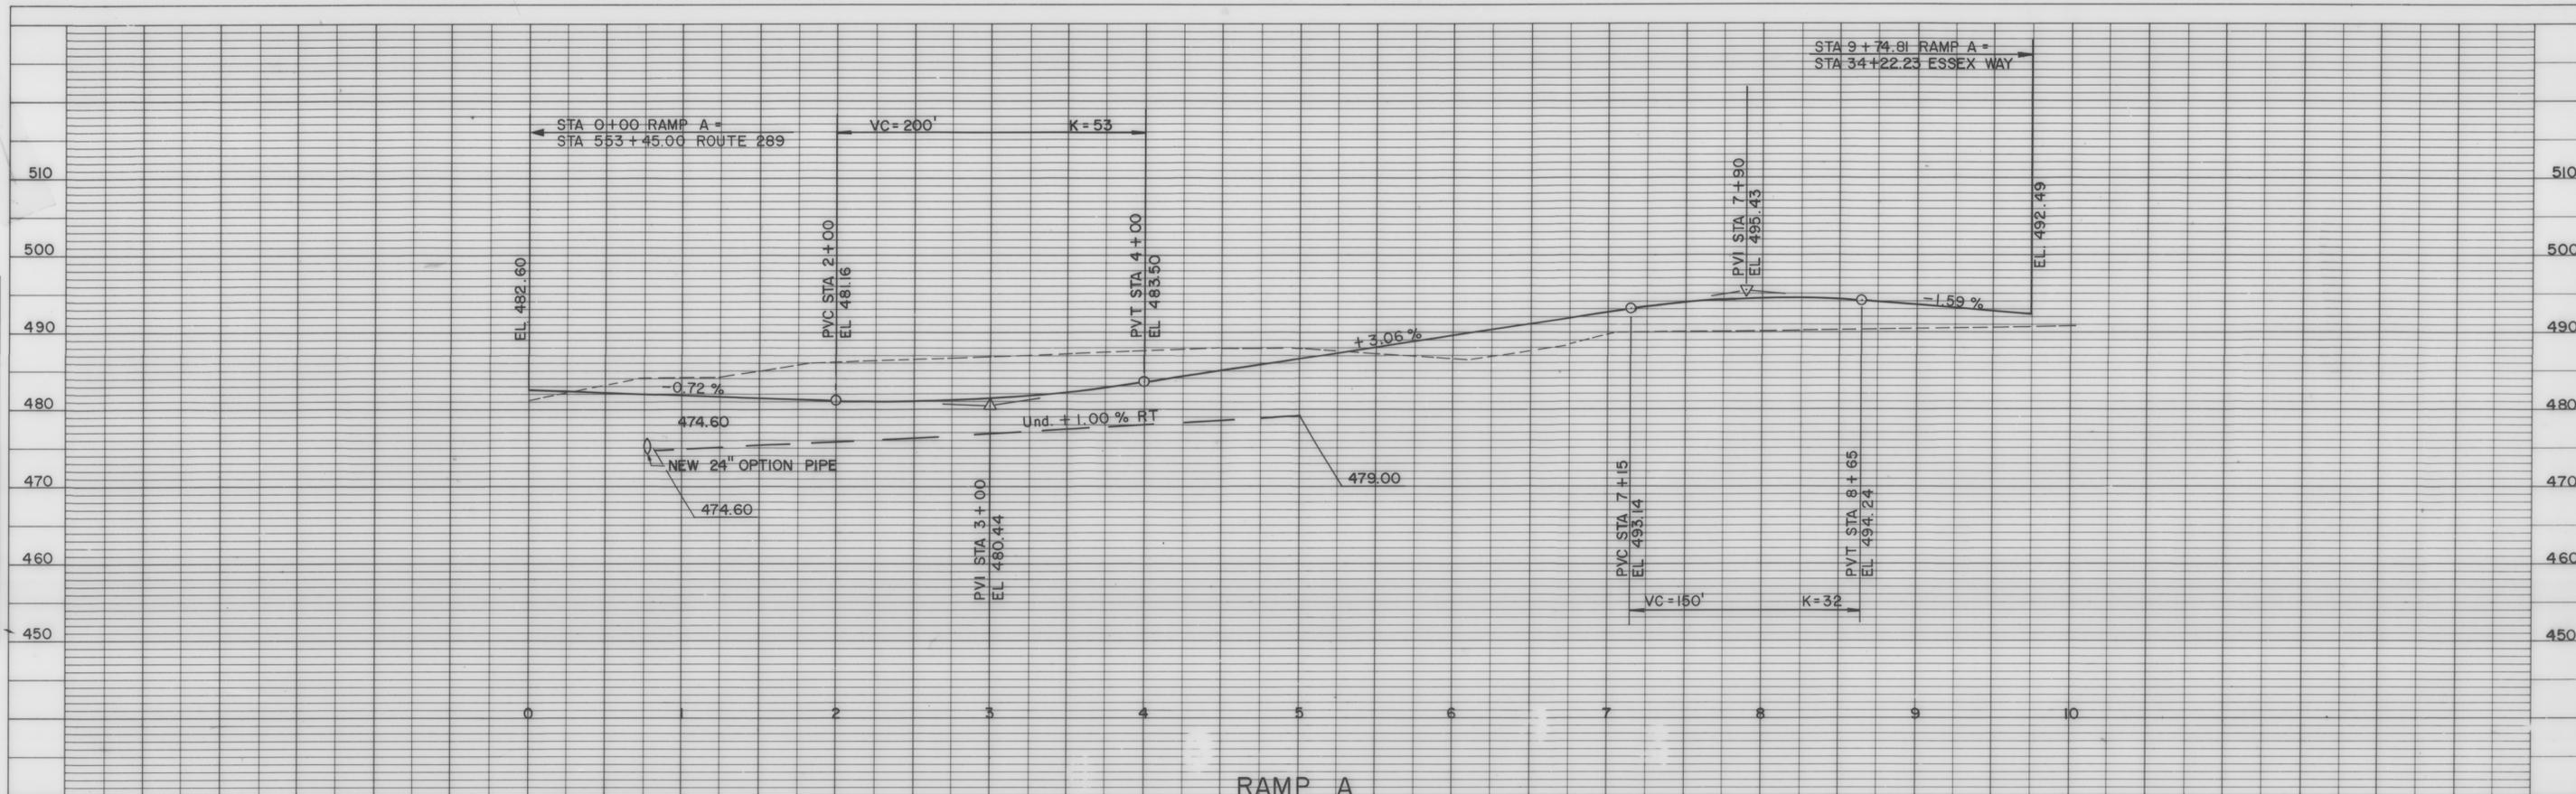

RAMP A

PROFILE SURVEYED BY DATE
 NOTE BOOK PLOTTED
 GRADES CHECKED
 B.M. # NOTED
 STRUCTURE NOTATION CH'VD
 NO.

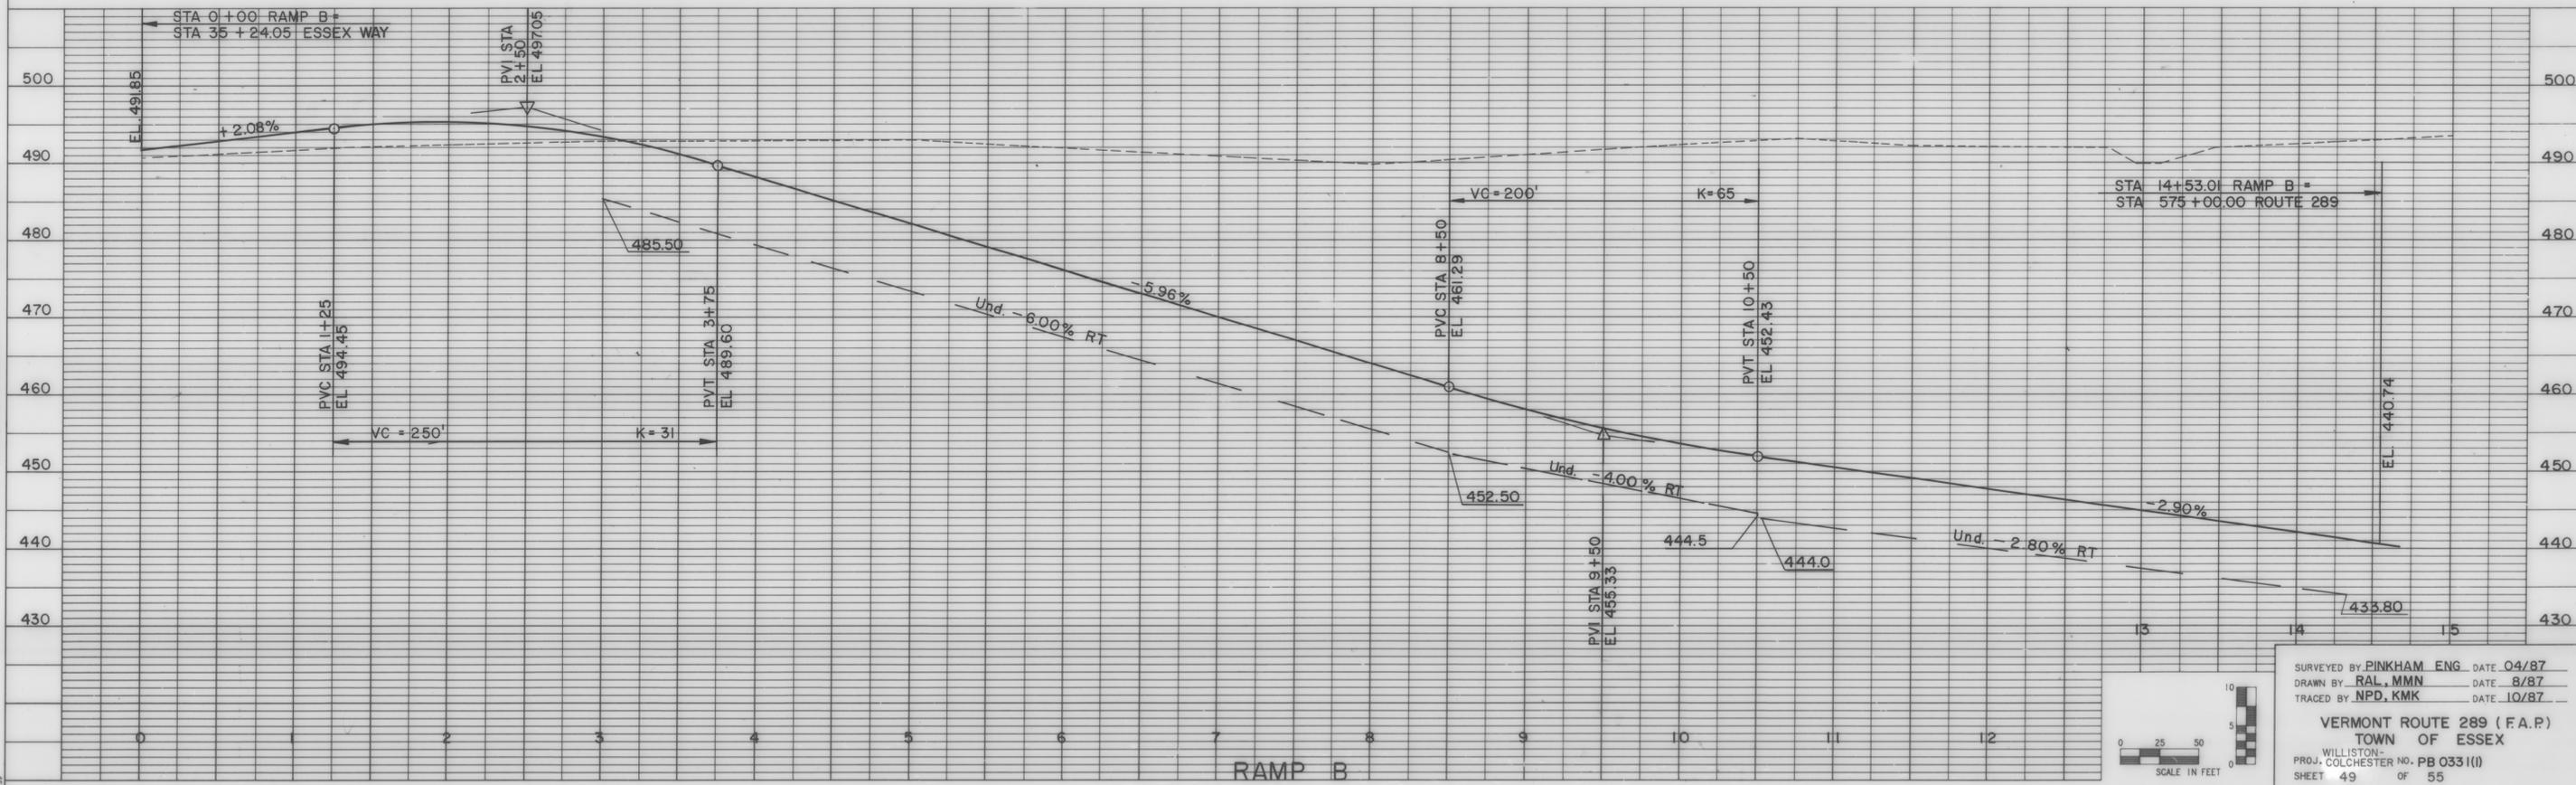

RAMP B



SURVEYED BY PINKHAM, ENG. DATE 04/87
 DRAWN BY RAL, MMN DATE 8/87
 TRACED BY NPD, KMK DATE 10/87
 VERMONT ROUTE 289 (F.A.P.)
 TOWN OF ESSEX
 WILLISTON-
 PROJ. COLCHESTER NO. PB 033 I(I)
 SHEET 49 OF 55