
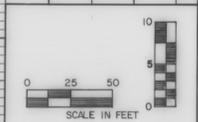


PLAN	SURVEYED	DATE
	PLOTTED	BY
	ALIGNED CHECKED	
	AT. OF WAY CHECKED	
	No.	

PROFILE	SURVEYED	DATE
	PLOTTED	BY
	GRADES CHECKED	
	STRUCTURE MODIFICATIONS CHECKED	
	No.	

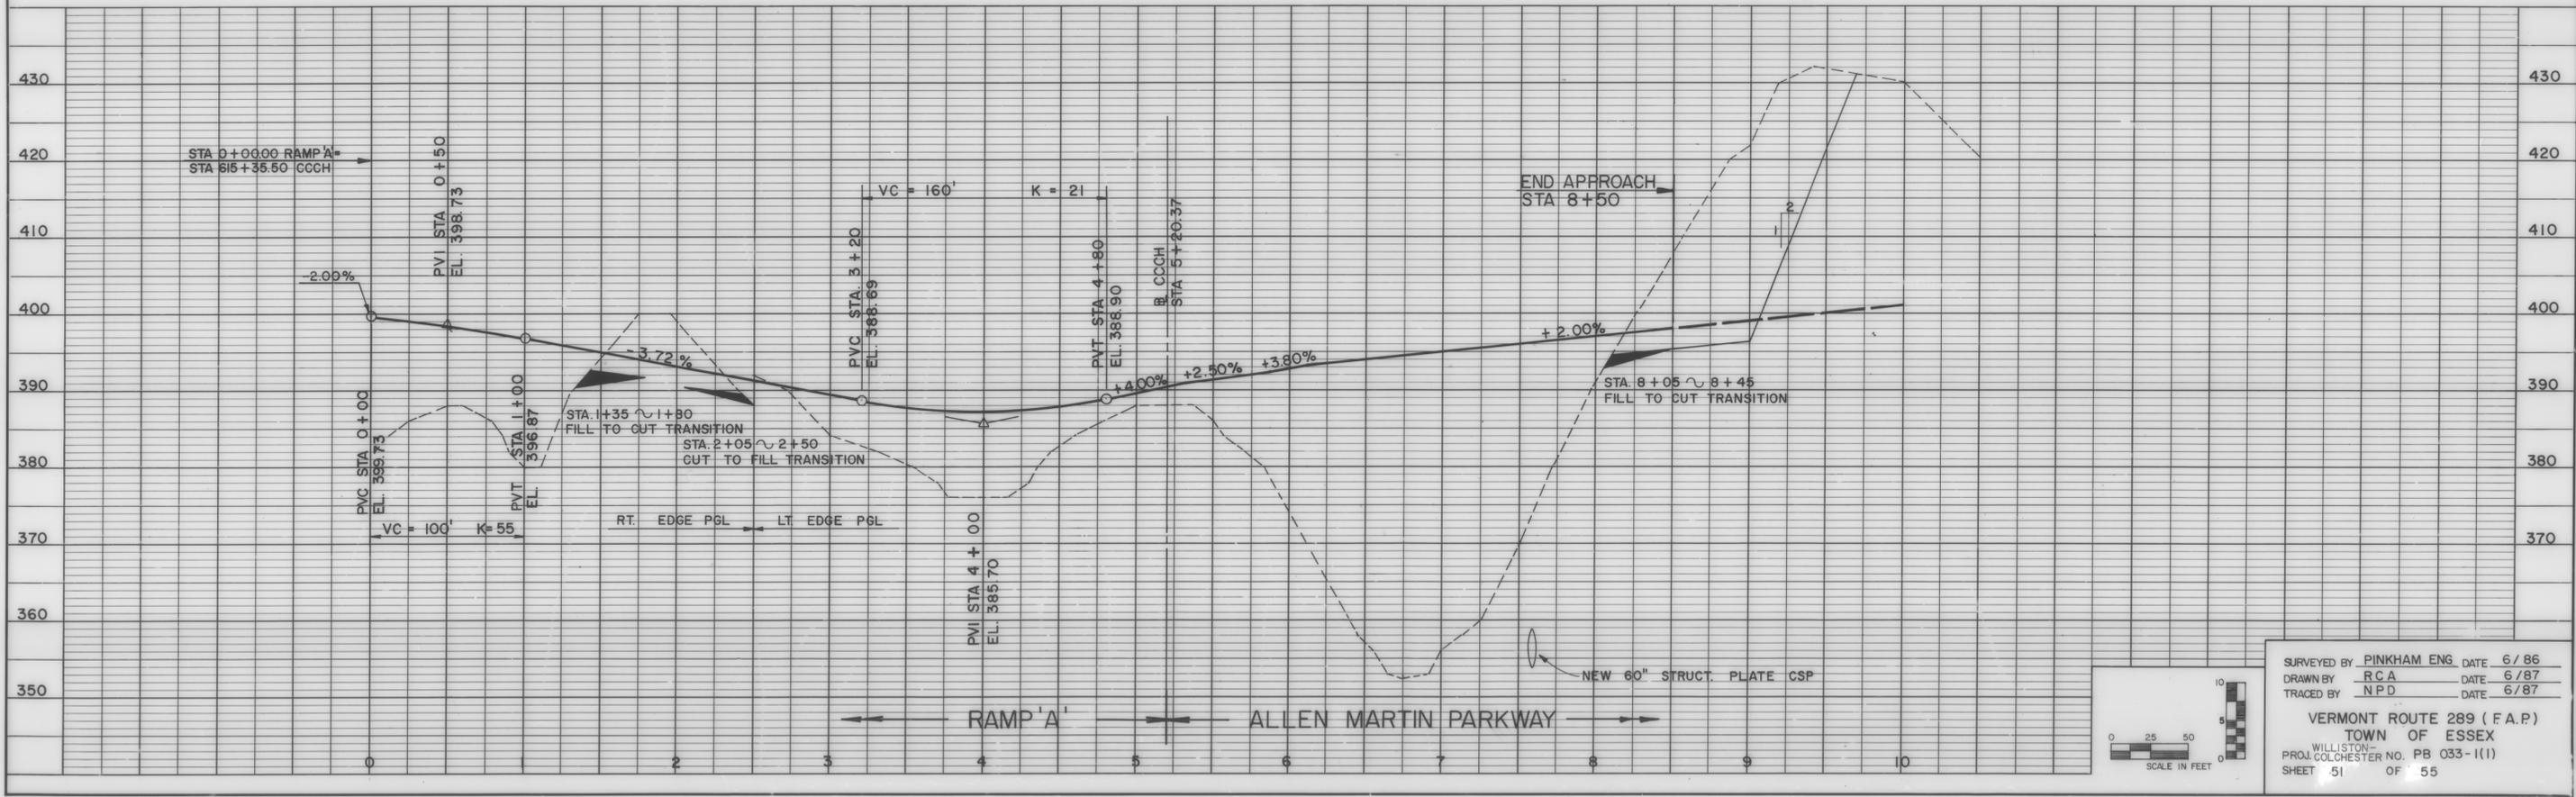

SURVEYED BY PINKHAM ENG. DATE 6/86
 DRAWN BY R.C.A. DATE 6/87
 TRACED BY N.P.D. DATE 6/87

VERMONT ROUTE 289 (F.A.P.)
 TOWN OF ESSEX
 WILLISTON
 PROJ. COLCHESTER NO. PB 033-1(1)
 SHEET 51 OF 55