

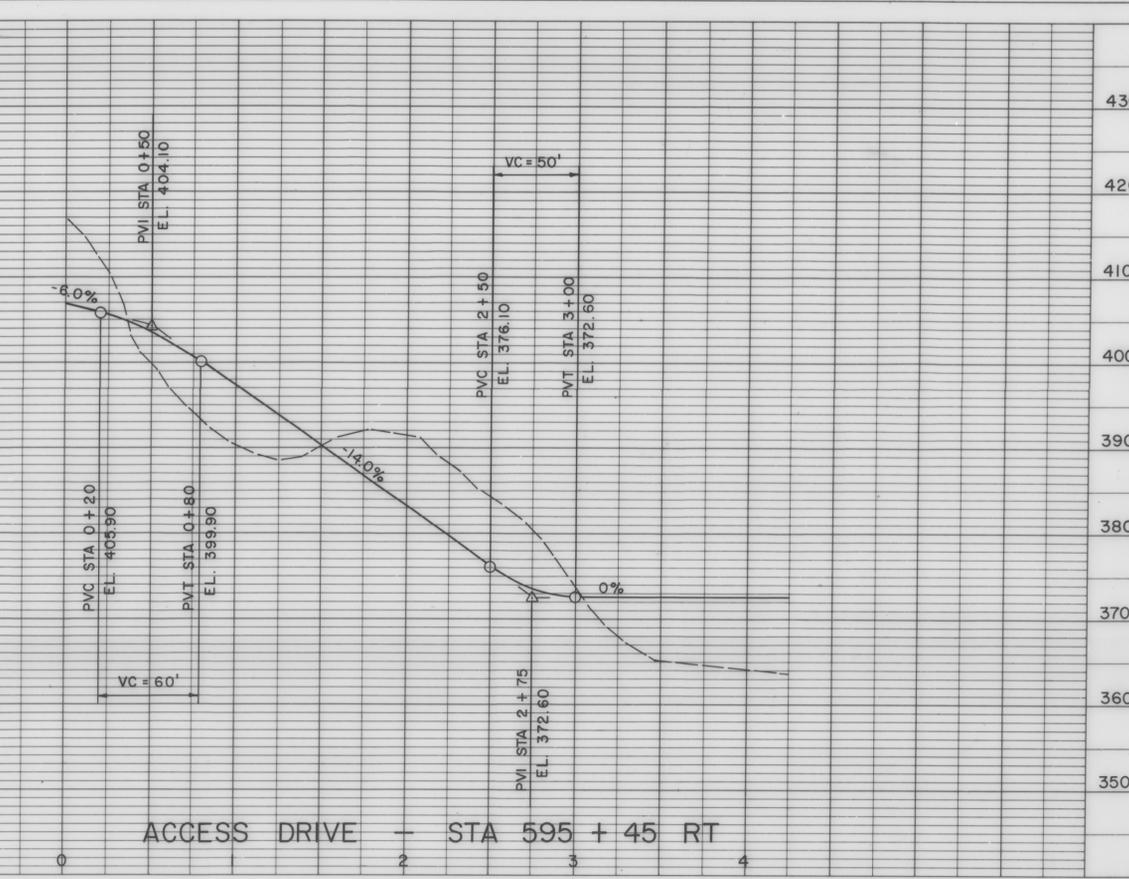
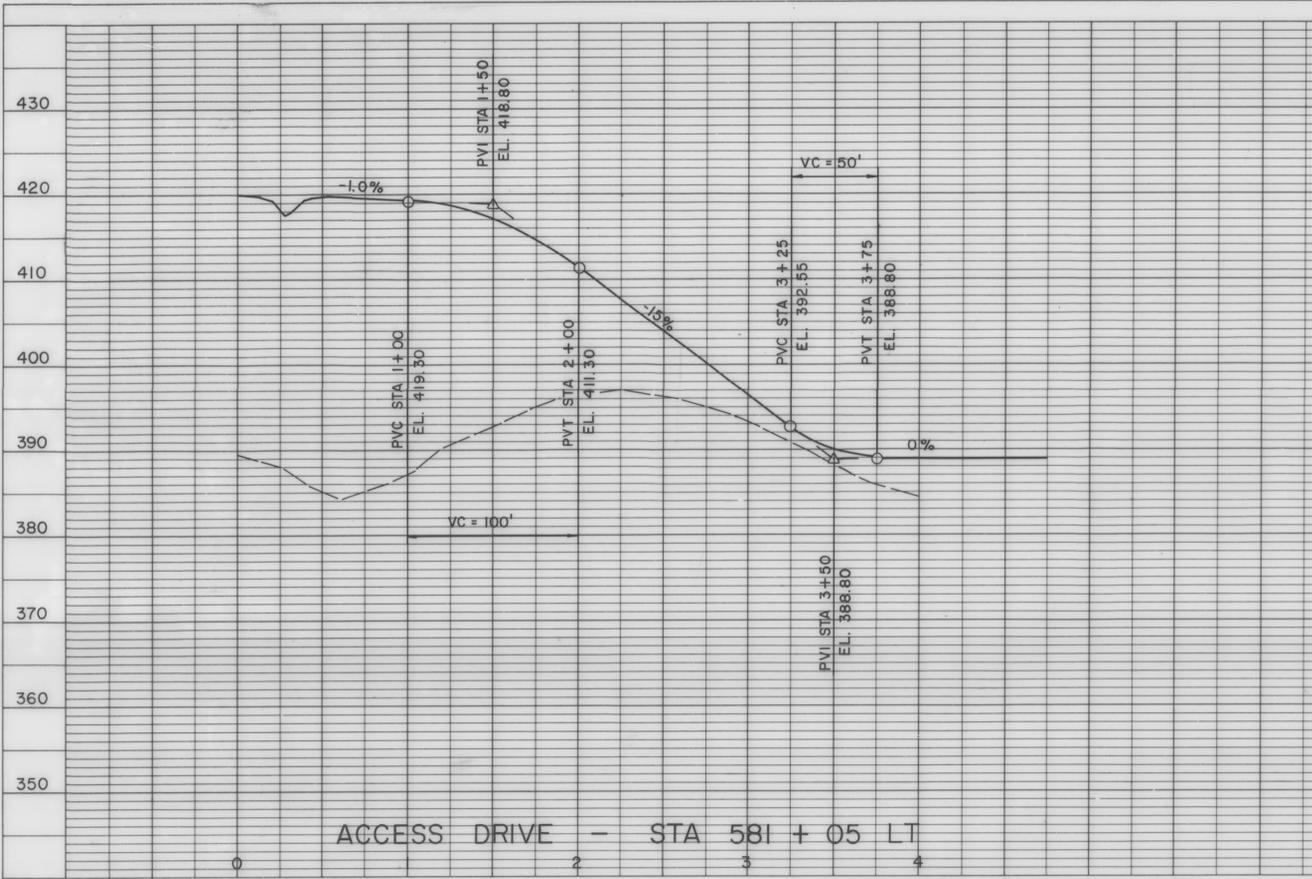
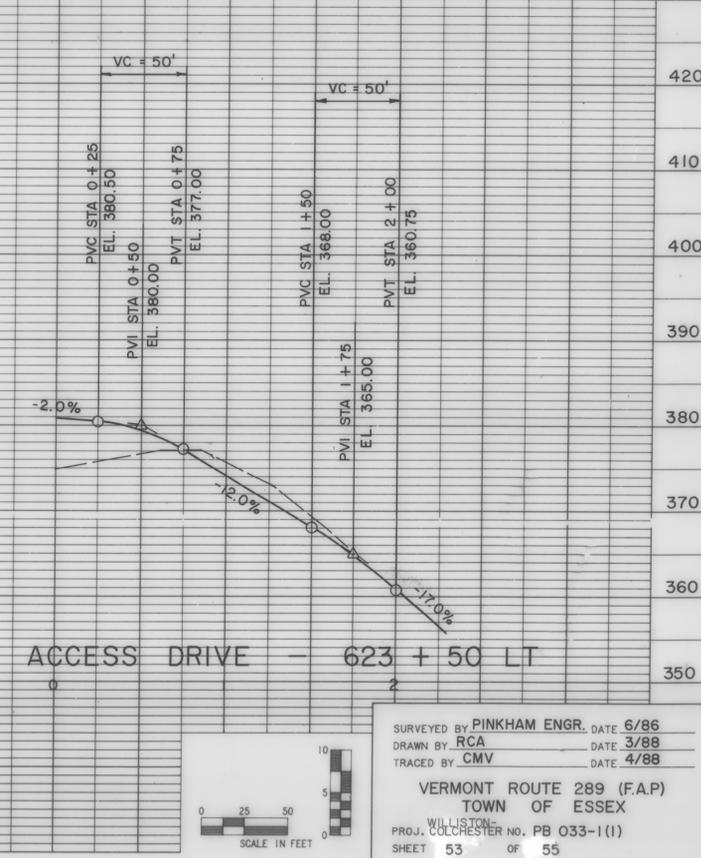


PROFILE SURVEYED BY DATE
 NOTE BOOK PLOTTED CHECKED
 NO. B.M.'s NOTED
 STRUCTURE NOTATION CH'VD

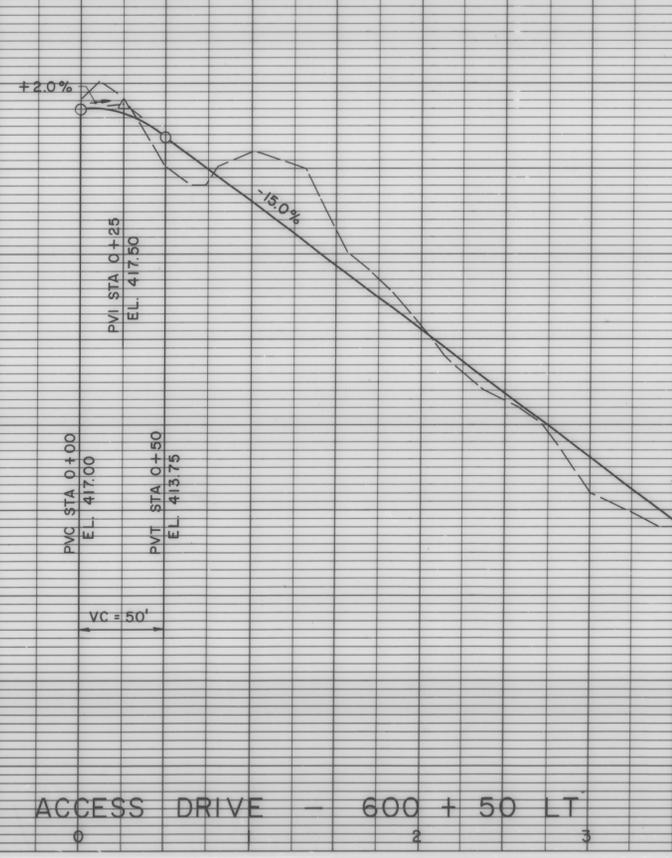

PROFILE SURVEYED BY DATE
 NOTE BOOK PLOTTED CHECKED
 NO. B.M.'s NOTED
 STRUCTURE NOTATION CH'VD

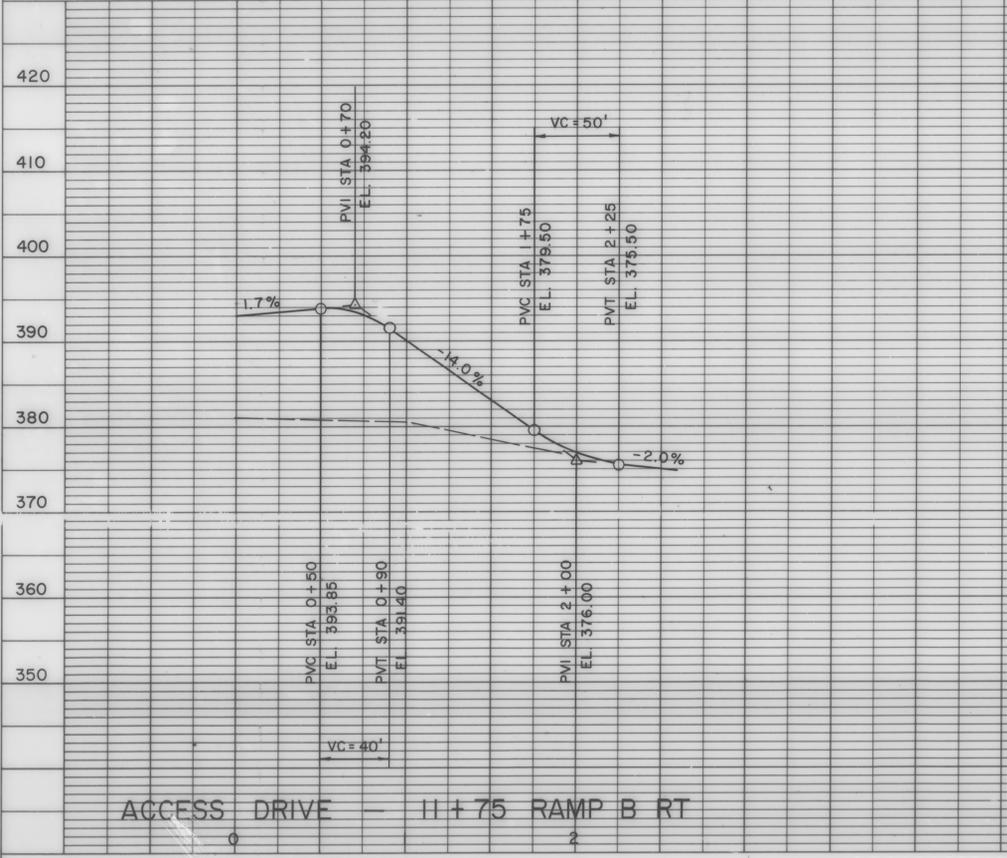

SURVEYED BY PINKHAM ENGR. DATE 6/86
 DRAWN BY RCA DATE 3/88
 TRACED BY CMV DATE 4/88
 VERMONT ROUTE 289 (F.A.P.)
 TOWN OF ESSEX
 WILLISTON
 PROJ. COLCHESTER NO. PB 033-1(1)
 SHEET 53 OF 55