
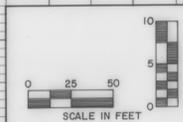
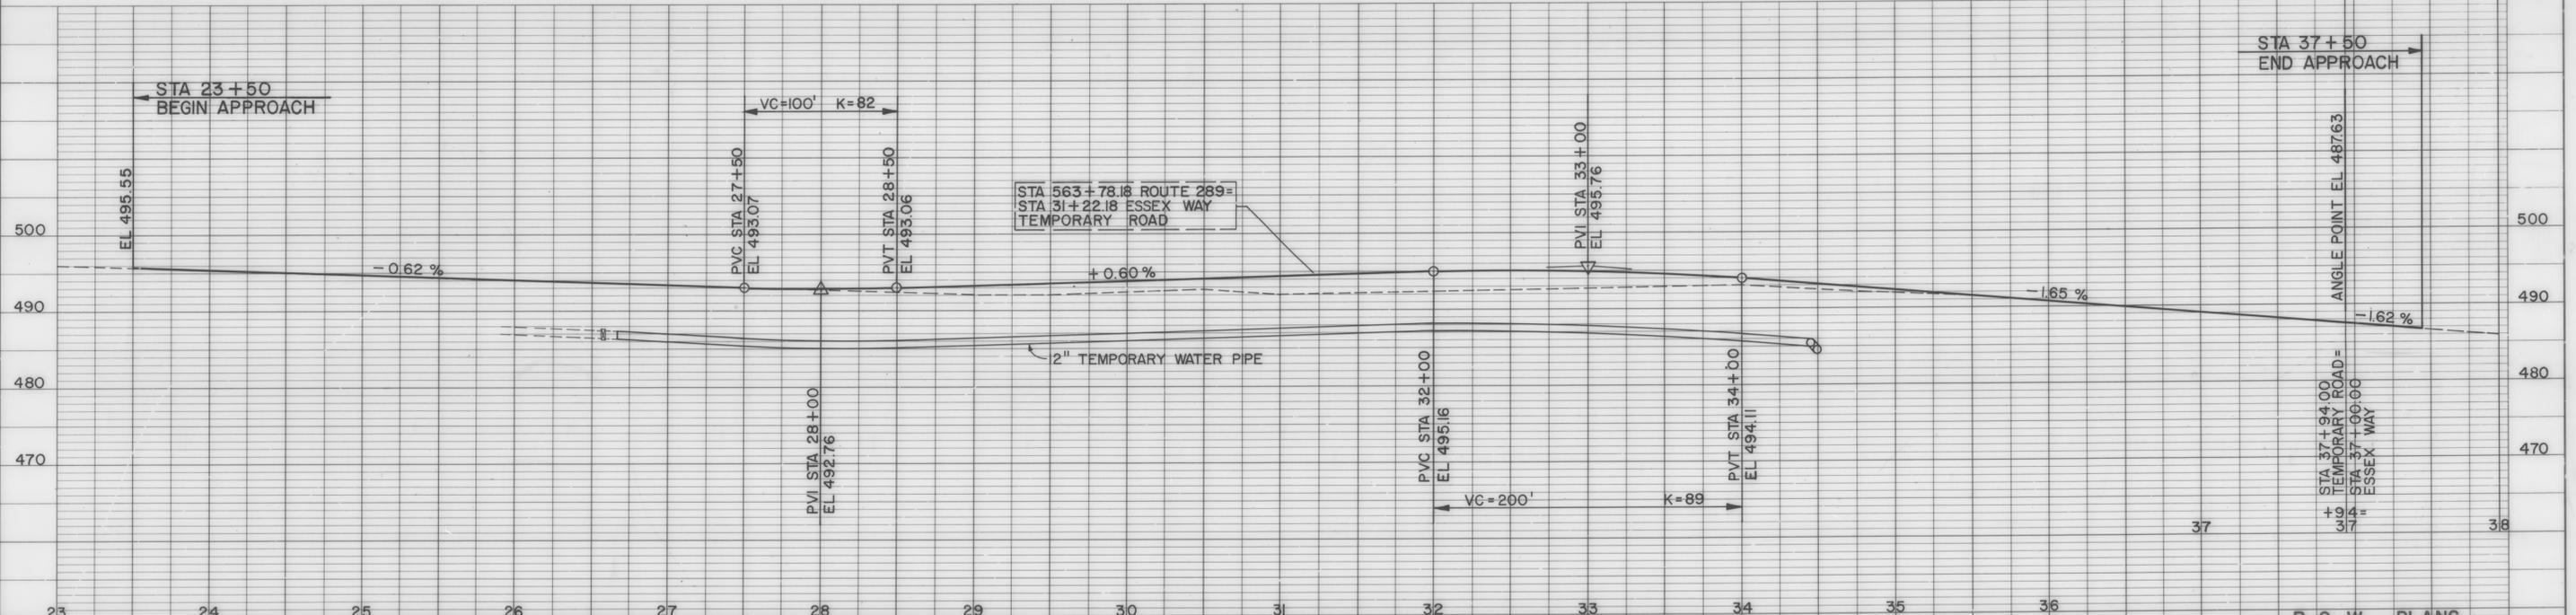


PLAN
 SURVEYED BY: _____ DATE: _____
 DRAWN BY: _____ DATE: _____
 CHECKED BY: _____ DATE: _____
 NOTE BOOK NO. _____
 NO. _____

PROFILE
 SURVEYED BY: _____ DATE: _____
 DRAWN BY: _____ DATE: _____
 CHECKED BY: _____ DATE: _____
 NOTE BOOK NO. _____
 NO. _____

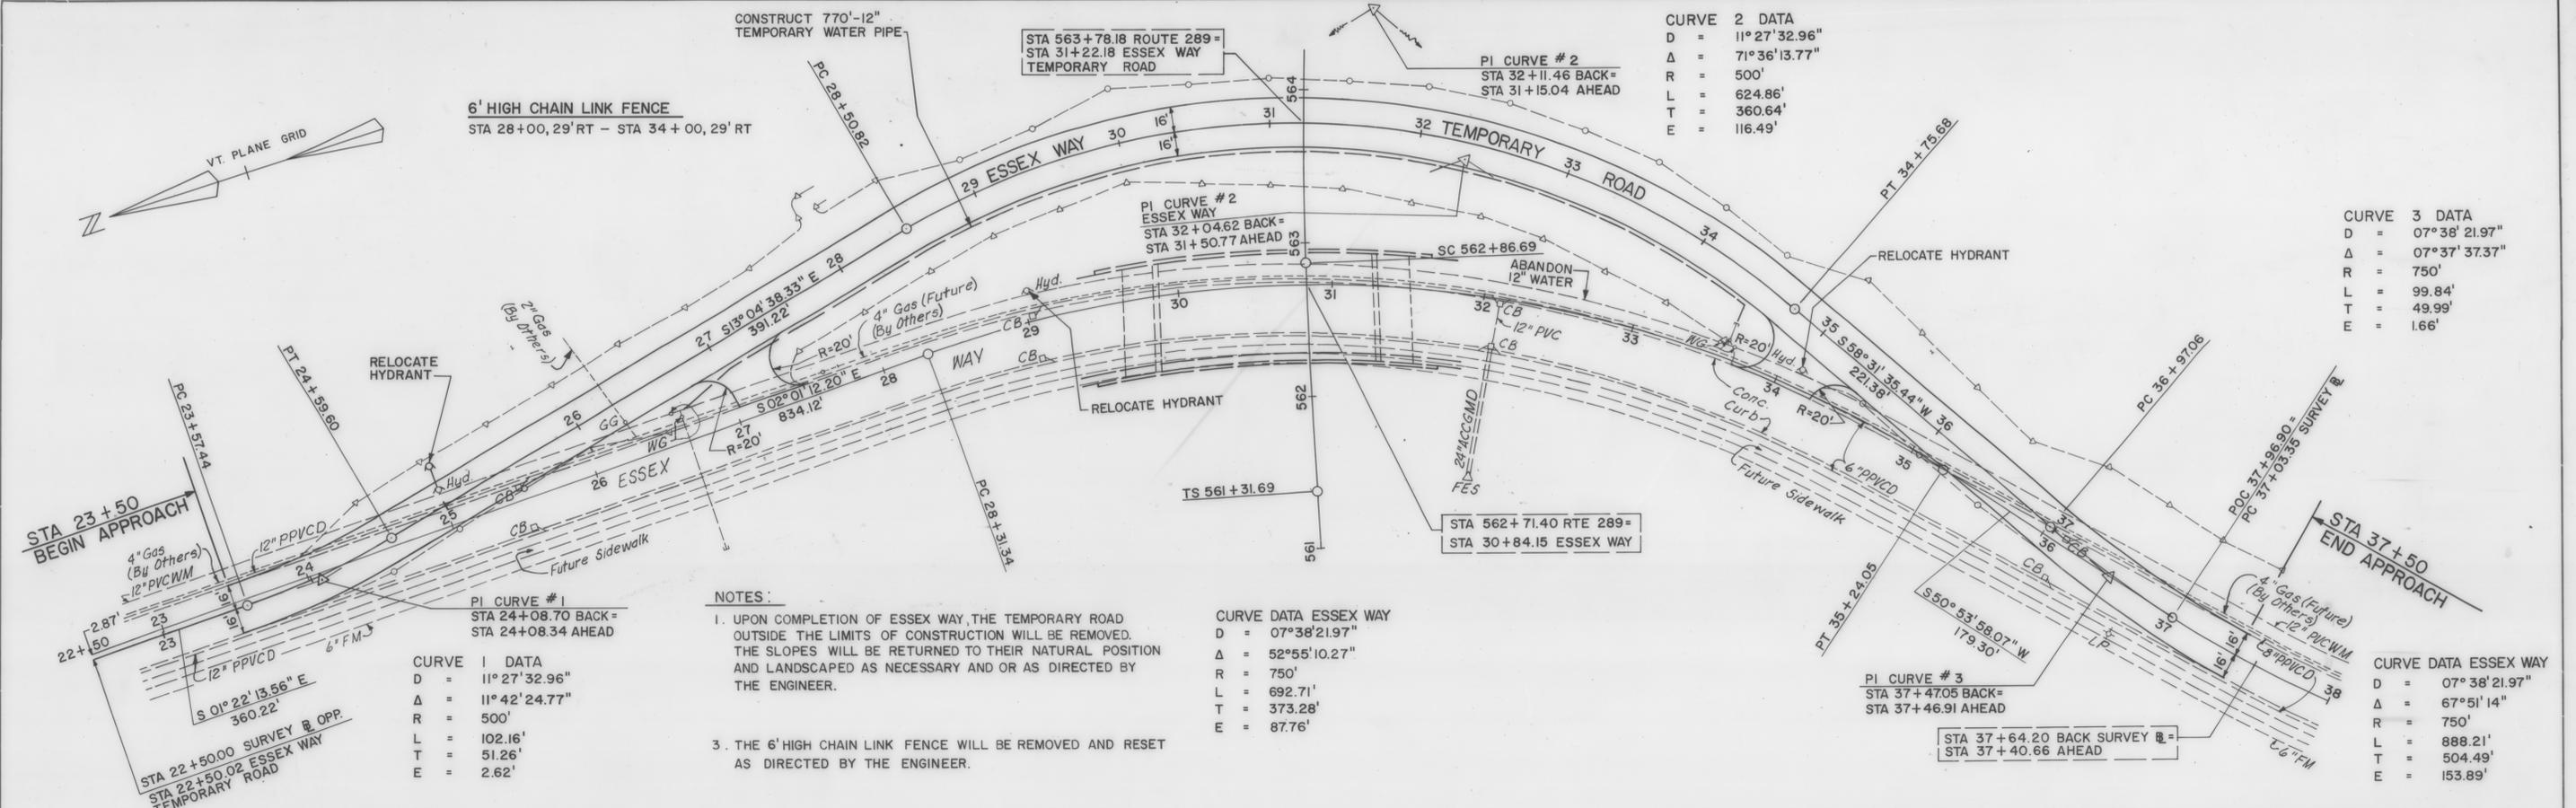

R. O. W. PLANS

SURVEYED BY: PINKHAM ENG. DATE: 04/86
 DRAWN BY: MN DATE: 09/87
 TRACED BY: JFD DATE: 10/87

VERMONT ROUTE 289 (F.A.P.)
 TOWN OF ESSEX

WILLISTON - PROJ. COLCHESTER NO. PB 033-1(1)
 SHEET 55 OF 55