


WESTBOUND ENTRANCE RAMP (A)

SC: 1" = 50' H
1" = 10' V

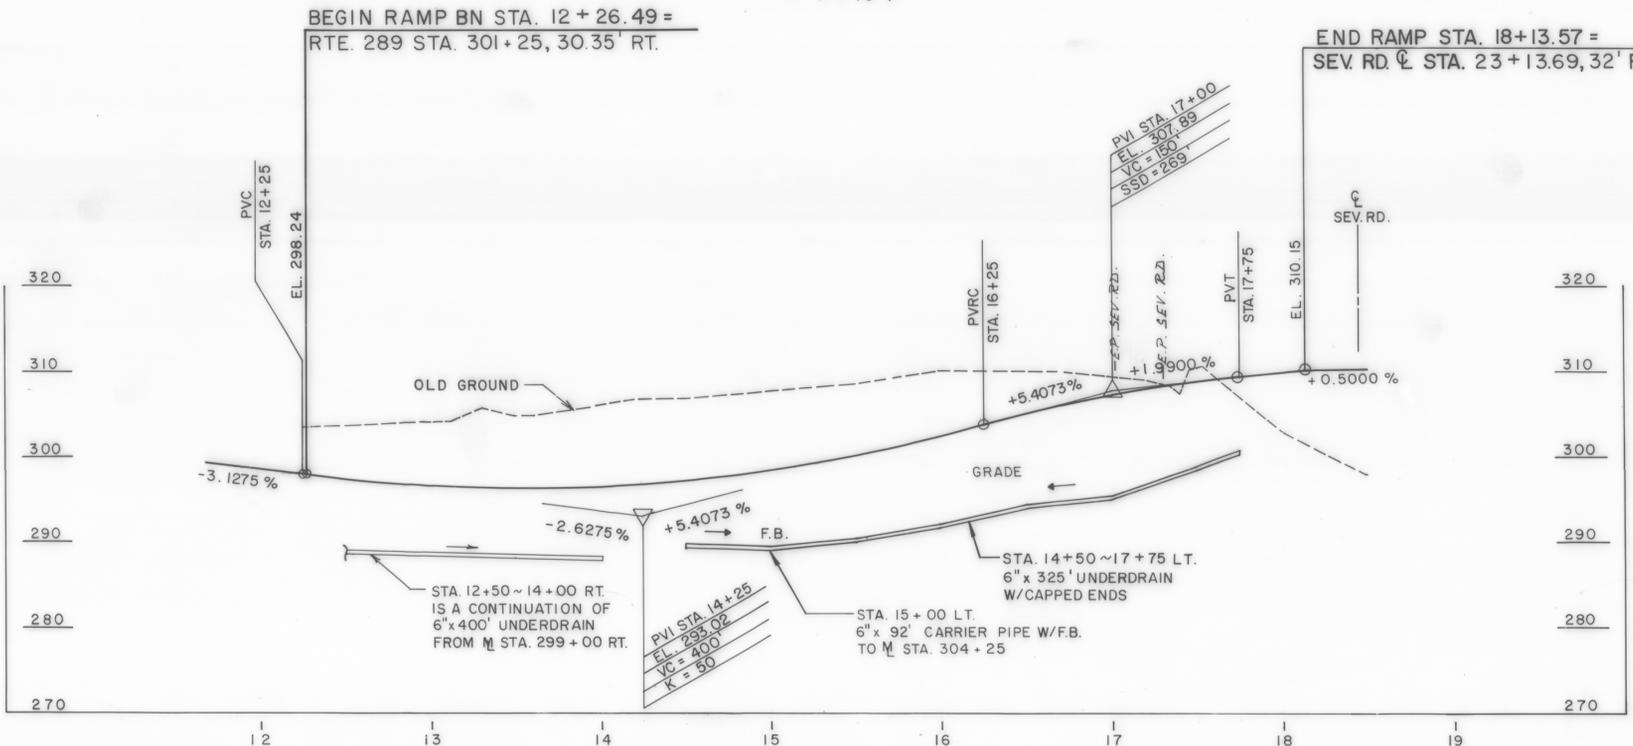

EASTBOUND EXIT RAMP (C)

SC: 1" = 50' H
1" = 10' V

<p>R.O.W. PLAN</p> <p>THIS SHEET TO BE USED FOR R.O.W. INFORMATION ONLY.</p>	<p>VT. SURVEY CONSULTANTS DATE FEB 1988</p>
	<p>DRAWN BY BRYANT ASSOC DATE FEB 1988</p>
	<p>TRACED BY _____ DATE _____</p>
	<p>WILLISTON - ESSEX - COLCHESTER SECTION 3</p>
	<p>PROJ. PB NO. 033-1(1) SHEET 42 OF 57</p>