


PROFILE
MILL POND ROAD
SC. 1" = 50' H
1" = 10' V

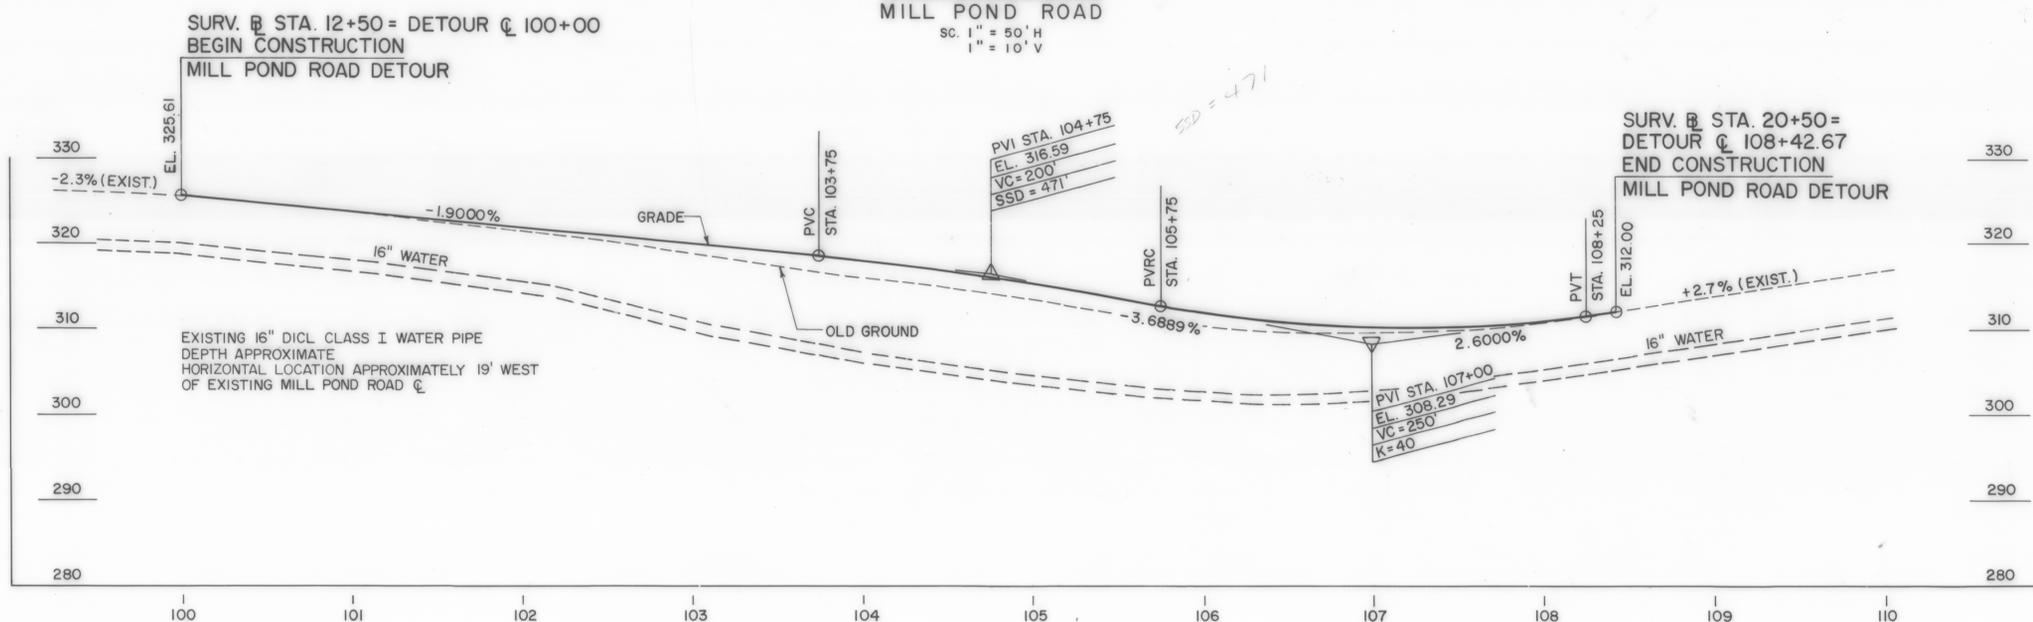

PROFILE
MILL POND ROAD DETOUR
SC. 1" = 50' H
1" = 10' V

R.O.W. PLAN
THIS SHEET TO BE USED
FOR R.O.W. INFORMATION
ONLY.

VT. SURVEY
CONSULTANTS DATE FEB 1988
SURVEYED BY BRYANT ASSO DATE FEB 1988
DRAWN BY DATE
TRACED BY DATE
WILLISTON-ESSEX-COLCHESTER
SECTION 3
PROJ. PB NO. 033-1(1)
SHEET 44 OF 57