


DATE	
BY	
SURVEYED	
ALIGNED	
NOTED	
STRUCTURE NOTATIONS CHECKED	
NO.	

DATE	
BY	
SURVEYED	
ALIGNED	
NOTED	
STRUCTURE NOTATIONS CHECKED	
NO.	

**R.O.W. PLAN**  
THIS SHEET TO BE USED  
FOR R.O.W. INFORMATION  
ONLY.

← PROFILE GRADE TRANSITION TO WB CL  
FOR STATION ELEVATIONS AT WB CL  
SEE "TABLES FOR PROFILE GRADE  
ELEVATIONS", SHT. NO. 33

STA.  
261+57.74

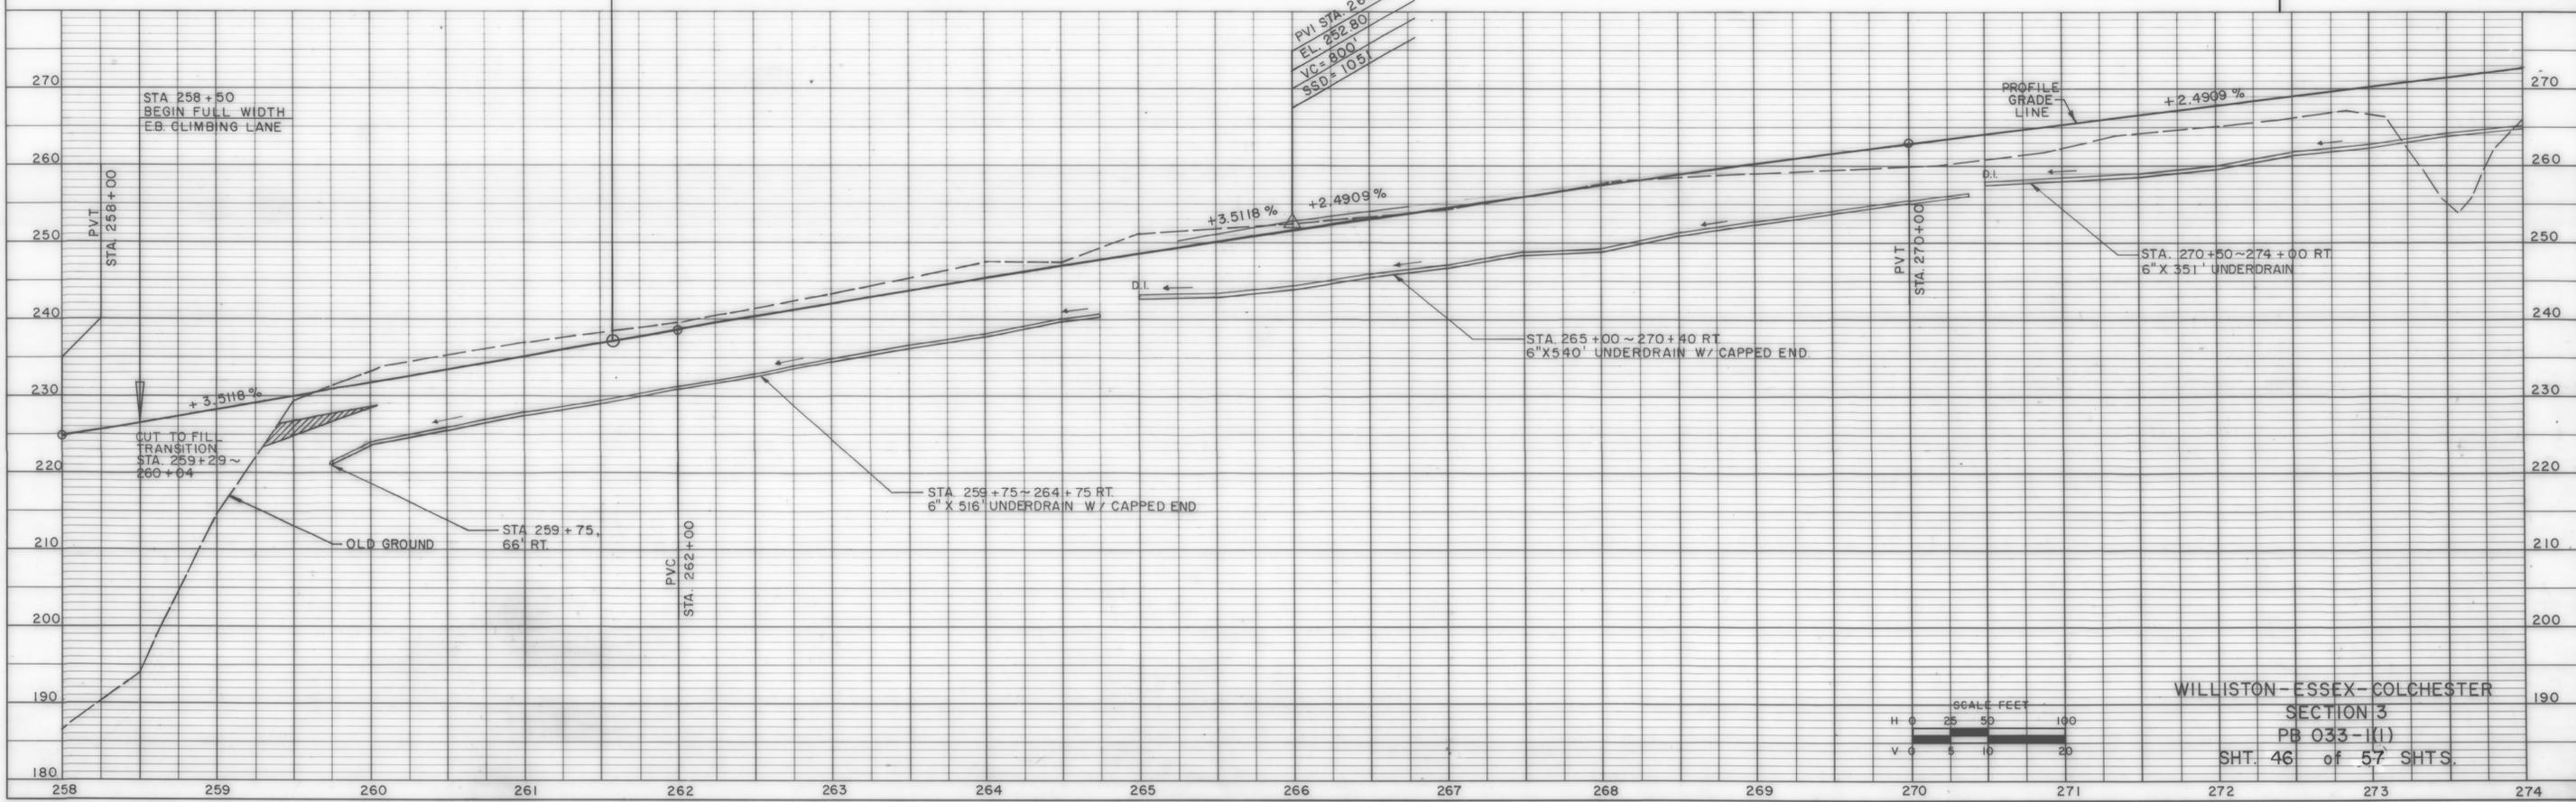

WILLISTON - ESSEX - COLCHESTER  
SECTION 3  
PR 033 - 1(1)  
SHT. 46 of 57 SHTS.