


DATE	
BY	
SURVEYED	
NOTED	
ALIGNED	
CHECKED	
RT. OF WAY CHECKED	
NO.	

DATE	
BY	
SURVEYED	
NOTED	
STRUCTURE NOTATIONS CHECKED	
NO.	

R.O.W. PLAN
 THIS SHEET TO BE USED
 FOR R.O.W. INFORMATION
 ONLY.

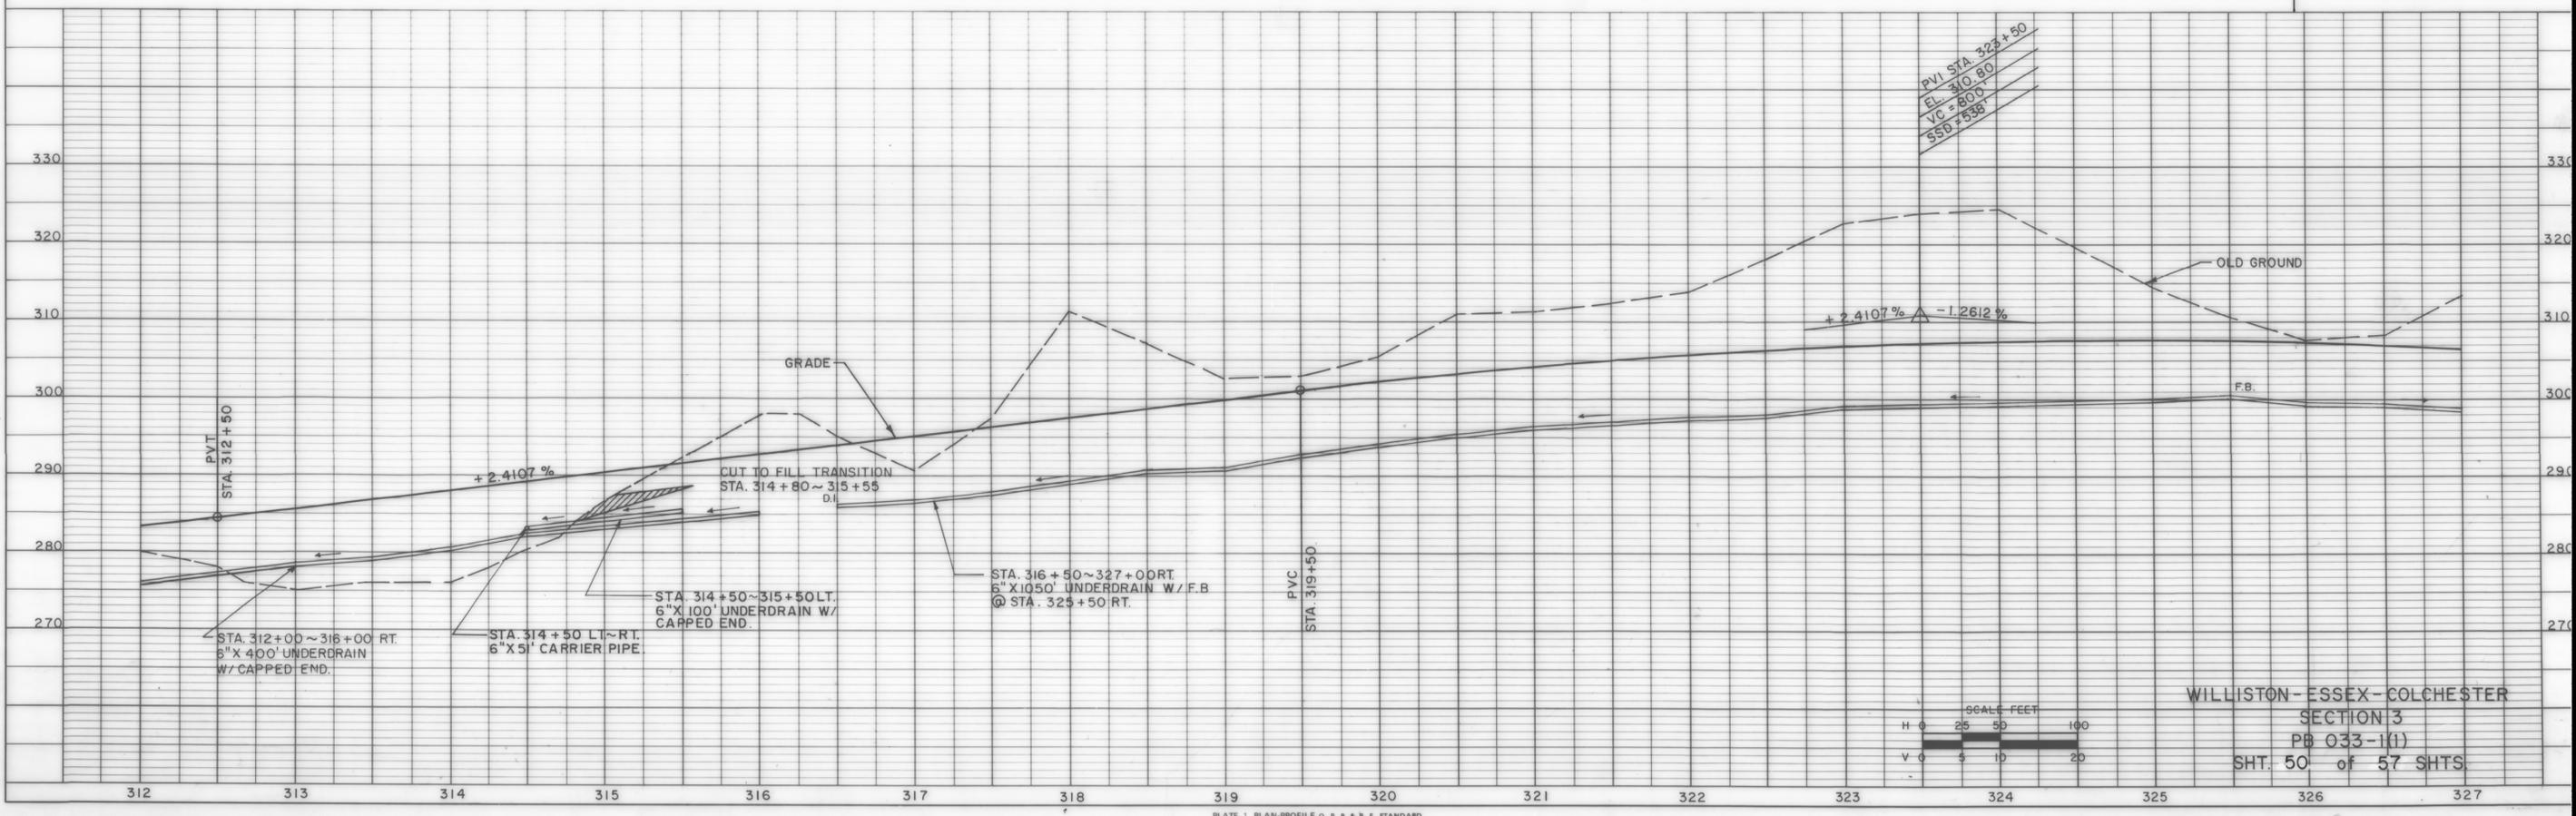

WILLISTON - ESSEX - COLCHESTER
 SECTION 3
 PB 033-1(1)
 SHT. 50 of 57 SHTS.

47