


PLAN	DATE	BY	SURVEYED	ALIGNED	CHECKED
NOTE BOOK					
No.					

PROFILE	DATE	BY	SURVEYED	ALIGNED	CHECKED
NOTE BOOK					
No.					

R.O.W. PLAN

THIS SHEET TO BE USED
FOR R.O.W. INFORMATION
ONLY.

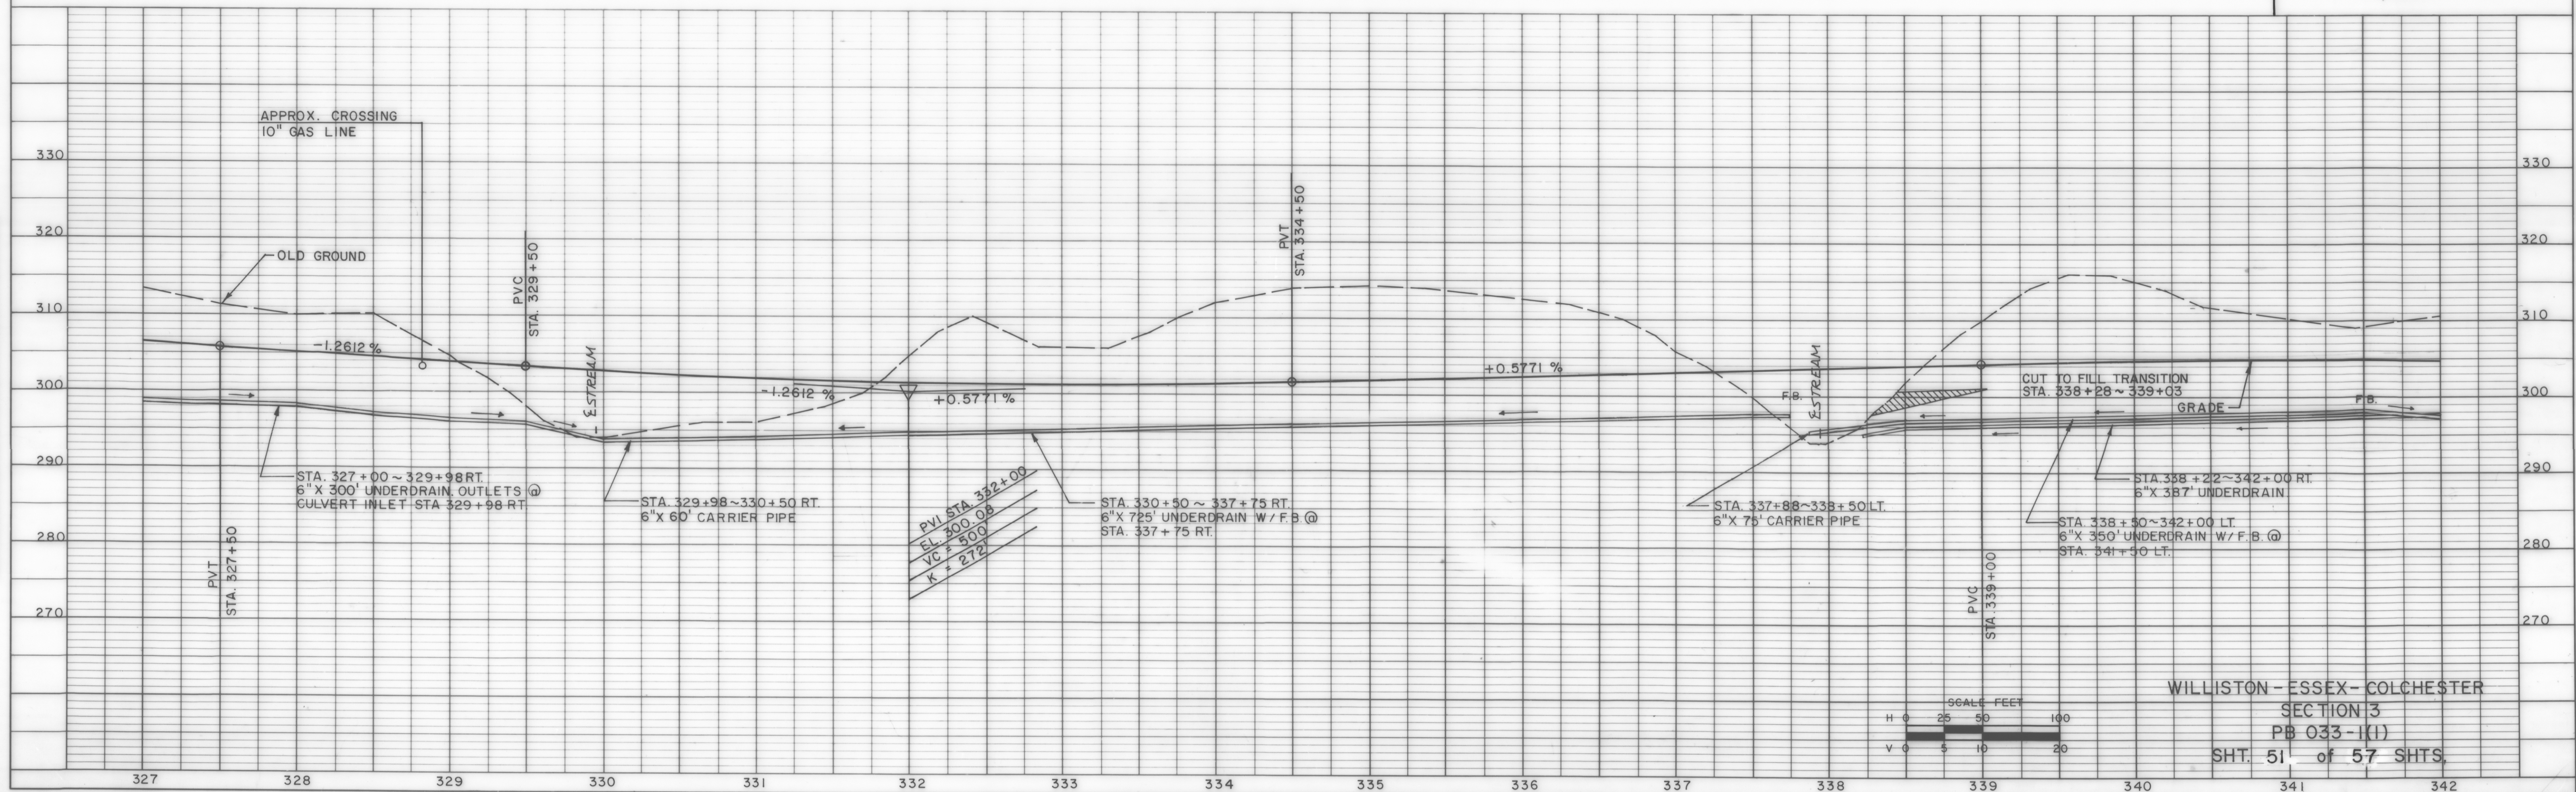

WILLISTON - ESSEX - COLCHESTER
SECTION 3
PB 033 - (11)
SHT. 51 of 57 SHTS.