


DATE	
BY	
SURVEYED	
PLOTTED	
NOTE BOOK	
NO.	

DATE	
BY	
SURVEYED	
PLOTTED	
NOTE BOOK	
NO.	

R.O.W. PLAN.
THIS SHEET TO BE USED
FOR R.O.W. INFORMATION
ONLY.

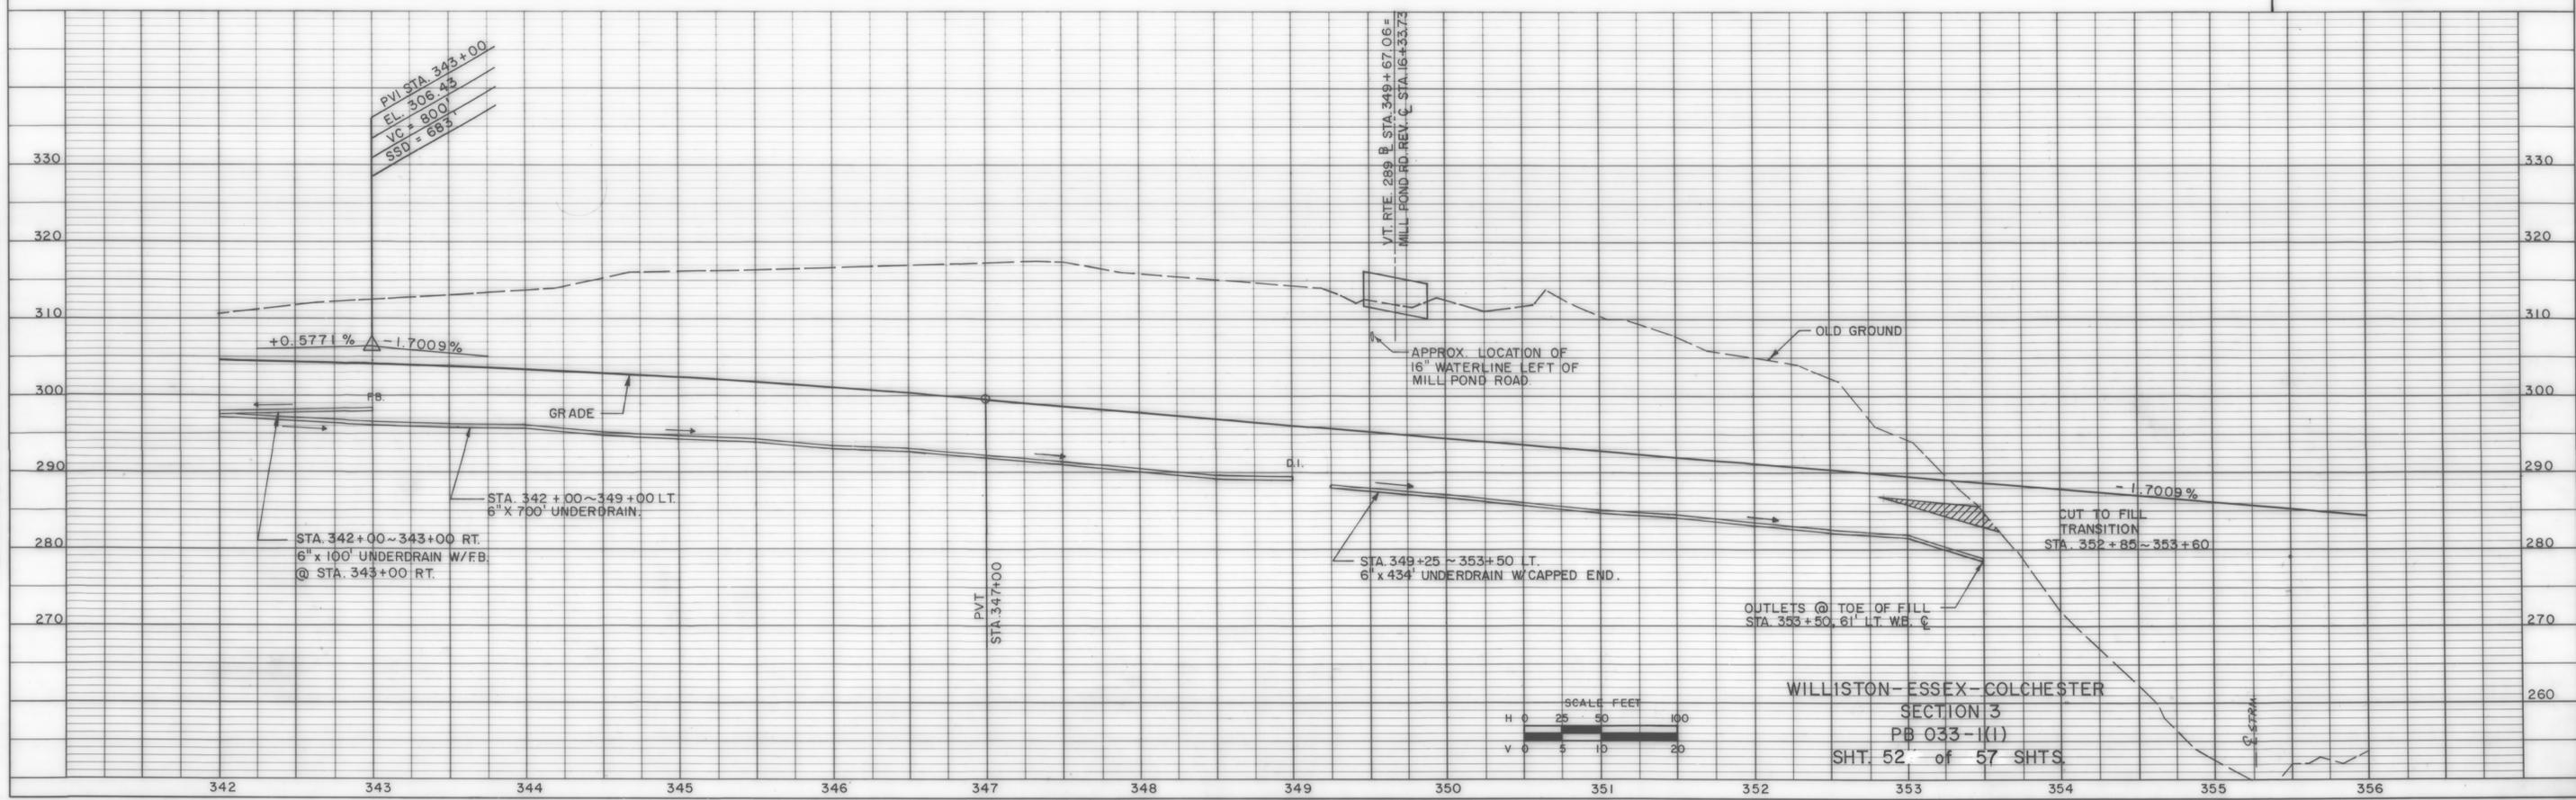

WILLISTON-ESSEX-COLCHESTER
SECTION 3
PB 033-1(1)
SHT. 52 of 57 SHTS.