


DATE	
BY	
REVISIONS	
NO.	
PLAN	
NOTE BOOK	
No.	

DATE	
BY	
REVISIONS	
NO.	
PROFILE	
NOTE BOOK	
No.	

R.O.W. PLAN
 THIS SHEET TO BE USED
 FOR R.O.W. INFORMATION
 ONLY.

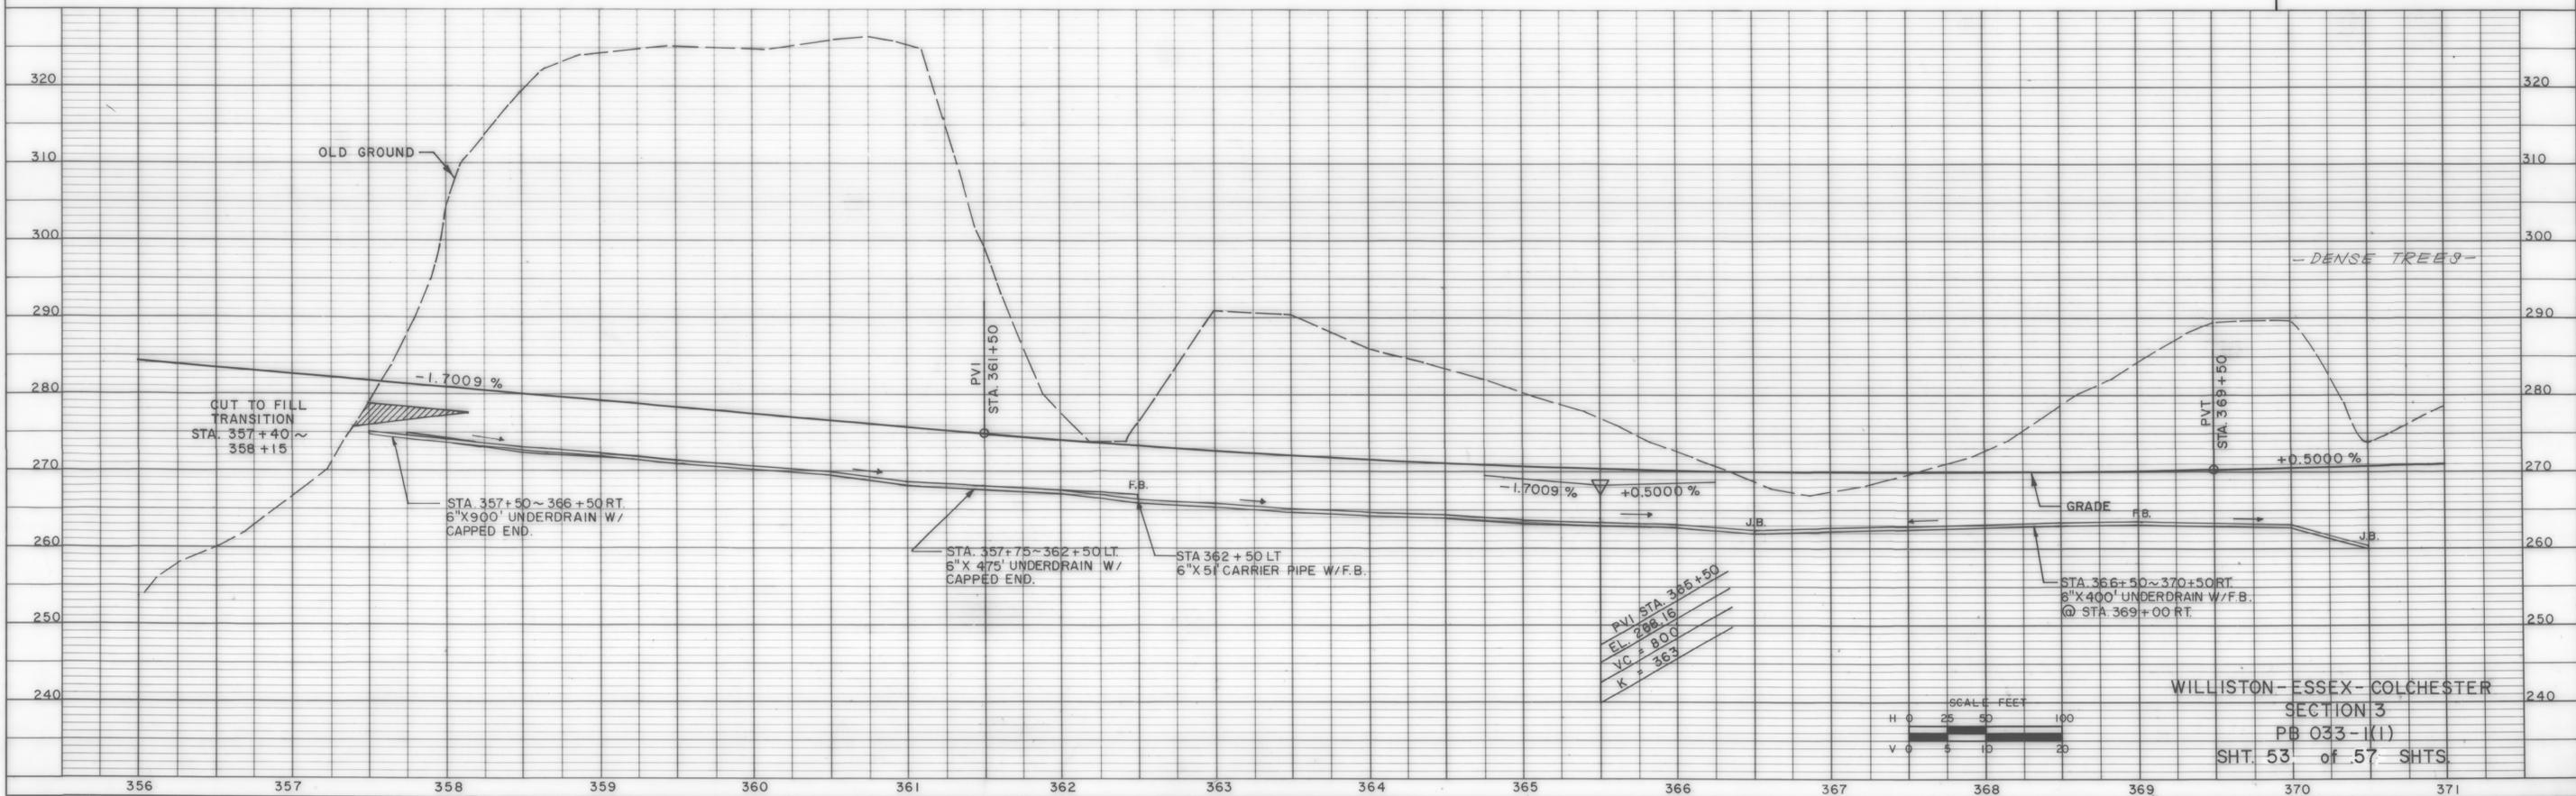

WILLISTON-ESSEX-COLCHESTER
 SECTION 3
 PB 033-1(1)
 SHT. 53 of 57 SHTS.