



# TYPICAL SECTIONS - SUSIE B. WILSON ROAD RELOCATION CHITTENDEN COUNTY CIRCUMFERENTIAL HIGHWAY

PAVEMENT:	6" BITUMINOUS CONCRETE PAVEMENT	ITEM NUMBERS	406.25
	1-1/4" TYPE III WEARING COURSE		
	1-3/4" TYPE II BINDER COURSE		
	3" TYPE I BASE COURSE		
SHOULDERS:	1-1/4" TYPE III WEARING COURSE		
	24" SUBBASE OF DENSE GRADED CRUSHED STONE	301.35	
	10" SAND BORROW	203.31	
	4'-0" SHATTERED ROCK (IN ROCK CUT)		

NOTE: ALL FROST SUSCEPTIBLE MATERIAL WITHIN 54" (DESIGN FROST DEPTH) OF FINISH GRADE SHALL BE REMOVED AND REPLACED AS SHOWN

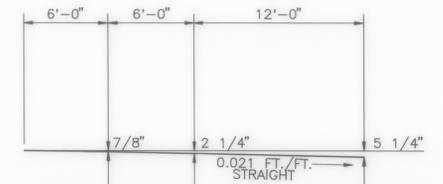

**MODIFIED PARABOLIC DETAIL**

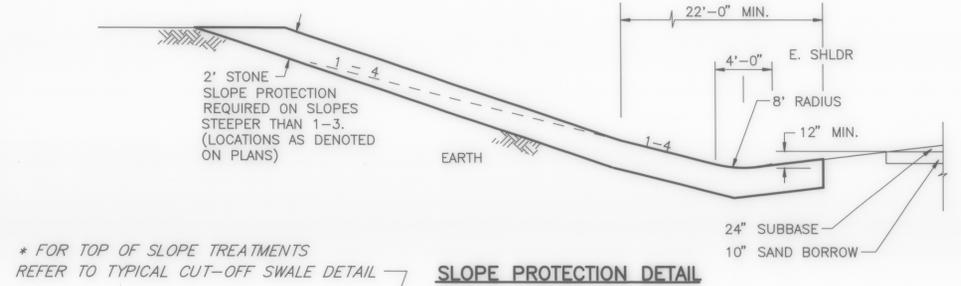


**SLOPE PROTECTION DETAIL**


\* FOR TOP OF SLOPE TREATMENTS REFER TO TYPICAL CUT-OFF SWALE DETAIL

\* ROCK SLOPES AS NOTED ON THE PLANS OR AS ORDERED BY THE ENGINEER (REFER TO STANDARD SHEET A-62).

\*\* FULL DEPTH 6" PAVEMENT WILL BE PLACED IN THE SHOULDER AREAS FROM STA. 26+00 BACK.

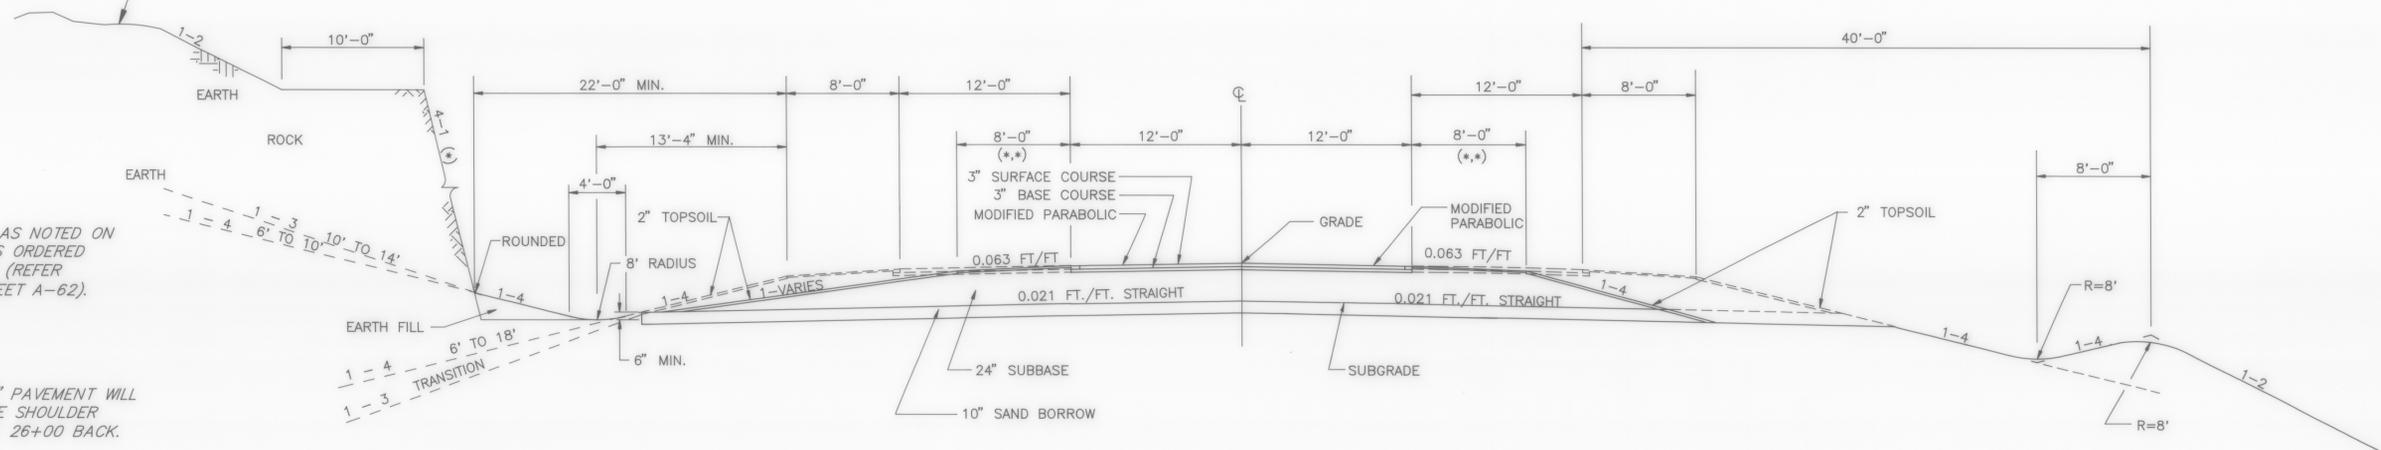

**NORMAL SECTION**

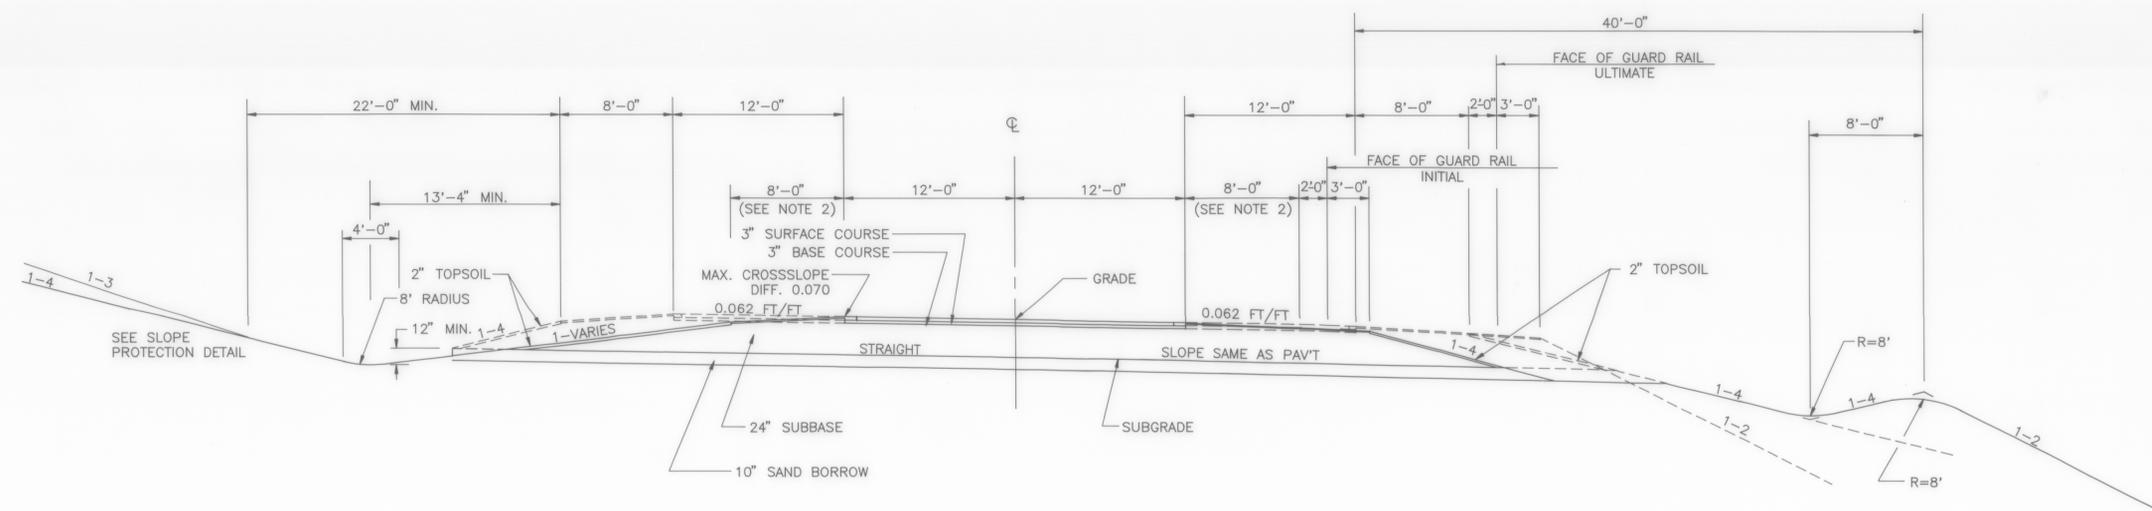

**MAXIMUM BANKED RIGHT SECTION (BANKED LEFT OPPOSITE HAND)**

e=0.061 FT./FT.

NOTES: 1.) ENHANCED EMBANKMENT TO BE USED WHERE GUARDRAIL CAN BE ELIMINATED.  
2.) CONSTRUCT FULL DEPTH ASPHALT SHOULDER THROUGH STA. 26+00.

DATUM	
VERTICAL	N.G.V.D. 1929
HORIZONTAL	N.A.D. 1927

SURVEYED BY V.S. INC./C.H.A. DATE 1988-90  
 DRAWN BY T. KARIS DATE 2/89  
 TRACED BY J. LUKOVITS DATE 2/89  
 VERMONT ROUTE 289 (F.A.P.)  
 TOWN OF ESSEX  
 PROJ. WILLISTON- COLCHESTER NO. PB 033-1(1)  
 SHEET 10 OF 61