


CAST-IN-PLACE CONCRETE CURB - TYPE B		
SWR STA 9+98 LT - SWR STA 14+93 LT		495 LF
SWR STA 14+93 LT - SWR STA 15+39 LT		96 LF
SWR STA 15+39 LT - SWR STA 16+28 LT		61 LF
SWR STA 16+28 LT - SWR STA 17+50 LT		122 LF
SWR STA 9+98 RT - SWR STA 11+03 RT		105 LF
SWR STA 11+03 RT - SWR STA 13+03 RT		180 LF
SWR STA 13+03 RT - SWR STA 14+30 RT		129 LF
SWR STA 14+30 RT - SWR STA 15+02 RT		72 LF
SWR STA 15+02 RT - SWR STA 15+52 RT		79 LF
SWR STA 15+52 RT - SWR STA 16+34 RT		91 LF
SWR STA 16+34 RT - SWR STA 17+50 RT		116 LF

CONSTRUCT DRIVE  
S.W. RD. 12+84 LT

BEGIN RELINQUISHMENT No. I  
SUZIE WILSON RD. STA. 11+00, 32' LT.

END RELINQUISHMENT No. I  
SUZIE WILSON RD. STA. 15+26, 25' LT.

BEGIN RELINQUISHMENT No. II  
SUZIE WILSON RD. STA. 15+96, 50' LT.

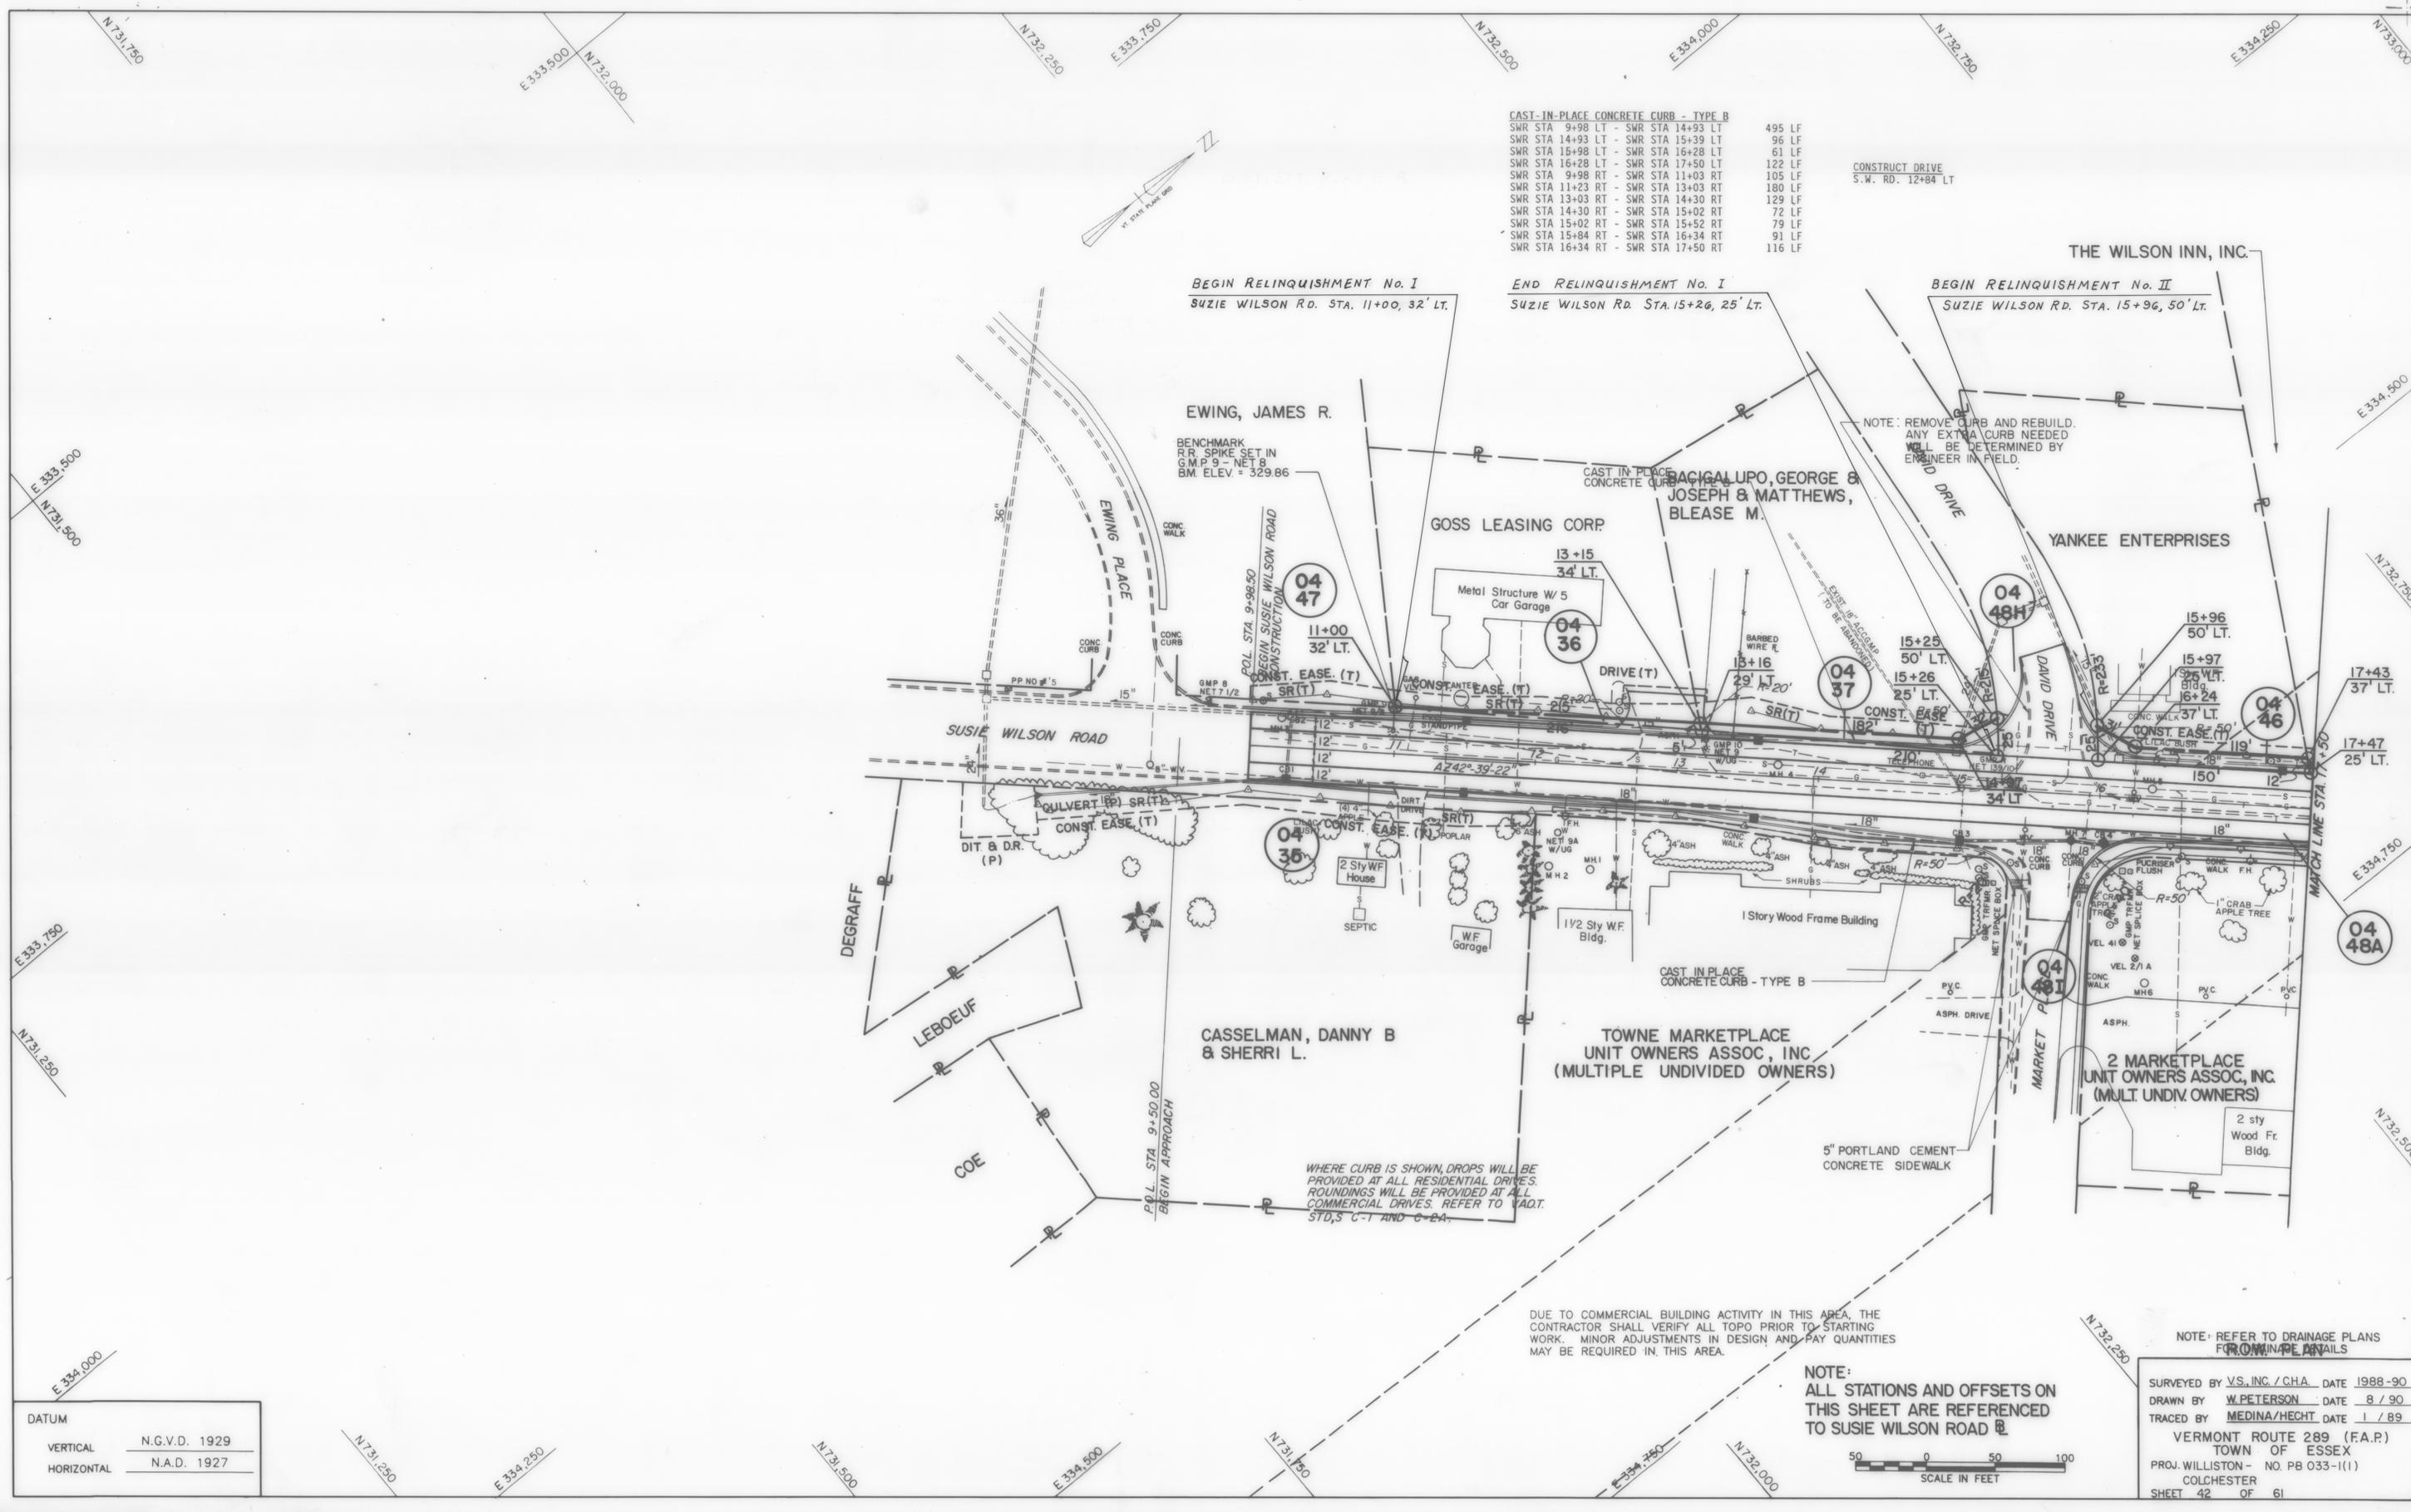

EWING, JAMES R.

BACIGALUPO, GEORGE &  
JOSEPH & MATTHEWS,  
BLEASE M.

THE WILSON INN, INC.

GOSS LEASING CORP.

YANKEE ENTERPRISES

CASSELMAN, DANNY B  
& SHERRI L.

TOWNE MARKETPLACE  
UNIT OWNERS ASSOC, INC  
(MULTIPLE UNDIVIDED OWNERS)

2 MARKETPLACE  
UNIT OWNERS ASSOC, INC  
(MULT. UNDIV. OWNERS)

WHERE CURB IS SHOWN, DROPS WILL BE  
PROVIDED AT ALL RESIDENTIAL DRIVES.  
ROUNDINGS WILL BE PROVIDED AT ALL  
COMMERCIAL DRIVES. REFER TO VADT.  
STD. S, C-1 AND G-2A.

DUE TO COMMERCIAL BUILDING ACTIVITY IN THIS AREA, THE  
CONTRACTOR SHALL VERIFY ALL TOPO PRIOR TO STARTING  
WORK. MINOR ADJUSTMENTS IN DESIGN AND PAY QUANTITIES  
MAY BE REQUIRED IN THIS AREA.

NOTE:  
ALL STATIONS AND OFFSETS ON  
THIS SHEET ARE REFERENCED  
TO SUZIE WILSON ROAD

NOTE: REFER TO DRAINAGE PLANS  
FOR DRAINAGE DETAILS

DATUM	
VERTICAL	N.G.V.D. 1929
HORIZONTAL	N.A.D. 1927



SURVEYED BY V.S., INC. / C.H.A. DATE 1988-90  
DRAWN BY W. PETERSON DATE 8 / 90  
TRACED BY MEDINA/HECHT DATE 1 / 89  
VERMONT ROUTE 289 (FA.P)  
TOWN OF ESSEX  
PROJ. WILLISTON - NO. PB 033-1(1)  
COLCHESTER  
SHEET 42 OF 61