

KELLOGG RD. CURVE DATA #2
 $\Delta = 30^{\circ}-08'-03''$ LT.
 $D_c = 11^{\circ}-27'$ LT.
 $R = 500.00'$
 $T = 134.60'$
 $E = 17.80'$
 $L = 262.97'$

KELLOGG RD. CURVE DATA #1
 $\Delta = 15^{\circ}-16'-47''$ LT.
 $D_c = 750.00'$
 $R = 100.60'$
 $T = 6.72'$
 $L = 200.01'$

SUSIE WILSON RD. CURVE DATA #1
 $\Delta = 45^{\circ}-52'-40''$ LT.
 $D_c = 07^{\circ}-38'-22''$
 $R = 750.00'$
 $T = 317.41'$
 $E = 64.43'$
 $L = 600.54'$
 BANK = 0.021 FT./FT.

KELLOGG RD. CURVE DATA #3
 $\Delta = 31^{\circ}-15'-57''$ LT.
 $D_c = 38^{\circ}-11'-50''$
 $R = 150.00'$
 $T = 41.97'$
 $E = 5.76'$
 $L = 81.85'$

GRANITE SLOPE EDGING
 KELLOGG RD "A" STA 103+50 LT ISLAND 238 LF
 KELLOGG RD "A" STA 104+90 RT ISLAND 79 LF

CAST-IN-PLACE CONCRETE CURB TYPE B:
 SWR STA 17+50 LT - SWR STA 19+76 LT 226 LF
 SWR STA 20+31 LT - SWR STA 21+12 LT 175 LF
 SWR STA 21+57 LT - KELLOGG "B" STA 52+89 LT 161 LF
 SWR STA 17+50 RT - SWR STA 17+73 RT 23 LF
 SWR STA 17+93 RT - SWR STA 18+93 RT 100 LF
 SWR STA 19+46 RT - SWR STA 20+97 RT 151 LF
 SWR STA 21+16 RT - SWR STA 21+83 RT 71 LF
 SWR STA 22+16 RT - KELLOGG "A" STA 105+31 RT 161 LF

4' HIGH MOVEN WIRE FENCE
 SWR STA 26+08, 173' LT - SWR STA 27+25, 73' LT
 SWR STA 27+25, 73' LT - SWR STA 30+00, 96' RT
 SWR STA 29+35, 140' RT - SWR STA 30+00, 140' RT

4' HIGH CHAIN LINK FENCE
 SWR STA 26+00, 204 RT - SWR STA 26+98, 80' RT
 SWR STA 26+98, 80' RT - SWR STA 28+75, 80' RT
 SWR STA 28+75, 80' RT - SWR STA 29+35, 140' RT
 SWR STA 25+30, 65' LT - SWR STA 26+08, 173' LT


REMOVAL OF EXISTING FENCE
 SWR STA 25+95, LT - SWR 26+28, LT

NOTE: FOR CURB TIES AND SUPPLEMENTAL PAVEMENT LAYOUT DATA IN THE SUSIE WILSON ROAD - KELLOGG ROAD AREA SEE GRADING PLANS.

NOTE: REFER TO DRAINAGE PLANS FOR DRAINAGE DETAILS

DUE TO COMMERCIAL BUILDING ACTIVITY IN THIS AREA, THE CONTRACTOR SHALL VERIFY ALL TOPO PRIOR TO STARTING WORK. MINOR ADJUSTMENTS IN DESIGN AND PAY QUANTITIES MAY BE REQUIRED IN THIS AREA.

DATUM	
VERTICAL	N.G.V.D. 1929
HORIZONTAL	N.A.D. 1927

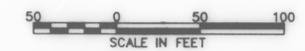

SURVEYED BY V.S. INC./CHA. DATE 1988-90
 DRAWN BY W. PETERSON DATE 8 / 90
 TRACED BY MEDINA/HECHT DATE 1 / 89
 VERMONT ROUTE 289 (F.A.P.)
 TOWN OF ESSEX
 PROJ. WILLISTON - NO. PB 033-1(1)
 COLCHESTER
 SHEET 43 OF 61