
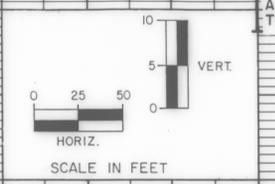


PLAN SURVEYED BY DATE
 NOTE BOOK NO. ALIGNMENT CHECKED
 RT. OF WAY CHECKED

PROFILE SURVEYED BY DATE
 NOTE BOOK NO. PLOTTED CHECKED
 STRUCTURE NOTATIONS CHECKED

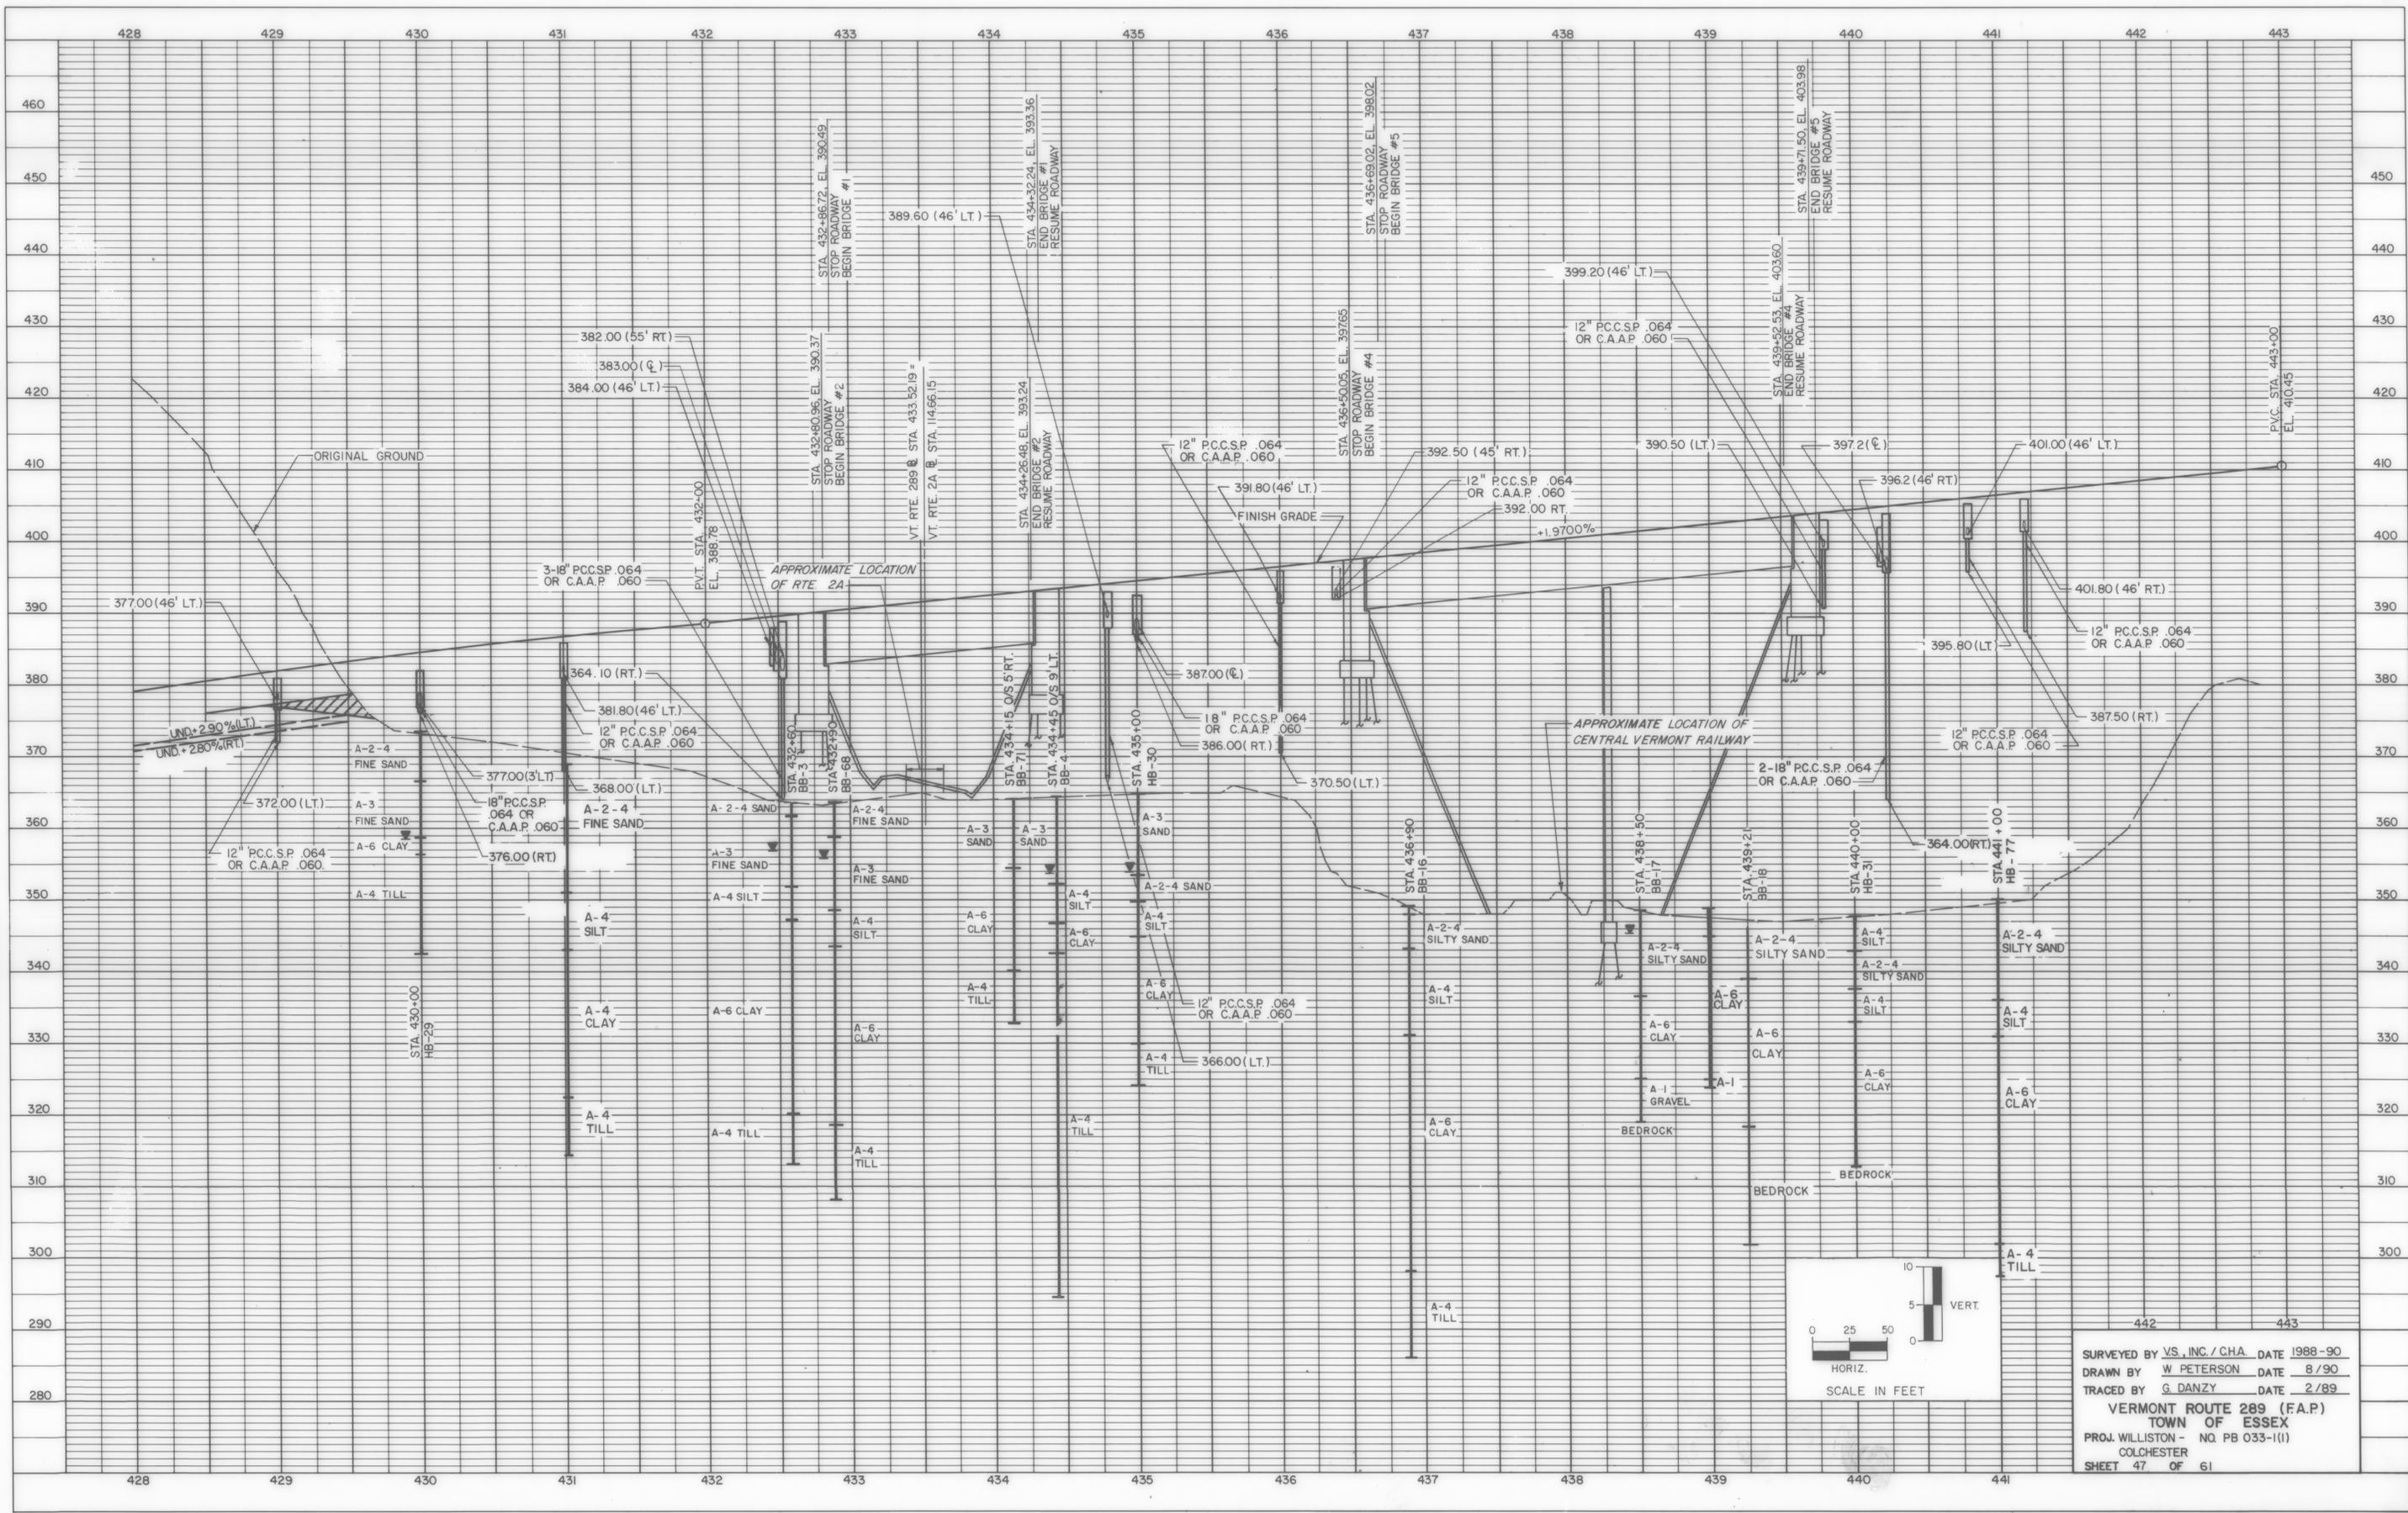

SURVEYED BY VS, INC. / CHA DATE 1988-90
 DRAWN BY W. PETERSON DATE 8/90
 TRACED BY G. DANZY DATE 2/89
VERMONT ROUTE 289 (F.A.P.)
TOWN OF ESSEX
 PROJ. WILLISTON - NO. PB 033-1(1)
 COLCHESTER
 SHEET 47 OF 61