
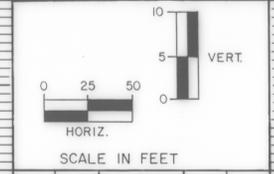


PLAN  
 SURVEYED \_\_\_\_\_  
 NOTE BOOK \_\_\_\_\_  
 ALIGNMENT CHECKED \_\_\_\_\_  
 RT. OF WAY CHECKED \_\_\_\_\_  
 NO. \_\_\_\_\_

PROFILE  
 SURVEYED \_\_\_\_\_  
 PLOTTED CHECKED \_\_\_\_\_  
 NOTE BOOK \_\_\_\_\_  
 STRUCTURE NOTATIONS CHKD \_\_\_\_\_  
 NO. \_\_\_\_\_

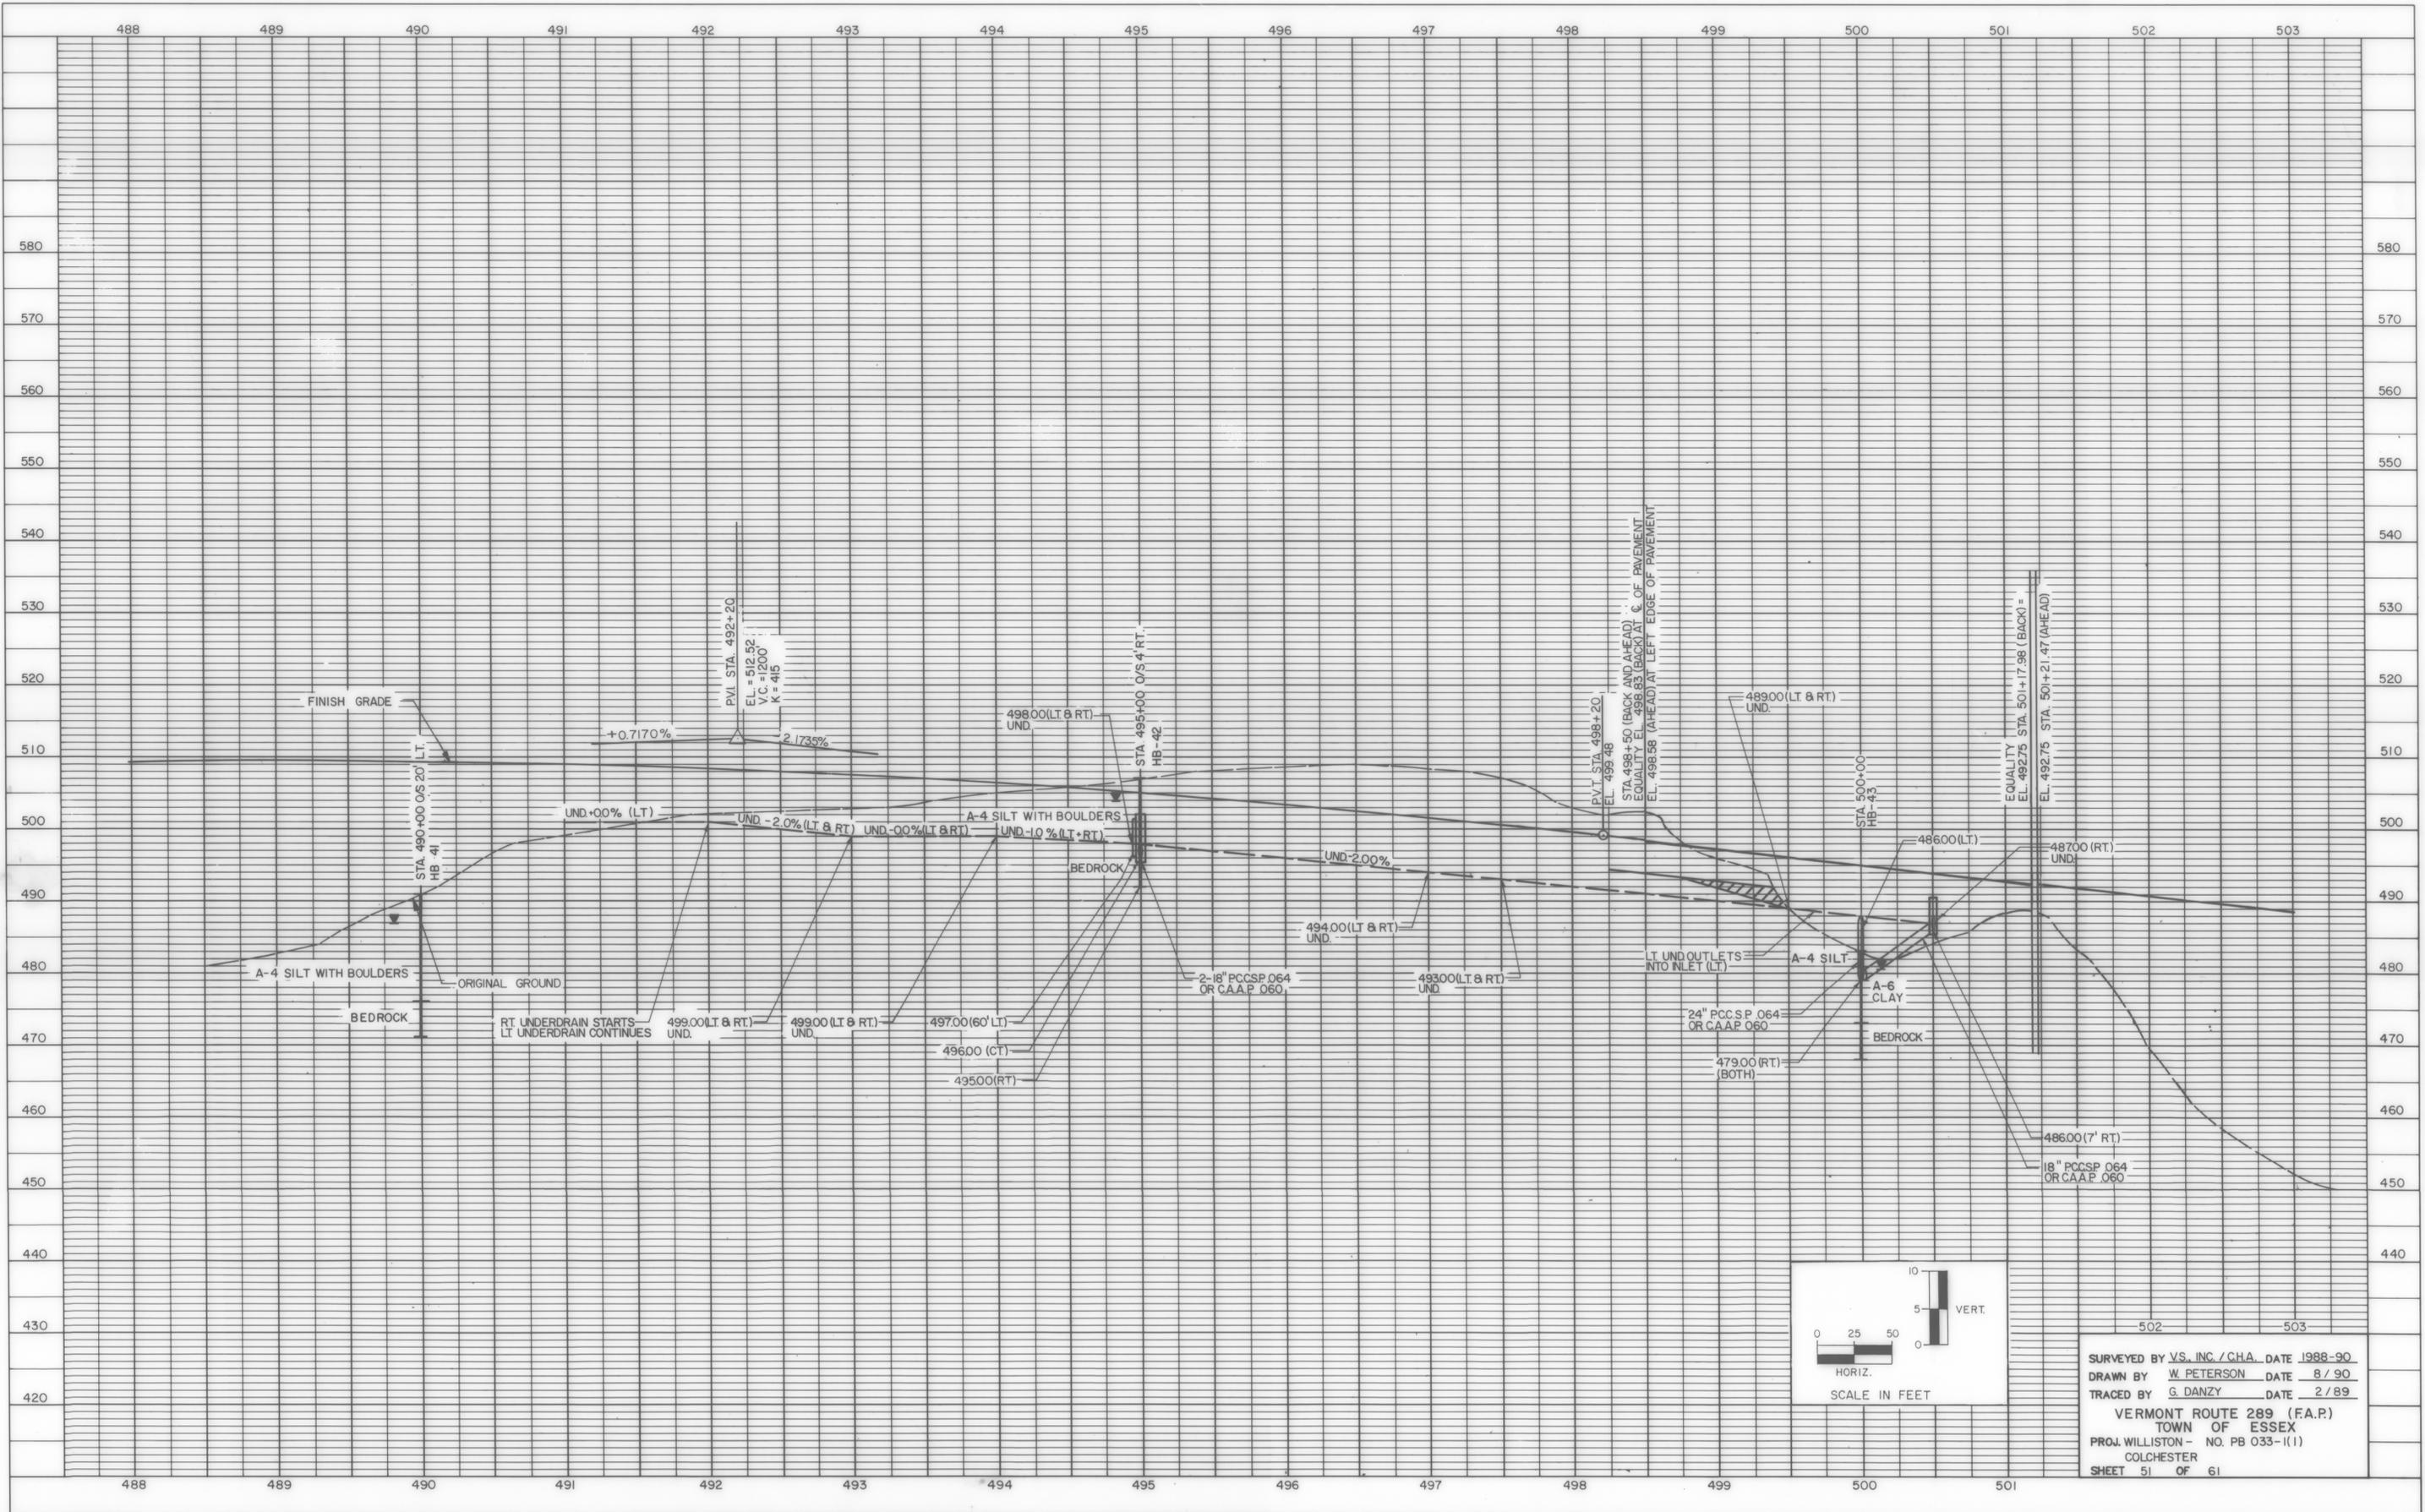

SURVEYED BY VS. INC. / CHA. DATE 1988-90  
 DRAWN BY W. PETERSON DATE 8 / 90  
 TRACED BY G. DANZY DATE 2 / 89  
 VERMONT ROUTE 289 (F.A.P.)  
 TOWN OF ESSEX  
 PROJ. WILLISTON - NO. PB 033-1(1)  
 COLCHESTER  
 SHEET 51 OF 61