

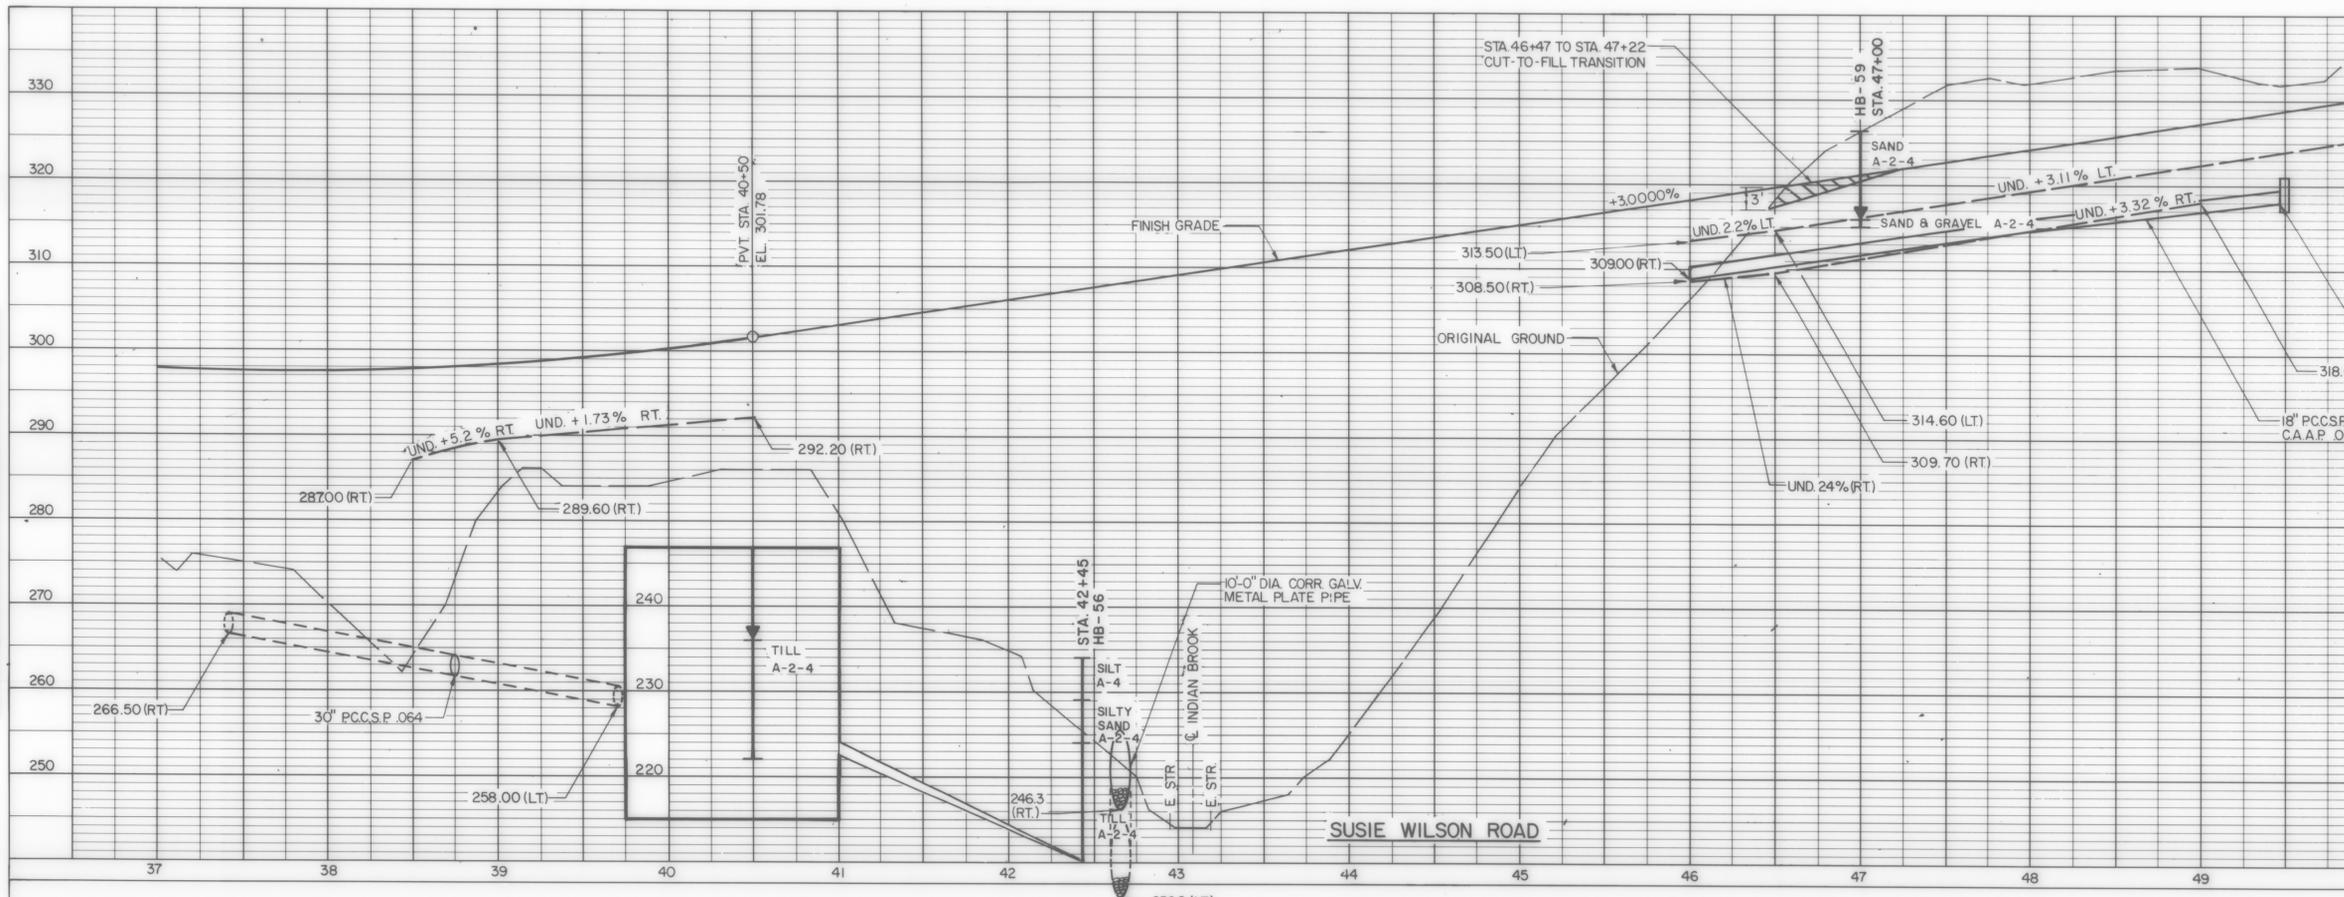


DATE: _____
 BY: _____
 SURVEYED: _____
 PLOTTED: _____
 CHECKED: _____
 NOTE BOOK NO. _____
 RT. OF WAY CHECKED: _____
 NO. _____

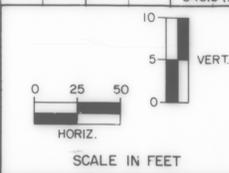

DATE: _____
 BY: _____
 SURVEYED: _____
 PLOTTED: _____
 CHECKED: _____
 NOTE BOOK NO. _____
 STRUCTURE NOTATION: CHPD
 NO. _____

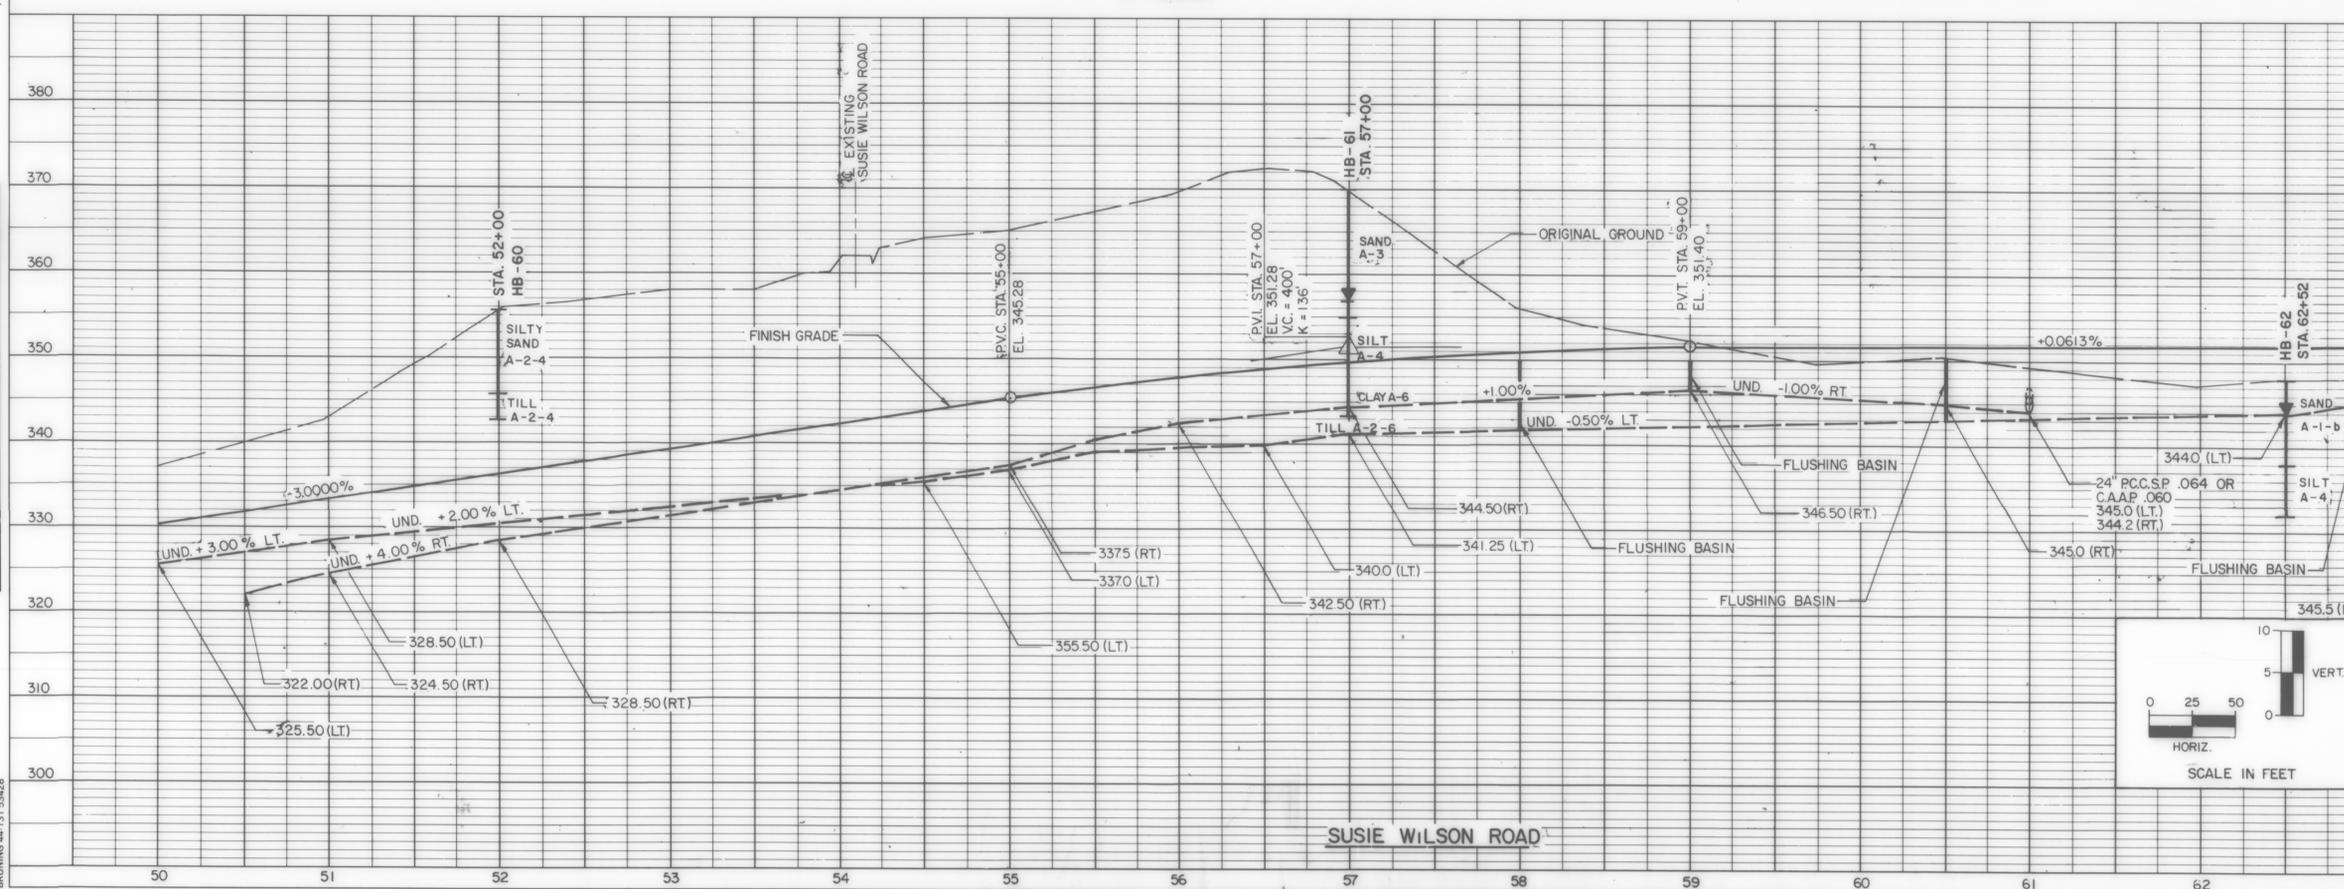

BRUNING 44-131-53428