

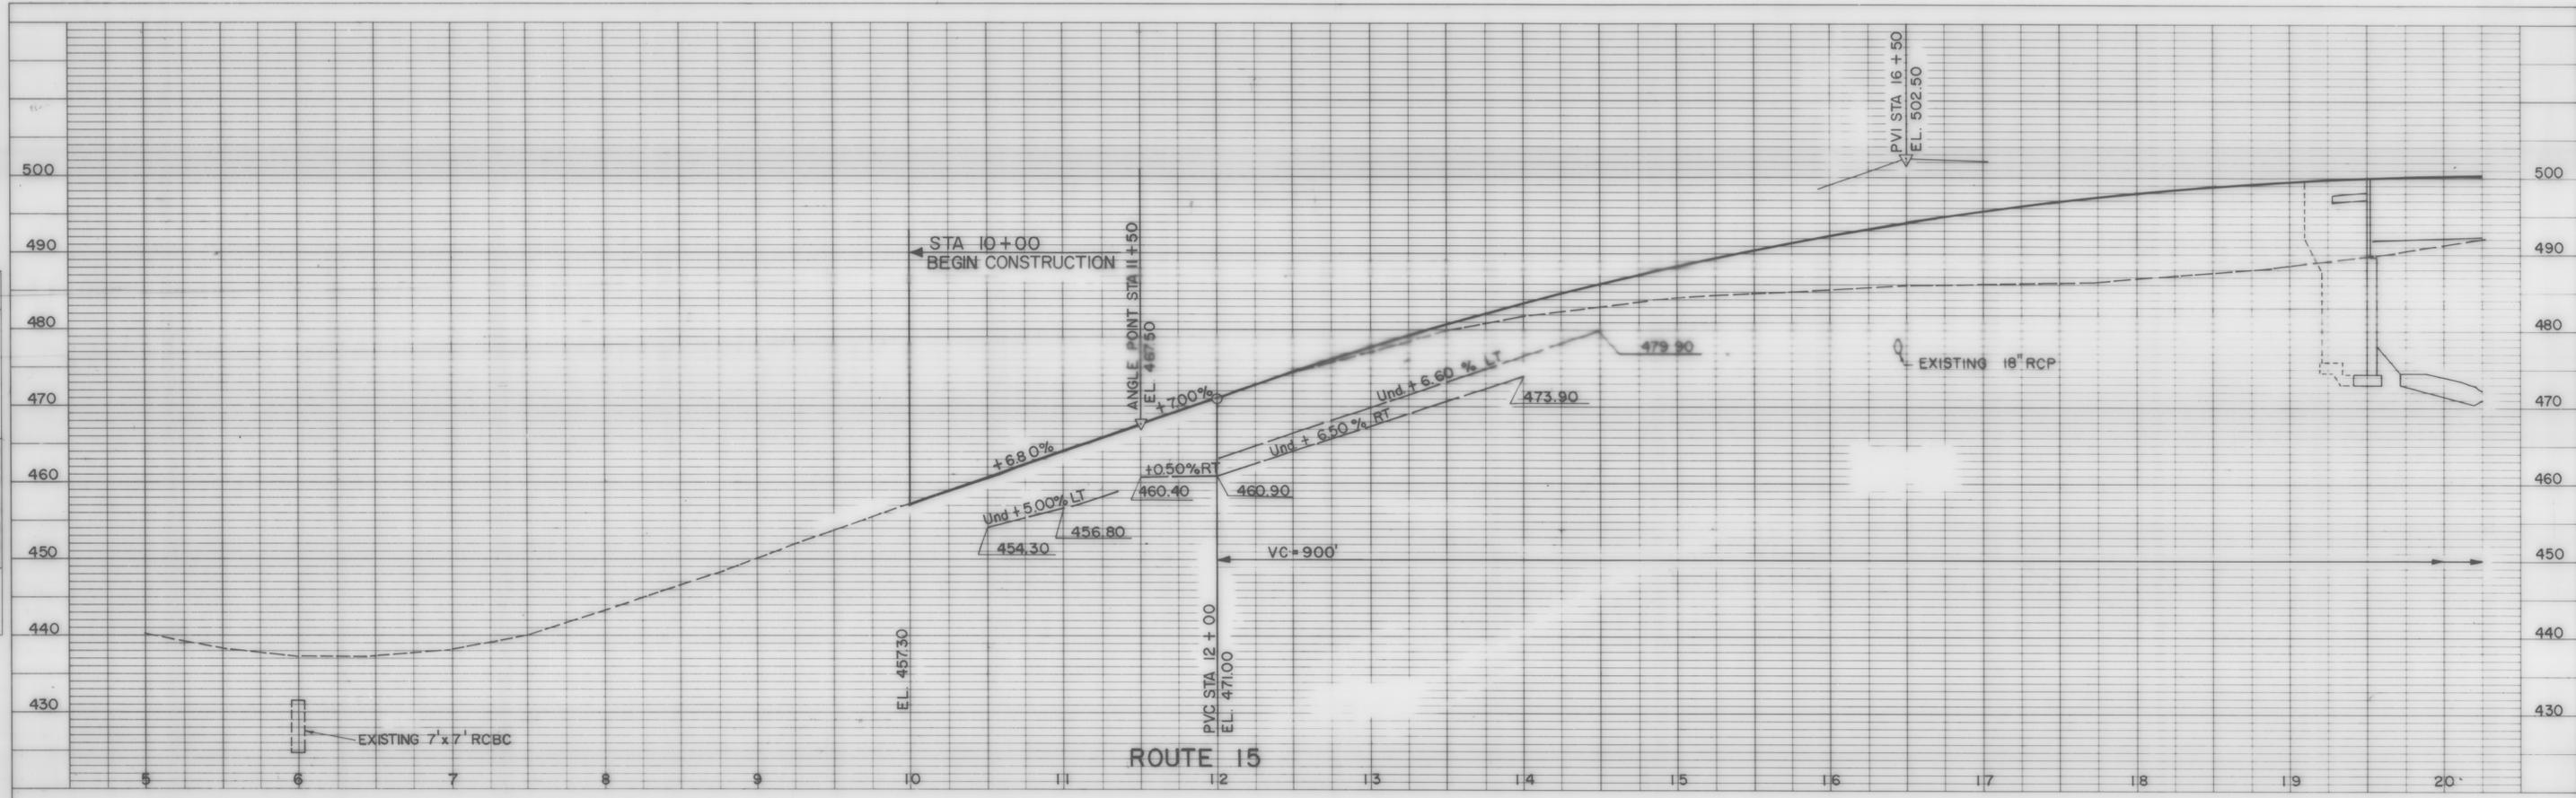


PROFILE SURVEYED BY DATE  
 NOTE BOOK GRADES CHECKED  
 B.M. # NOTED  
 STRUCTURE NOTATIONS CH'D

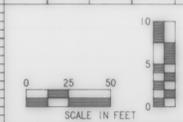

PROFILE SURVEYED BY DATE  
 NOTE BOOK GRADES CHECKED  
 B.M. # NOTED  
 STRUCTURE NOTATIONS CH'D

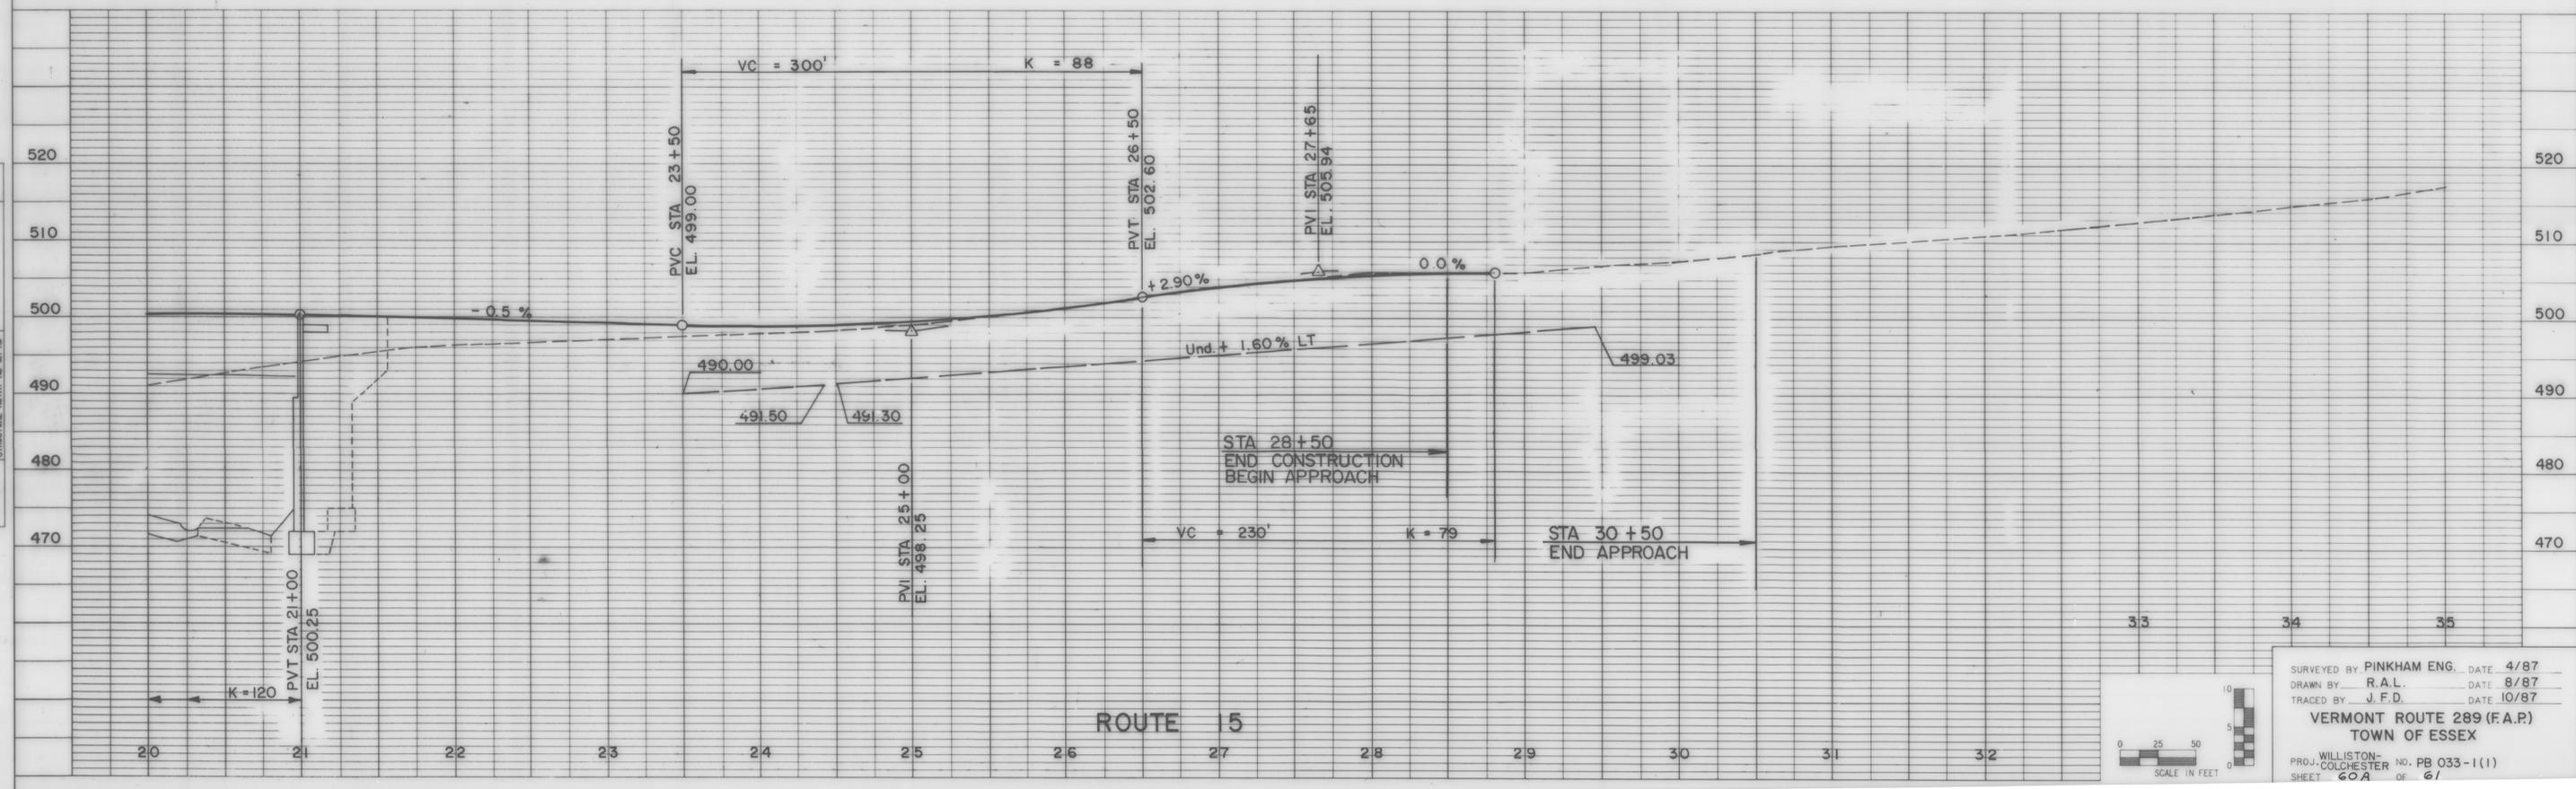

SURVEYED BY PINKHAM ENG. DATE 4/87  
 DRAWN BY R.A.L. DATE 8/87  
 TRACED BY J.F.D. DATE 10/87  
 VERMONT ROUTE 289 (F.A.P.)  
 TOWN OF ESSEX  
 PROJ. WILLISTON- COLCHESTER NO. PB 033-1(1)  
 SHEET 60A OF 61