



PROFILE  
 SURVEYED BY \_\_\_\_\_ DATE \_\_\_\_\_  
 PLOTTED BY \_\_\_\_\_  
 NOTE BOOK NO. \_\_\_\_\_  
 GRADES CHECKED BY \_\_\_\_\_  
 S.M. \* NOTED  
 STRUCTURE NO. / TYPE / CH / RD

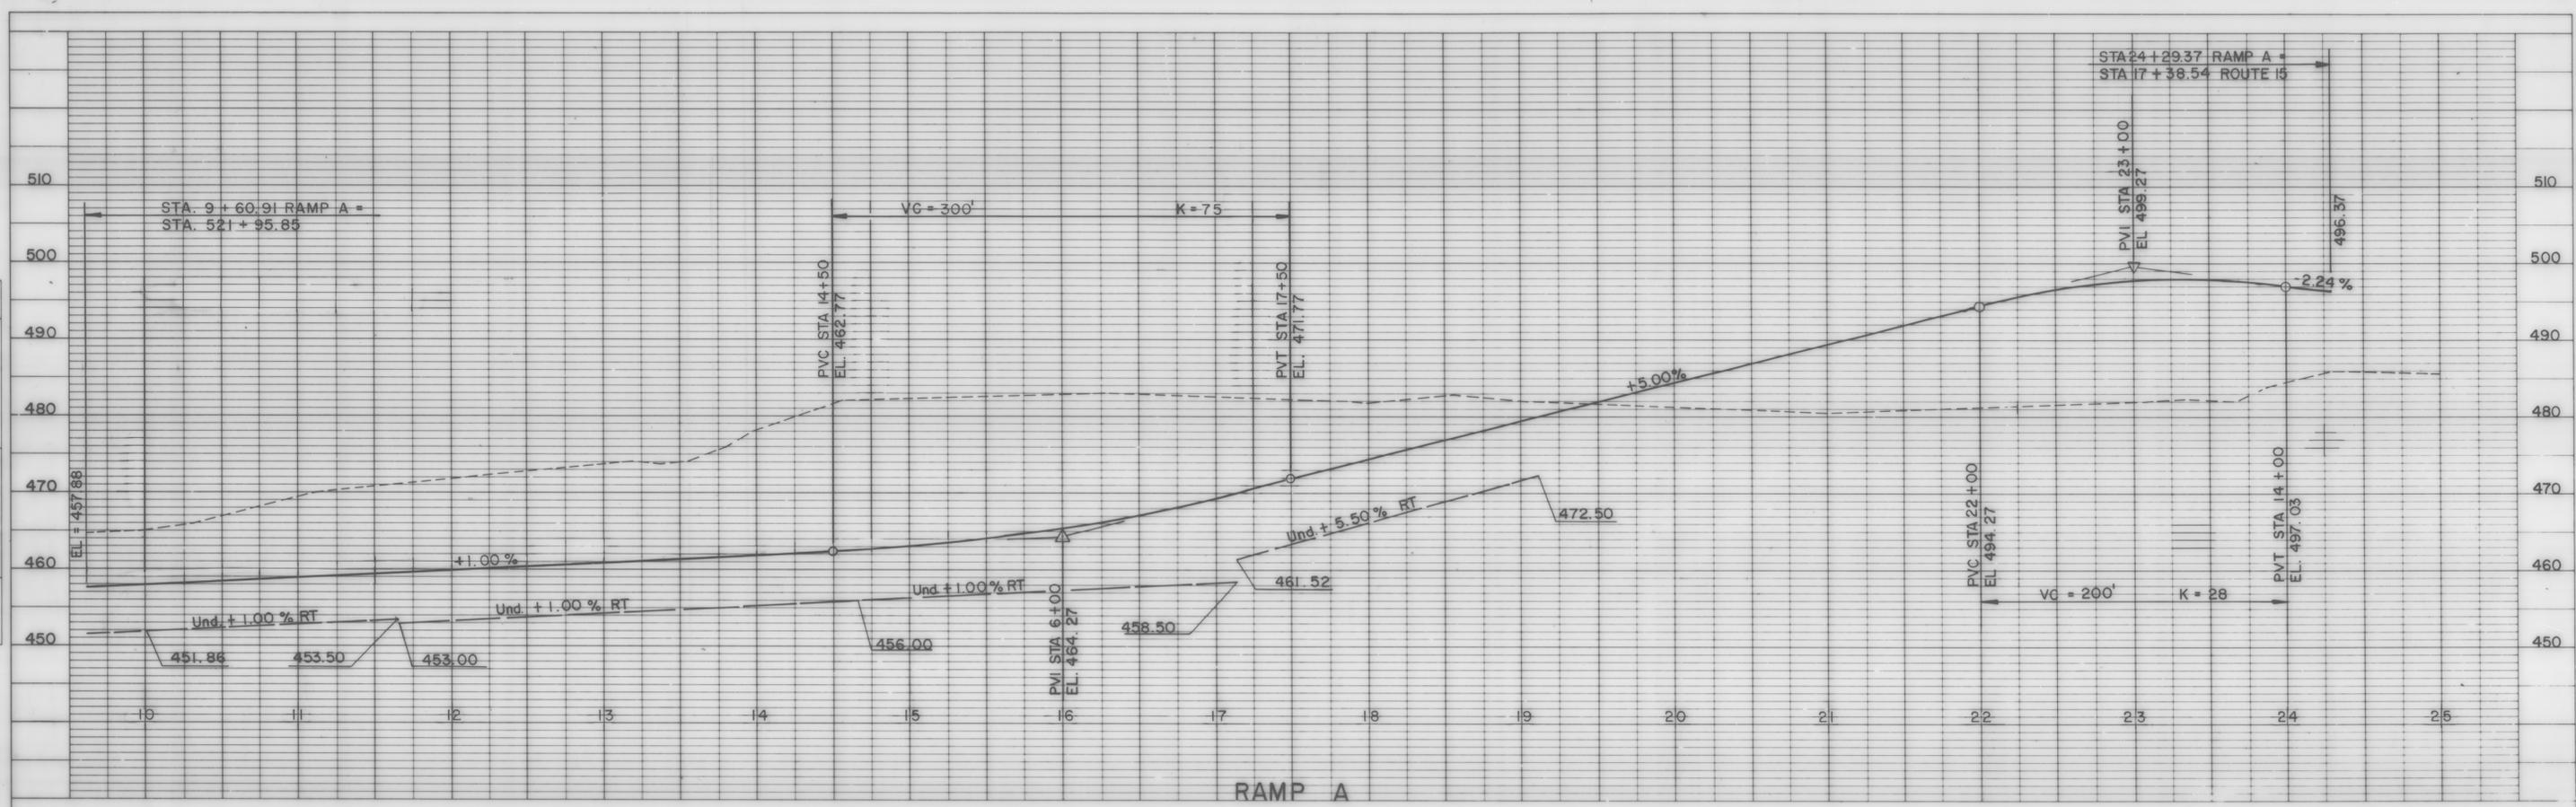

PROFILE  
 SURVEYED BY \_\_\_\_\_ DATE \_\_\_\_\_  
 PLOTTED BY \_\_\_\_\_  
 NOTE BOOK NO. \_\_\_\_\_  
 GRADES CHECKED BY \_\_\_\_\_  
 S.M. \* NOTED  
 STRUCTURE NO. / TYPE / CH / RD

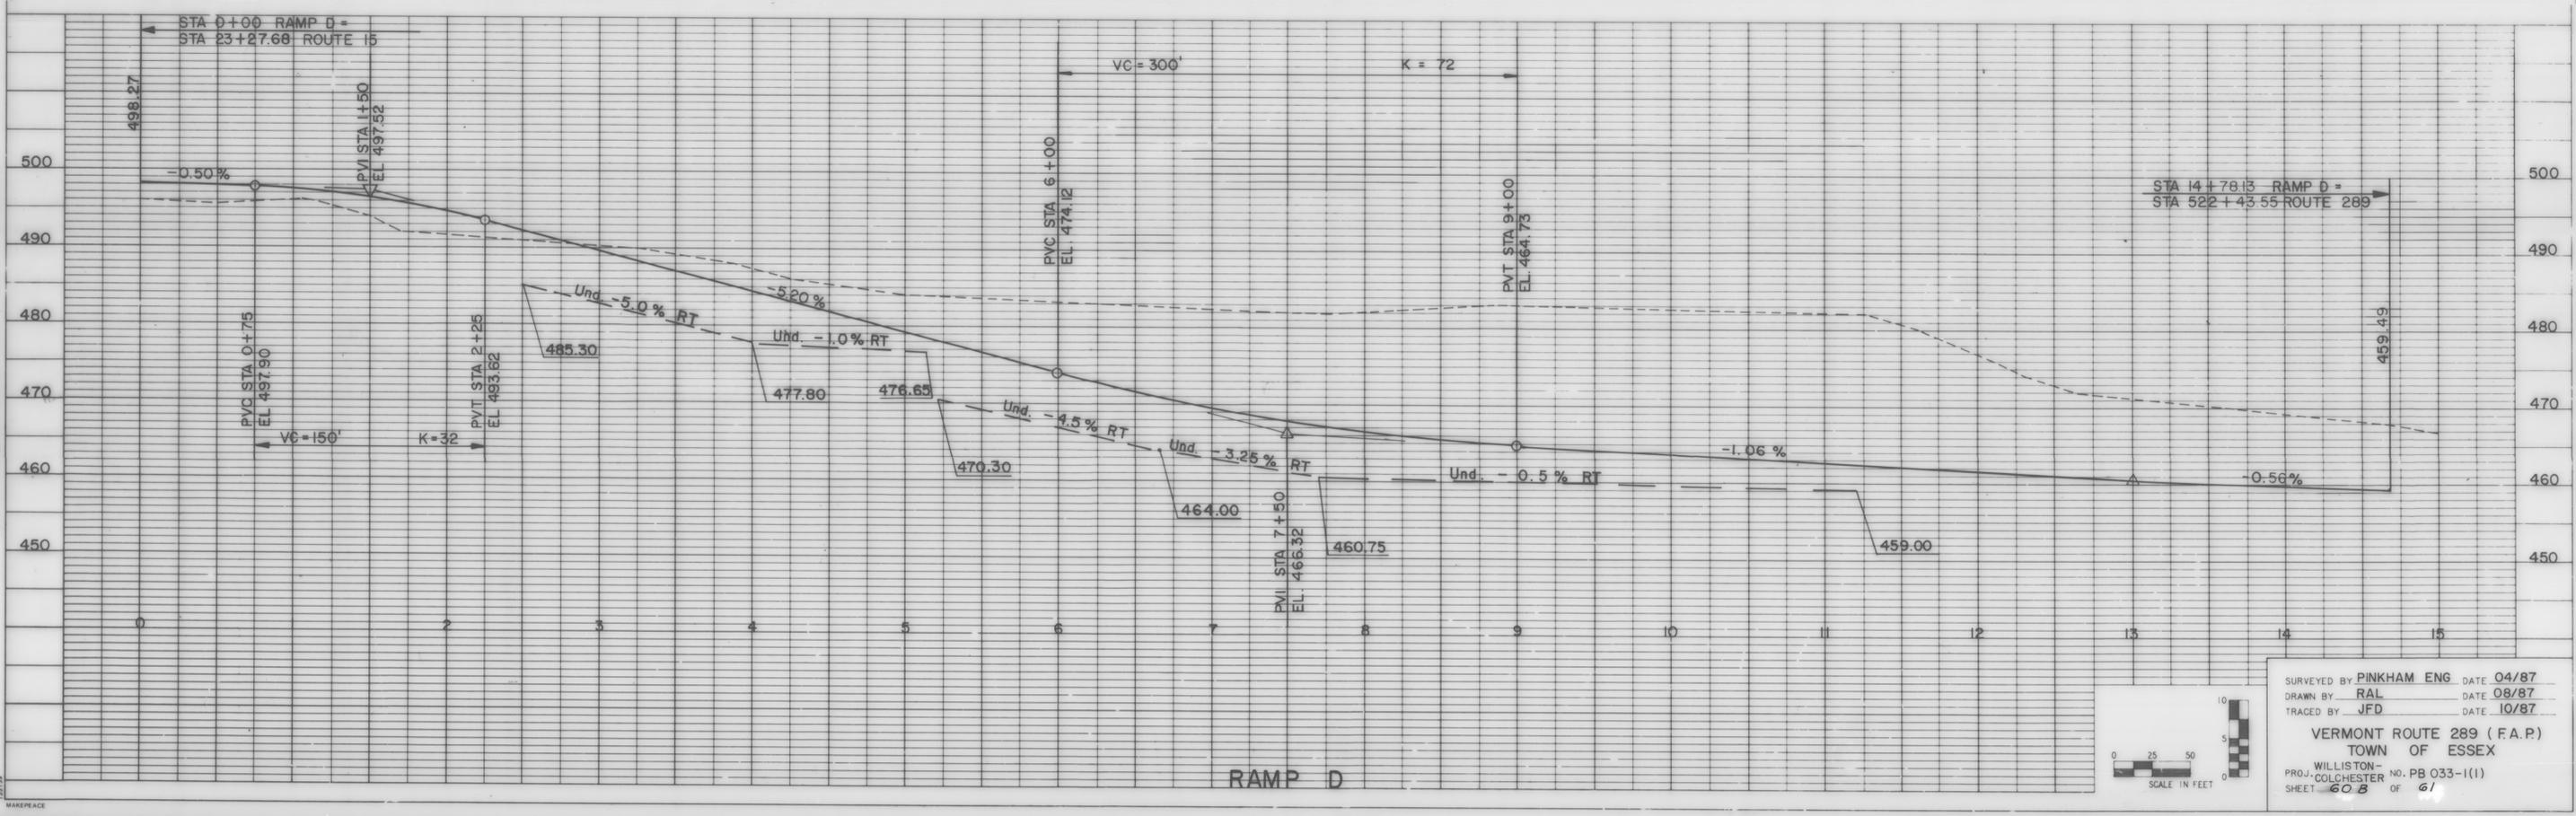

SURVEYED BY PINKHAM ENG DATE 04/87  
 DRAWN BY RAL DATE 08/87  
 TRACED BY JFD DATE 10/87  
 VERMONT ROUTE 289 (F.A.P.)  
 TOWN OF ESSEX  
 PROJ. WILLISTON- COLCHESTER NO. PB 033-1(1)  
 SHEET 60 B OF 61