


PLAN	SURVEYED	DATE
NOTE BOOK	PLOTTED	
No.	RT. OF WAY CHECKED	

PROFILE	SURVEYED	DATE
NOTE BOOK	GRADES CHECKED	
No.	RT. OF WAY CHECKED	

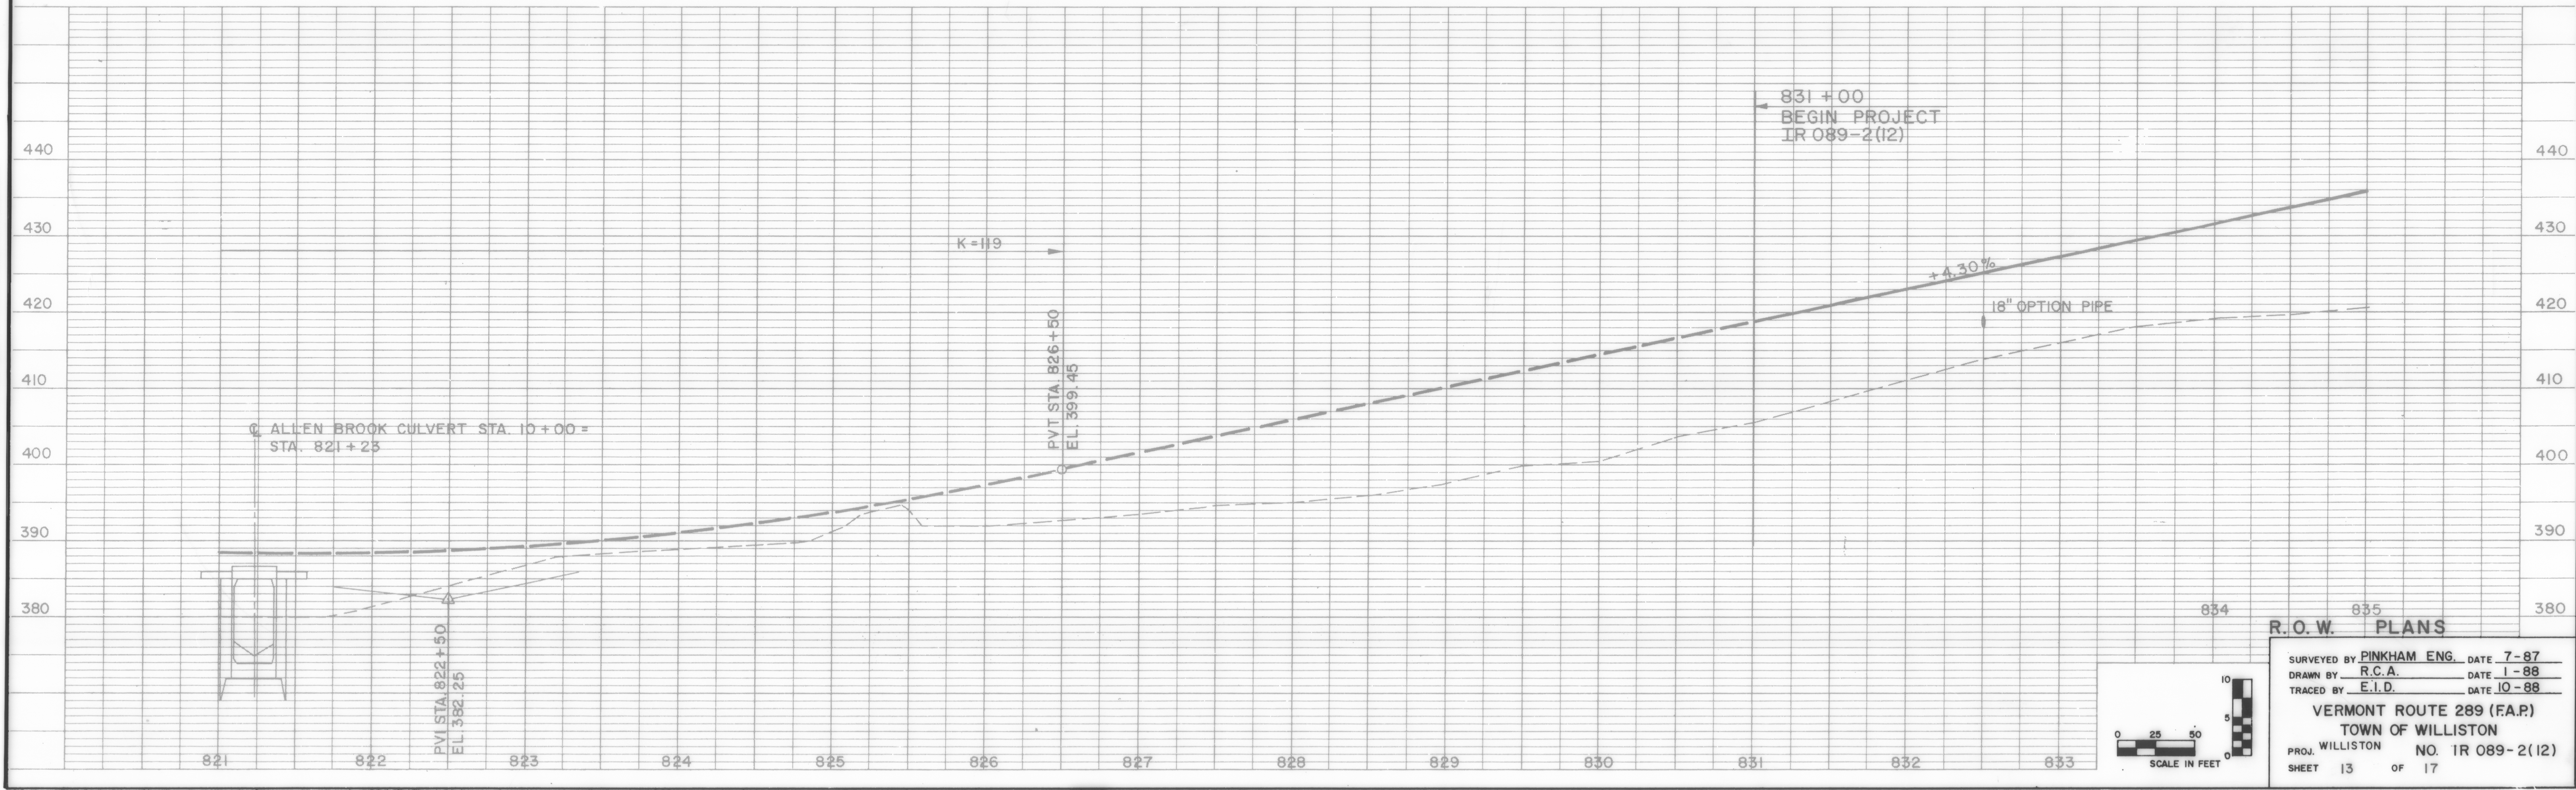

R.O.W. PLANS

SURVEYED BY PINKHAM ENG. DATE 7-87
 DRAWN BY R.C.A. DATE 1-88
 TRACED BY E.I.D. DATE 10-88

VERMONT ROUTE 289 (F.A.P.)
 TOWN OF WILLISTON
 PROJ. WILLISTON NO. 1R 089-2(12)
 SHEET 13 OF 17