


PROFILE SURVEYED BY DATE
 PLOTTED BY
 NOTE BOOK NO. CHECKED BY
 B.M. & NOTED
 STRUCTURE NOTATIONS CHYD



PROFILE SURVEYED BY DATE
 PLOTTED BY
 NOTE BOOK NO. CHECKED BY
 B.M. & NOTED
 STRUCTURE NOTATIONS CHYD

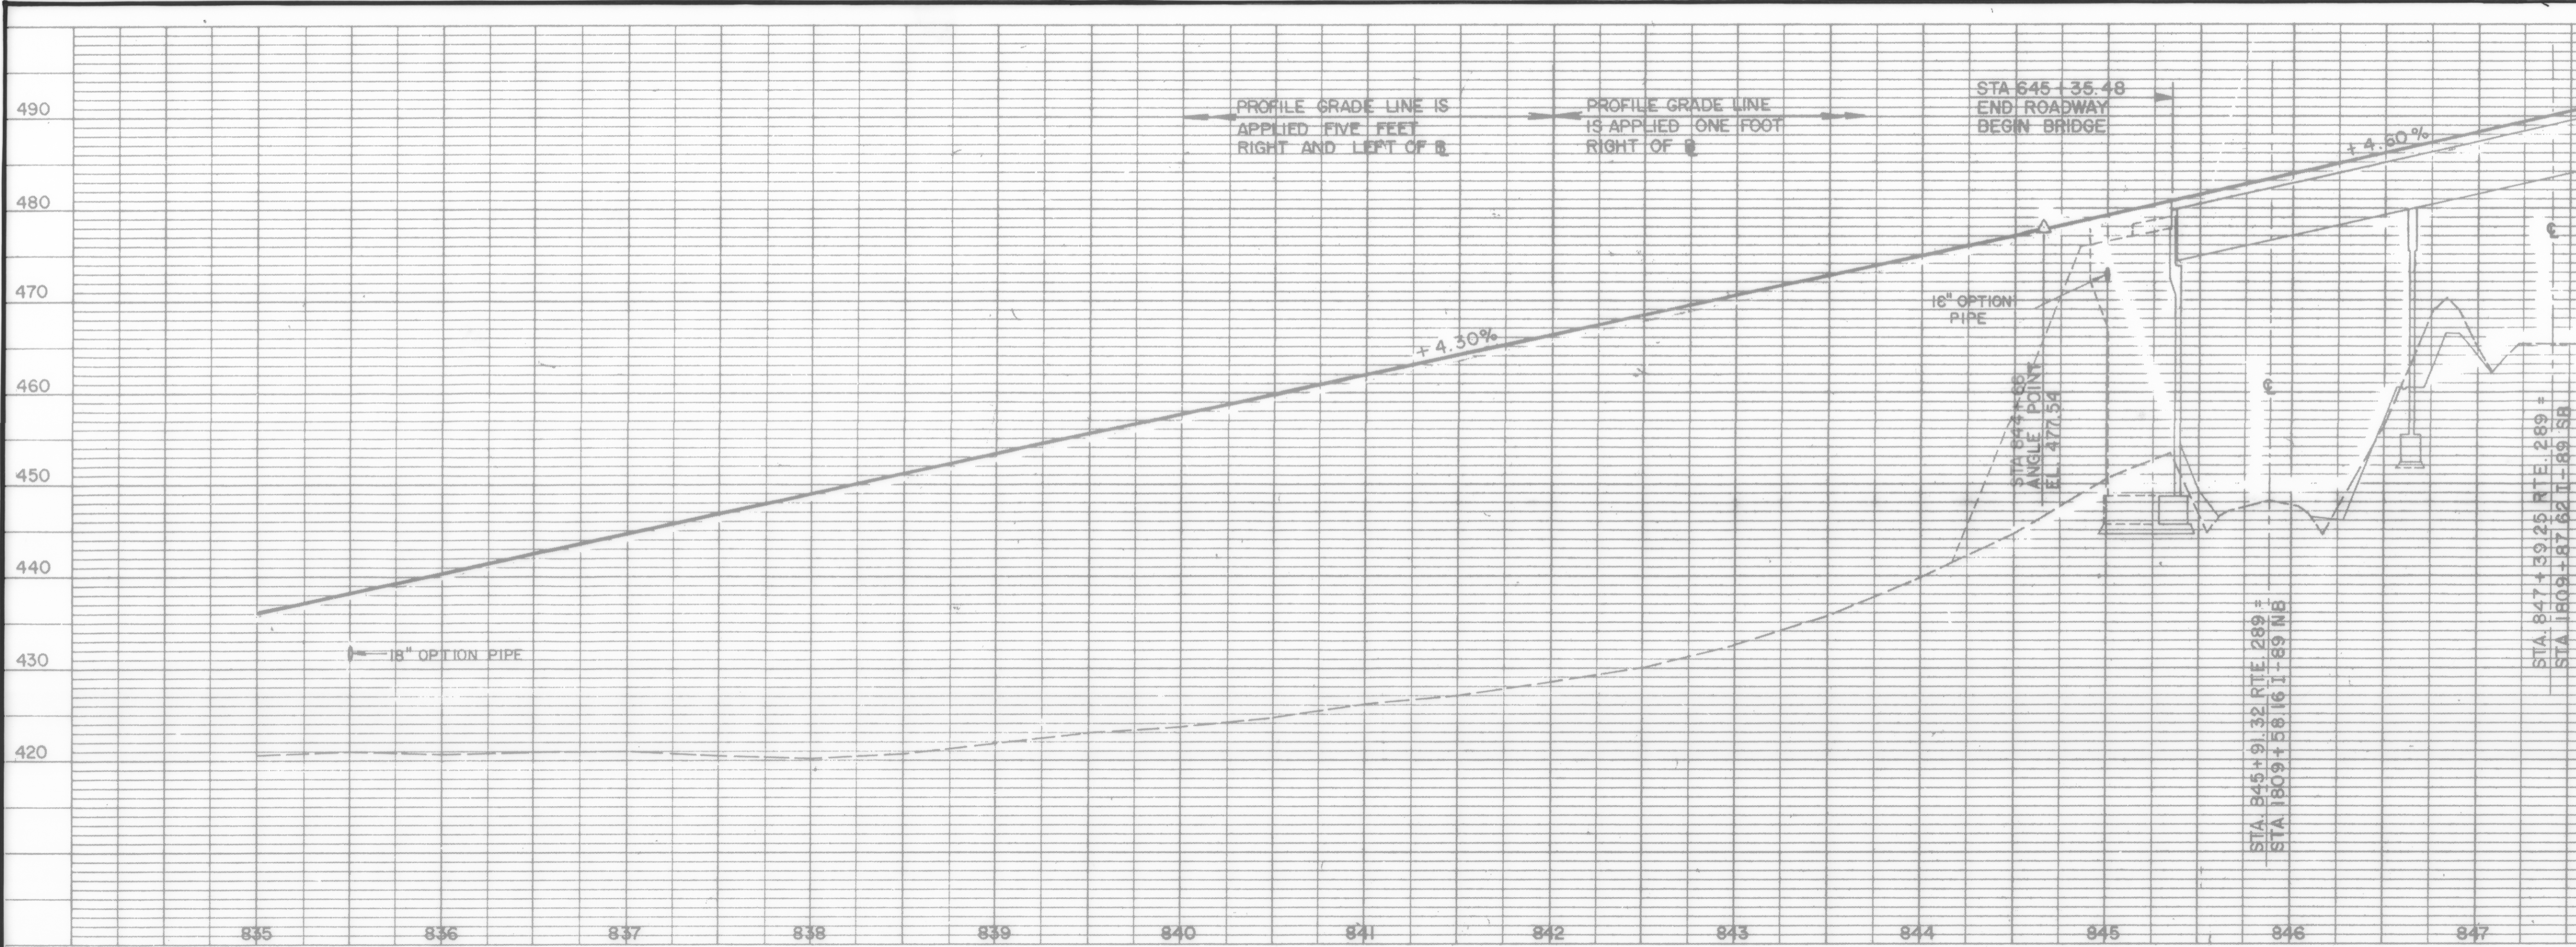