

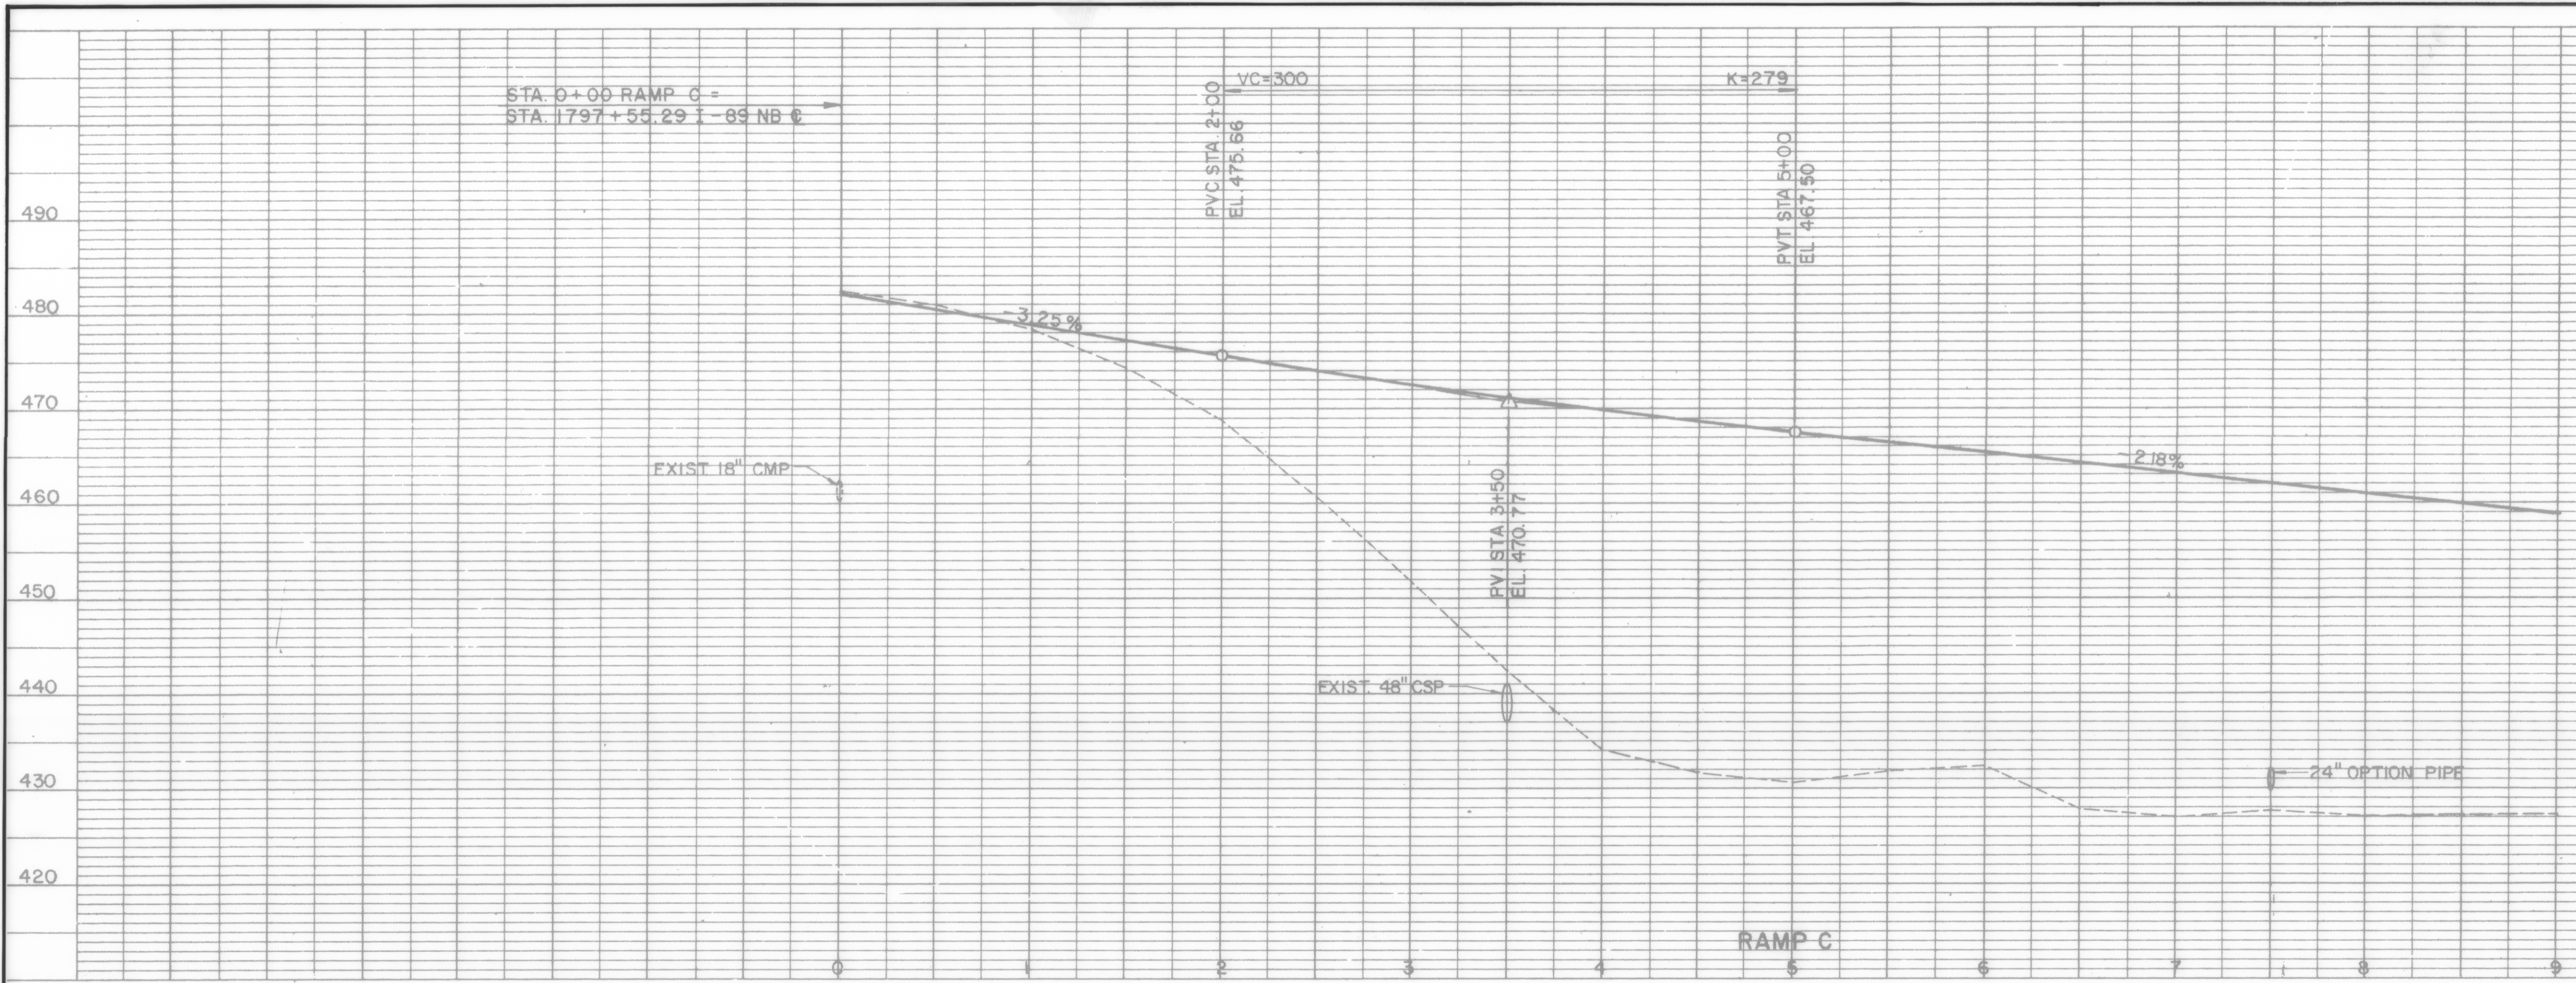


DATE	
BY	
PROF. FILE	
SURVEYED	
PLOTTED	
NOTE BOOK	
NO.	
STRUCTURE	
NOTATION	
CH/NO	

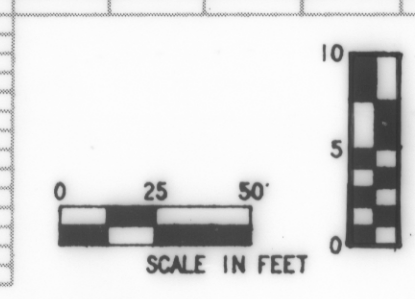

DATE	
BY	
PROF. FILE	
SURVEYED	
PLOTTED	
NOTE BOOK	
NO.	
STRUCTURE	
NOTATION	
CH/NO	

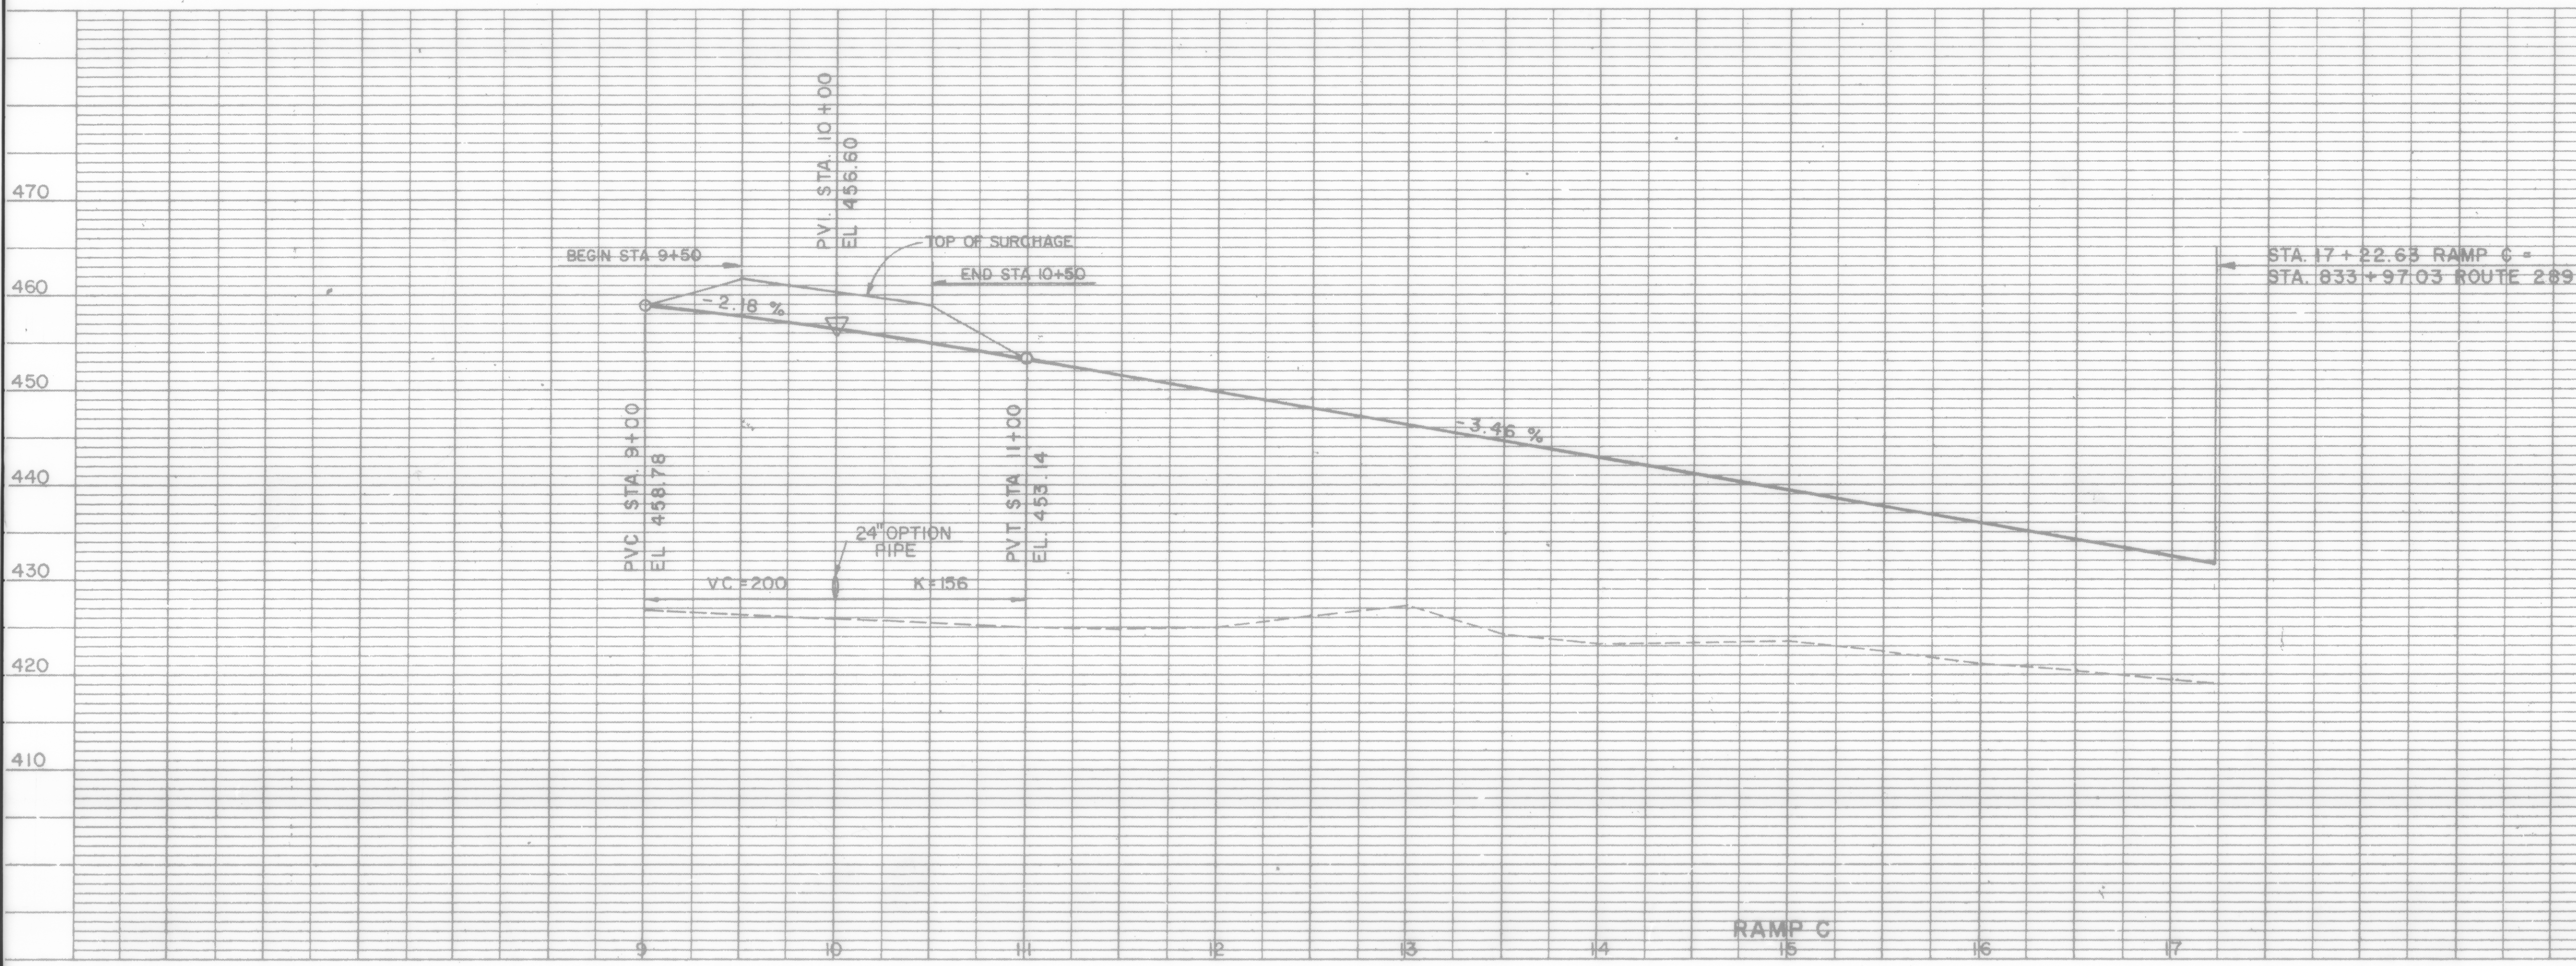

I-89 INTERCHANGE