
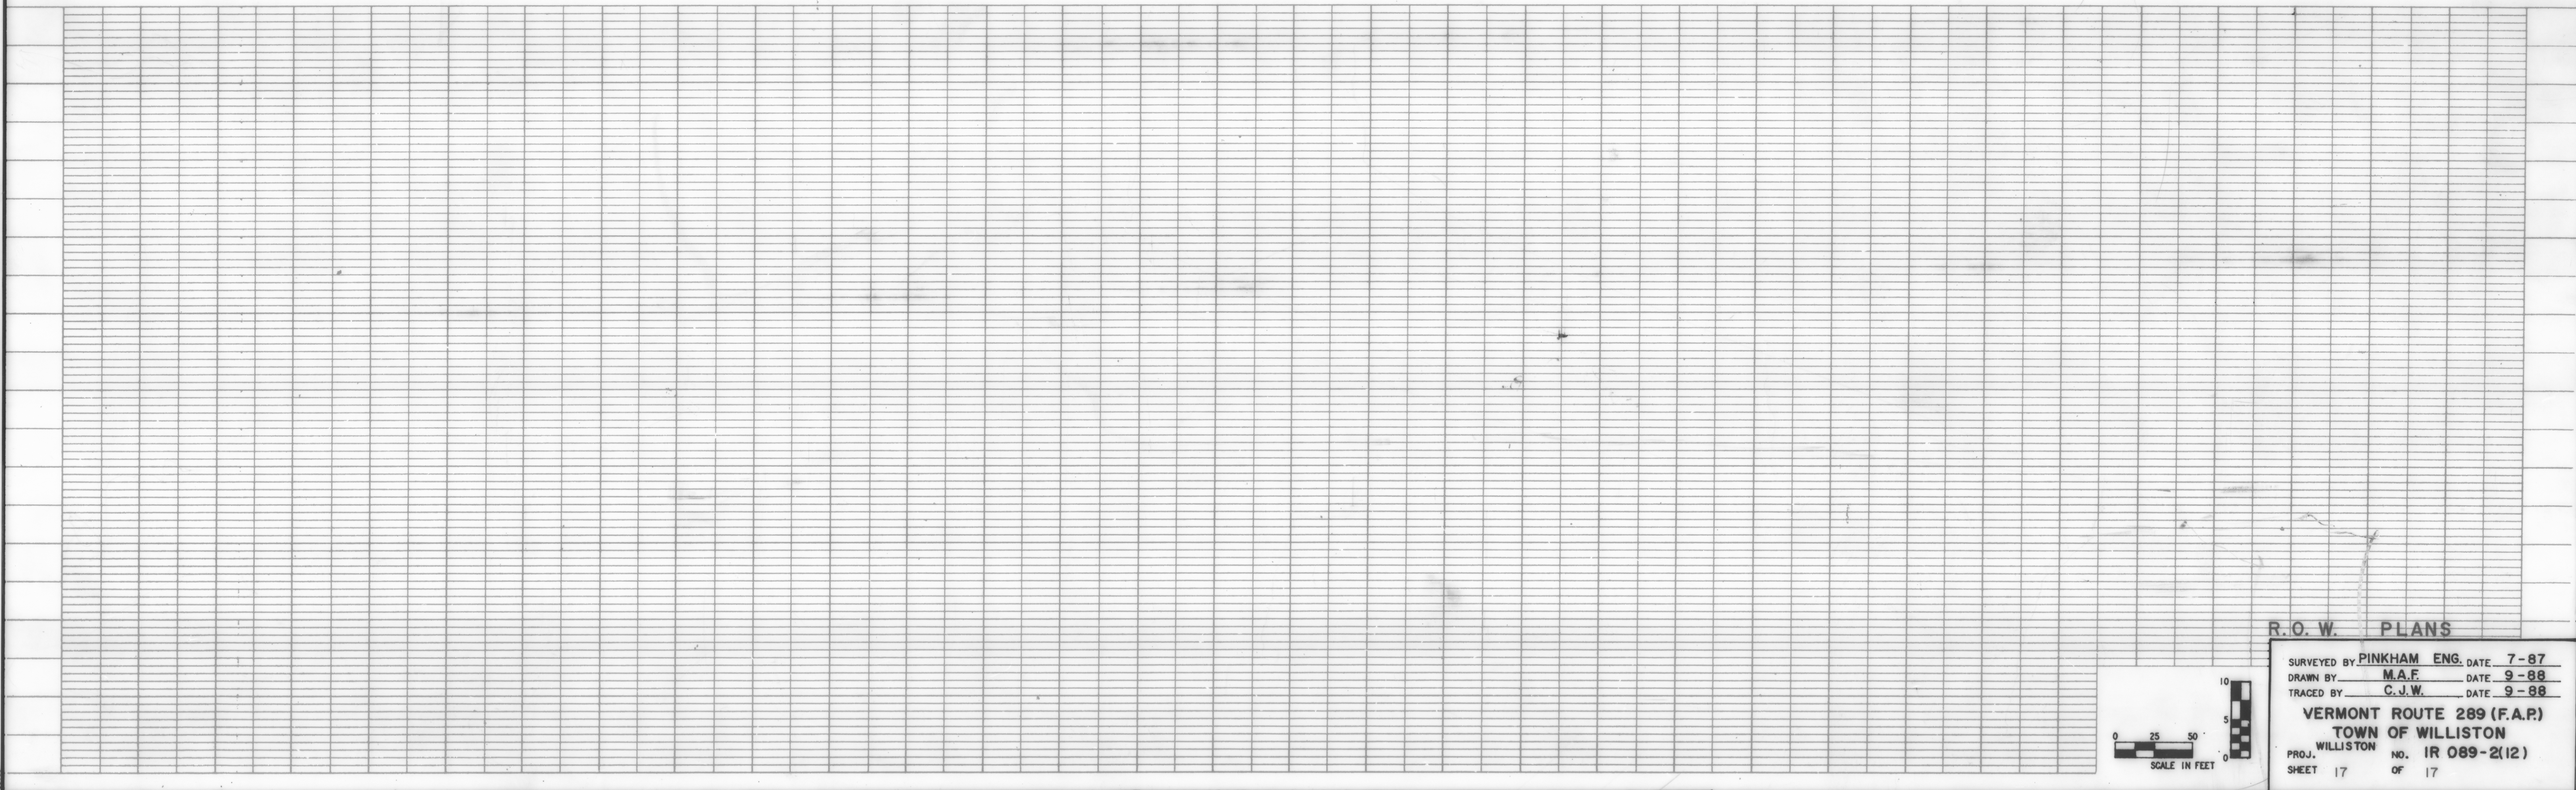


PROFILE SURVEYED BY DATE  
 PLOTTED  
 GRADES CHECKED  
 NOTE BOOK NO. STRUCTURE NO./AT/HS CH/D


PROFILE SURVEYED BY DATE  
 PLOTTED  
 GRADES CHECKED  
 NOTE BOOK NO. STRUCTURE NO./AT/HS CH/D

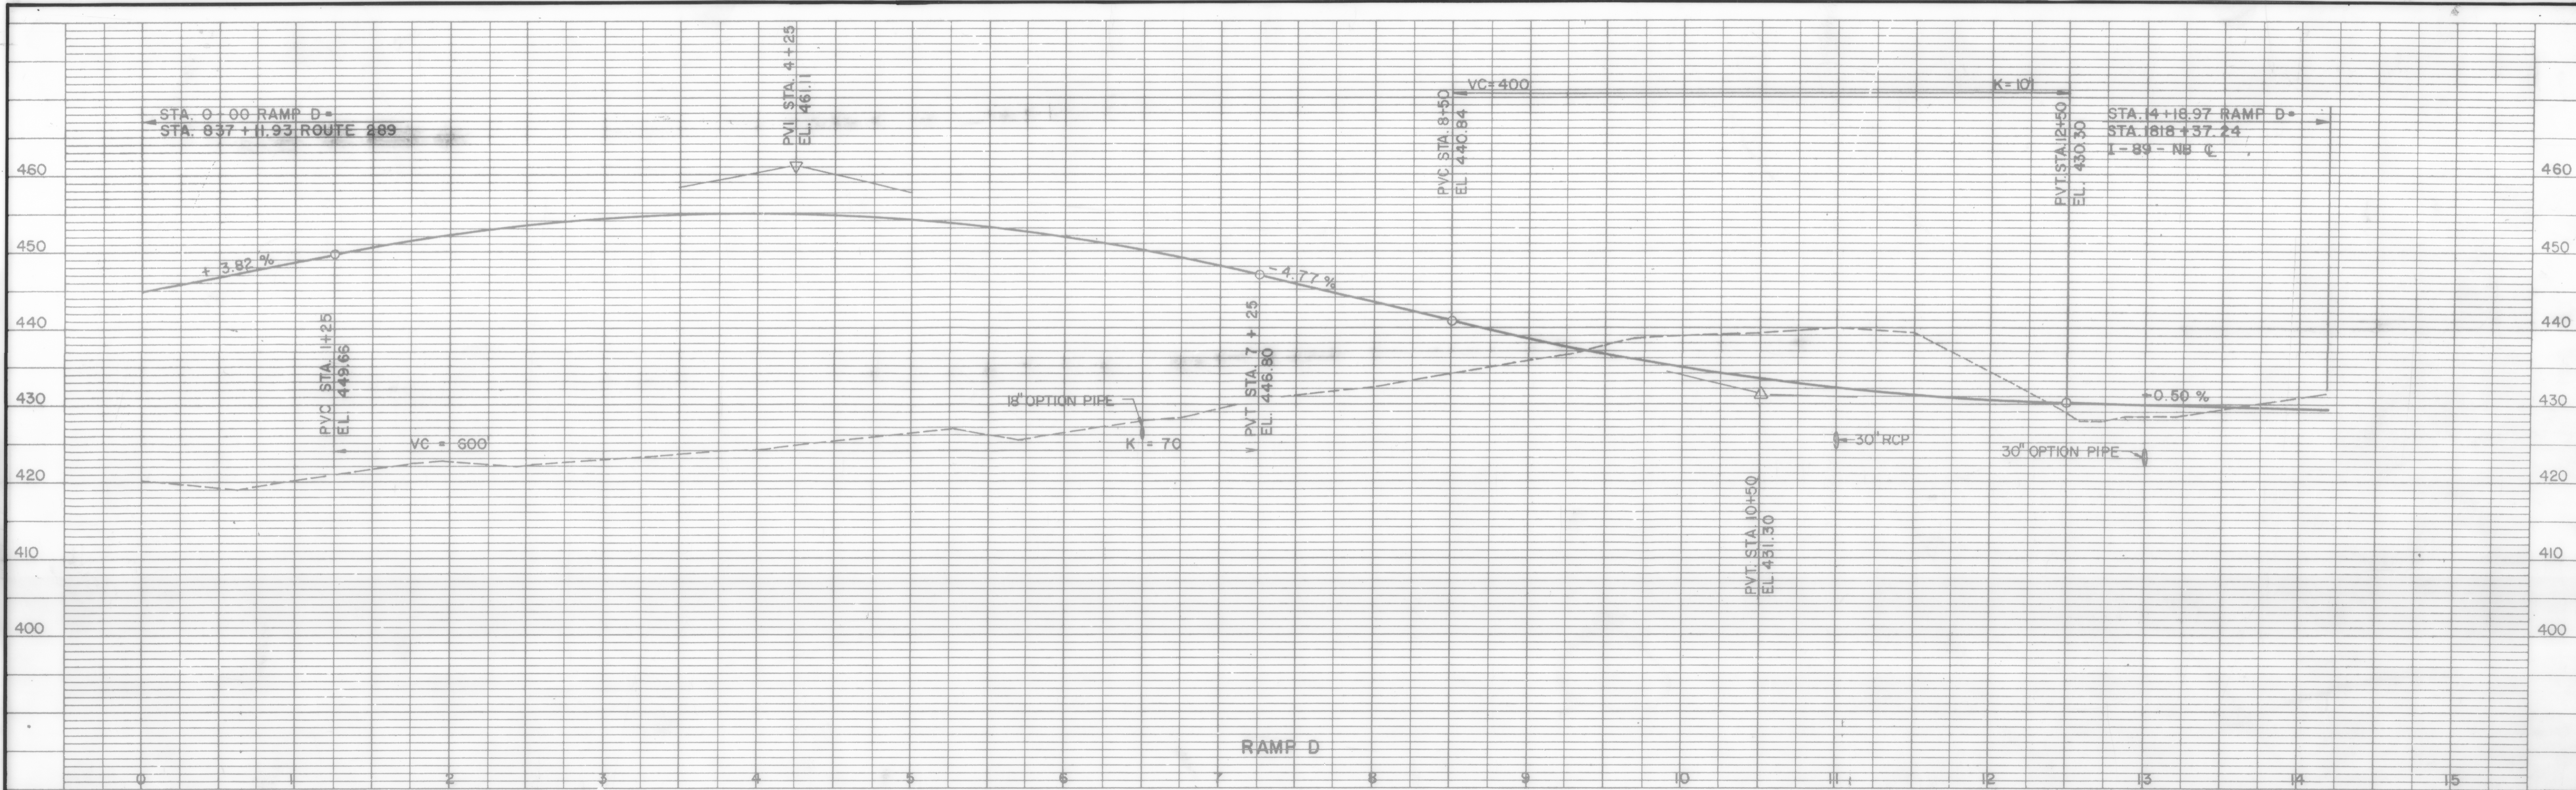

**R.O.W. PLANS**

SURVEYED BY PINKHAM ENG. DATE 7-87  
 DRAWN BY M.A.F. DATE 9-88  
 TRACED BY C.J.W. DATE 9-88

**VERMONT ROUTE 289 (F.A.P.)**  
 TOWN OF WILLISTON  
 PROJ. WILLISTON NO. IR 089-2(12)  
 SHEET 17 OF 17

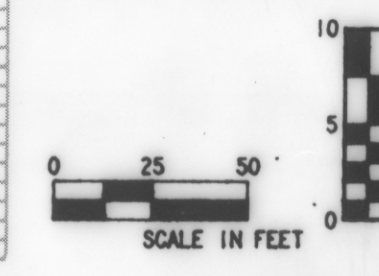

I-89 INTERCHANGE