
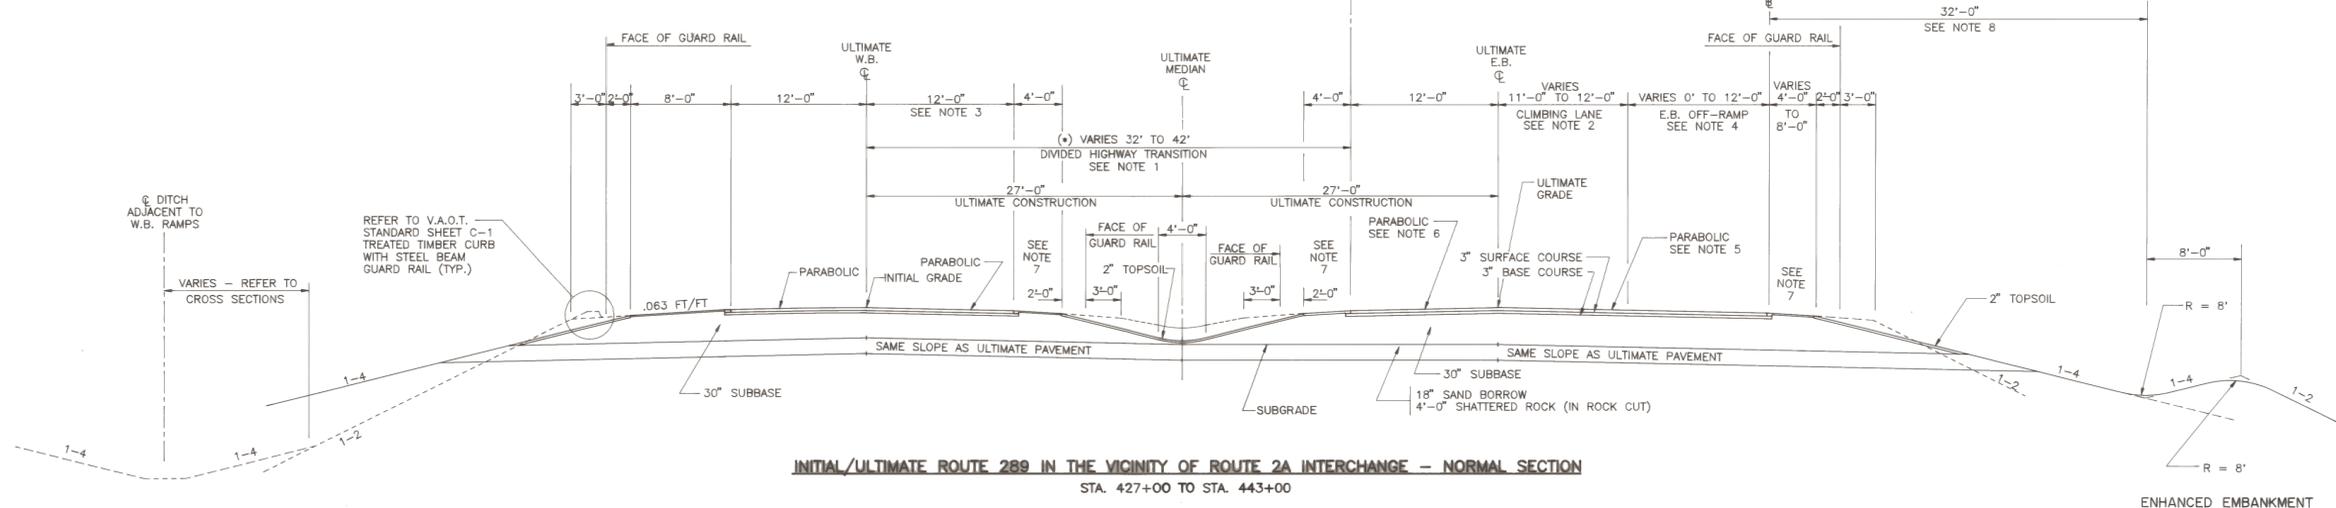
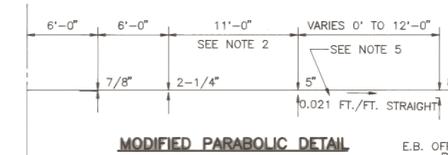
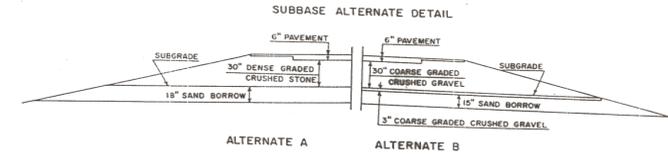
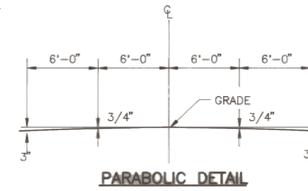


# TYPICAL SECTION - MAINLINE CHITTENDEN COUNTY CIRCUMFERENTIAL HIGHWAY

PAVEMENT:	6" BITUMINOUS CONCRETE PAVEMENT	ITEM NUMBERS	406.25
	1-1/4" TYPE III WEARING COURSE		
	1-3/4" TYPE II BINDER COURSE		
	3" TYPE I BASE COURSE		
SHOULDERS:	1-1/4" TYPE III WEARING COURSE		
ALTERNATE A	30" SUBBASE OF DENSE GRADED CRUSHED STONE	301.35	
SHOWN BELOW	18" SAND BORROW	203.31	
	4'-0" SHATTERED ROCK (IN ROCK CUT)		

NOTE: ALL FROST SUSCEPTIBLE MATERIAL WITHIN 54" (DESIGN FROST DEPTH) OF FINISH GRADE SHALL BE REMOVED AND REPLACED AS SHOWN

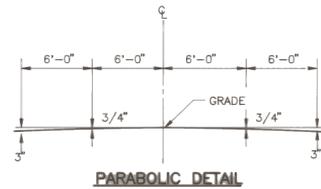

BUILT AS DESIGNED 4/19/94 SC

REVISED SUBBASE 6-25-91 DZG

DATUM	
VERTICAL	N.G.V.D. 1929
HORIZONTAL	N.A.D. 1927

- 7.) ALL SHOULDERS LESS THAN 8'-0" WIDE WILL BE BANKED THE SAME AS THE ADJOINING PAVEMENT UNLESS OTHERWISE NOTED.
- 8.) ENHANCED EMBANKMENT TO BE USED WHERE GUARD RAIL CAN BE ELIMINATED.

SURVEYED BY	V.S. INC./C.H.A.	DATE	1988-90
DRAWN BY	T. KARIS	DATE	4/89
TRACED BY	J. LUKOVITS	DATE	4/89
<b>VERMONT ROUTE 289 (F.A.P.)</b>			
<b>TOWN OF ESSEX</b>			
PROJ. WILLISTON-	NO. PB 033-1	(2)	
COLCHESTER			
SHEET	3 OF 400		