


# TEMPORARY EROSION CONTROL PLAN

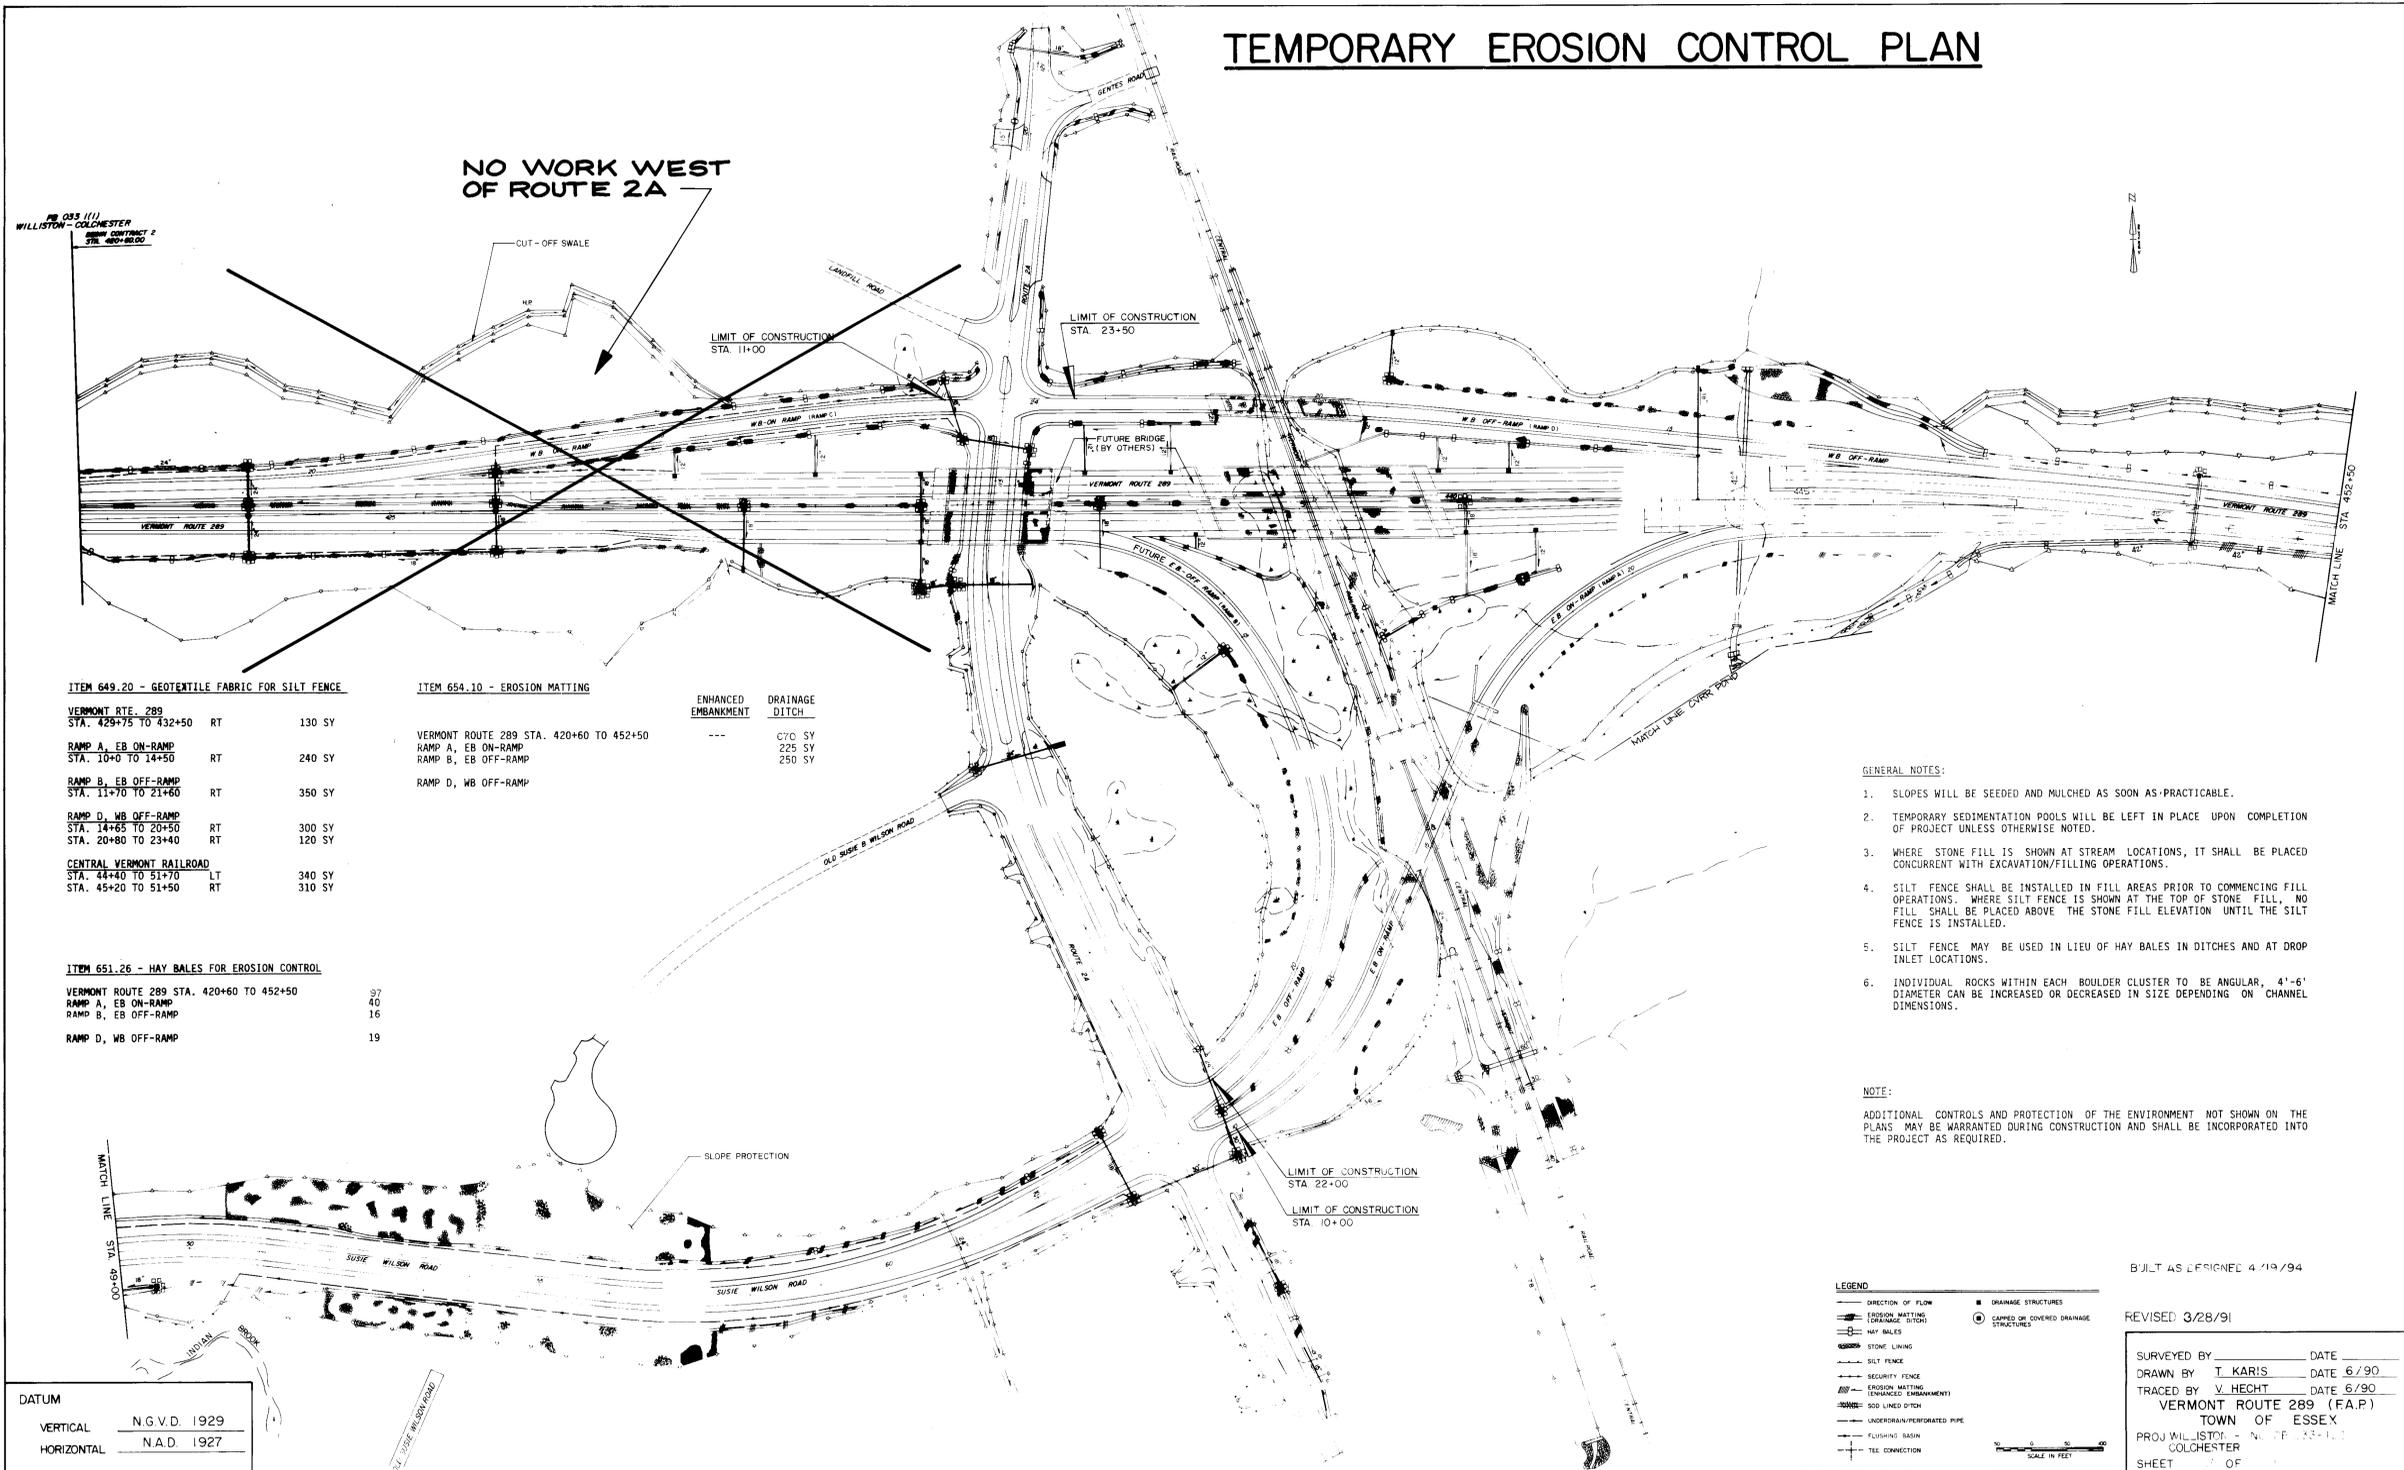

PROJECT NO. 033 (11)  
WILLISTON - COLCHESTER  
NEW CONTRACT 2  
STA. 400+00.00

**NO WORK WEST  
OF ROUTE 2A**

**ITEM 649.20 - GEOTEXTILE FABRIC FOR SILT FENCE**

VERMONT RTE. 289		SY
STA. 429+75 TO 432+50	RT	130
RAMP A, EB ON-RAMP STA. 10+0 TO 14+50	RT	240
RAMP B, EB OFF-RAMP STA. 11+70 TO 21+60	RT	350
RAMP D, WB OFF-RAMP STA. 14+85 TO 20+50	RT	300
STA. 20+80 TO 23+40	RT	120
<b>CENTRAL VERMONT RAILROAD</b>		
STA. 44+40 TO 51+70	LT	340
STA. 45+20 TO 51+50	RT	310

**ITEM 654.10 - EROSION MATTING**

VERMONT ROUTE 289 STA. 420+60 TO 452+50	SY
RAMP A, EB ON-RAMP	225
RAMP B, EB OFF-RAMP	250
RAMP D, WB OFF-RAMP	

ENHANCED EMBANKMENT	DRAINAGE DITCH
---	C70 SY
	225 SY
	250 SY

**ITEM 651.26 - HAY BALES FOR EROSION CONTROL**

VERMONT ROUTE 289 STA. 420+60 TO 452+50	SY
RAMP A, EB ON-RAMP	40
RAMP B, EB OFF-RAMP	16
RAMP D, WB OFF-RAMP	19

**GENERAL NOTES:**

- SLOPES WILL BE SEEDED AND MULCHED AS SOON AS PRACTICABLE.
- TEMPORARY SEDIMENTATION POOLS WILL BE LEFT IN PLACE UPON COMPLETION OF PROJECT UNLESS OTHERWISE NOTED.
- WHERE STONE FILL IS SHOWN AT STREAM LOCATIONS, IT SHALL BE PLACED CONCURRENT WITH EXCAVATION/FILLING OPERATIONS.
- SILT FENCE SHALL BE INSTALLED IN FILL AREAS PRIOR TO COMMENCING FILL OPERATIONS. WHERE SILT FENCE IS SHOWN AT THE TOP OF STONE FILL, NO FILL SHALL BE PLACED ABOVE THE STONE FILL ELEVATION UNTIL THE SILT FENCE IS INSTALLED.
- SILT FENCE MAY BE USED IN LIEU OF HAY BALES IN DITCHES AND AT DROP INLET LOCATIONS.
- INDIVIDUAL ROCKS WITHIN EACH BOULDER CLUSTER TO BE ANGULAR, 4'-6' DIAMETER CAN BE INCREASED OR DECREASED IN SIZE DEPENDING ON CHANNEL DIMENSIONS.

**NOTE:**

ADDITIONAL CONTROLS AND PROTECTION OF THE ENVIRONMENT NOT SHOWN ON THE PLANS MAY BE WARRANTED DURING CONSTRUCTION AND SHALL BE INCORPORATED INTO THE PROJECT AS REQUIRED.

**DATUM**

VERTICAL	N.G.V.D. 1929
HORIZONTAL	N.A.D. 1927

**LEGEND**

— DIRECTION OF FLOW	■ DRAINAGE STRUCTURES
— EROSION MATTING (DRAINAGE DITCH)	⊙ CAPPED OR COVERED DRAINAGE STRUCTURES
— HAY BALES	
— STONE LINING	
— SILT FENCE	
— SECURITY FENCE	
— EROSION MATTING (ENHANCED EMBANKMENT)	
— SOIL LINED DITCH	
— UNDERDRAIN/PERFORATED PIPE	
— FLUSHING BASIN	
— TELE CONNECTION	

SCALE IN FEET

BUILT AS DESIGNED 4/19/94

REVISED 3/28/91

SURVEYED BY \_\_\_\_\_ DATE \_\_\_\_\_  
 DRAWN BY T. KARIS DATE 6/90  
 TRACED BY V. HECHT DATE 6/90  
 VERMONT ROUTE 289 (F.A.P.)  
 TOWN OF ESSEX  
 PROJ WILLISTON - COLCHESTER  
 SHEET \_\_\_\_\_ OF \_\_\_\_\_