


EROSION CONTROL PLAN (INCLUDES TEMPORARY EROSION CONTROL)

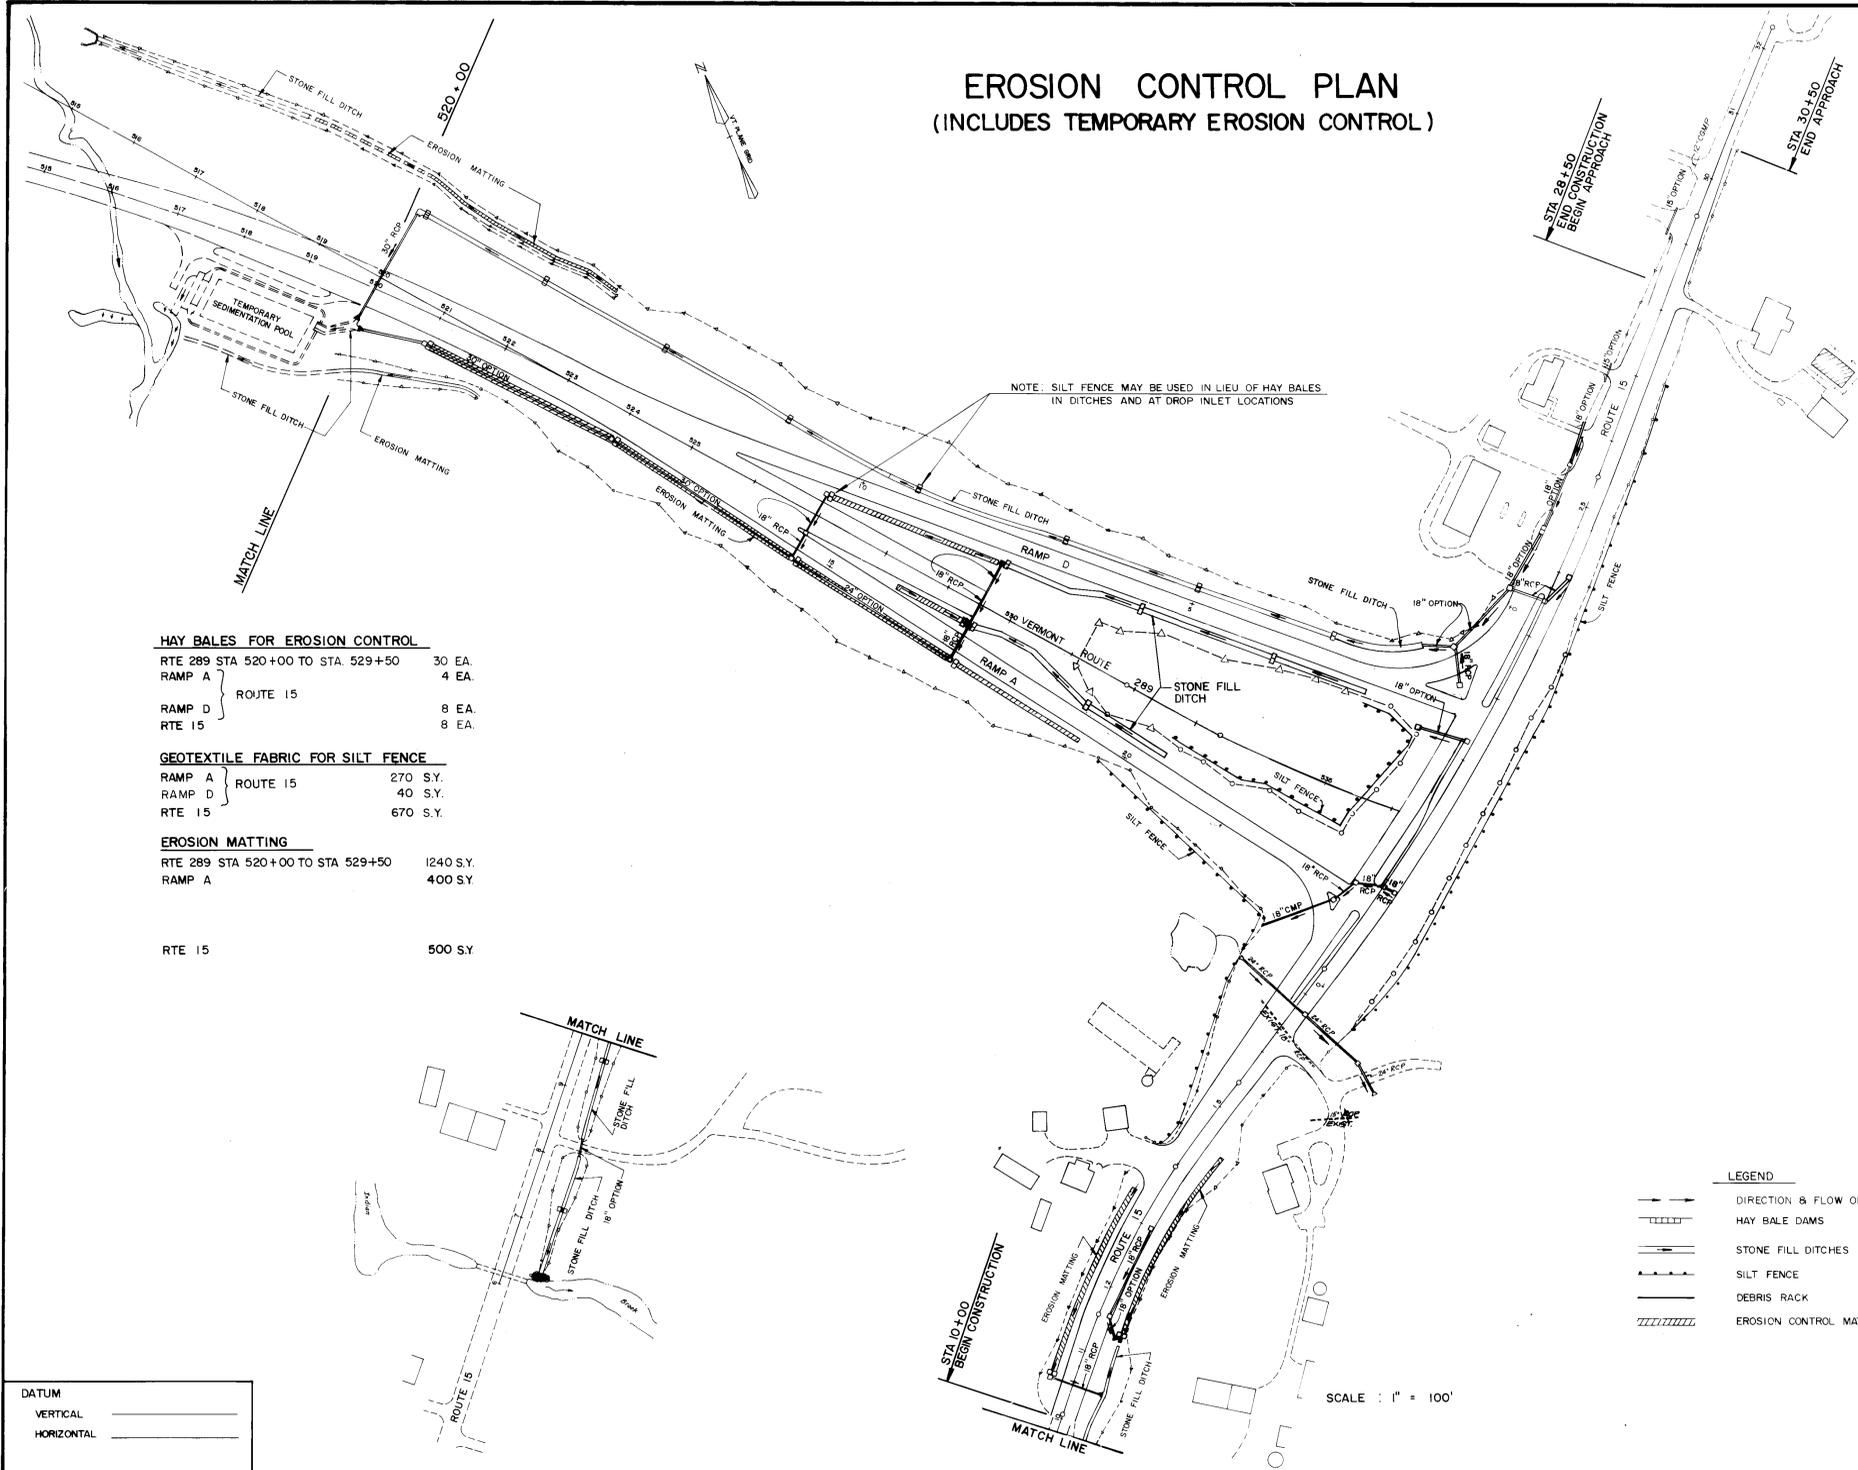

GENERAL NOTES

1. SLOPES WILL BE SEEDED AND MULCHED AS SOON AS PRACTICABLE.
2. WHERE STONE FILL IS SHOWN AT STREAM LOCATIONS IT SHALL BE PLACED CONCURRENT WITH EXCAVATION/ FILLING OPERATIONS.
3. SILT FENCE SHALL BE INSTALLED IN FILL AREAS PRIOR TO COMMENCING FILL OPERATIONS. WHERE SILT FENCE IS SHOWN AT THE TOP OF STONE FILL, NO FILL SHALL BE PLACED ABOVE THE STONE FILL ELEVATION UNTIL THE SILT FENCE IS INSTALLED.
4. SILT FENCE MAY BE USED IN LIEU OF HAY BALES IN DITCHES AND AT DROP INLET LOCATIONS.

NOTE:

ADDITIONAL CONTROLS AND PROTECTION OF THE ENVIRONMENT NOT SHOWN ON THE PLANS MAY BE WARRANTED DURING CONSTRUCTION AND SHALL BE INCORPORATED INTO THE PROJECT AS REQUIRED

HAY BALES FOR EROSION CONTROL

RTE 289 STA 520+00 TO STA 529+50	30 EA.
RAMP A	4 EA.
ROUTE 15	8 EA.
RAMP D	8 EA.
RTE 15	8 EA.

GEOTEXTILE FABRIC FOR SILT FENCE

RAMP A	ROUTE 15	270 S.Y.
RAMP D	ROUTE 15	40 S.Y.
RTE 15		670 S.Y.

EROSION MATTING

RTE 289 STA 520+00 TO STA 529+50	1240 S.Y.
RAMP A	400 S.Y.

RTE 15	500 S.Y.
--------	----------

LEGEND

- DIRECTION & FLOW OF DITCHES
- HAY BALE DAMS
- STONE FILL DITCHES
- SILT FENCE
- DEBRIS RACK
- EROSION CONTROL MATTING

DATUM	_____
VERTICAL	_____
HORIZONTAL	_____

SCALE : 1" = 100'

BUILT AS DESIGNED 4/19/94 SC

REVISED 12/28/90

SURVEYED BY _____	DATE _____
DRAWN BY R.C.A.	DATE 3/88
TRACED BY N.P.D.	DATE 3/88
VERMONT ROUTE 289 (F.A.P.)	
TOWN OF ESSEX	
PROJ. WILLISTON NO. PB 033-1(2)	
COLCHESTER	
SHEET	36 OF 400