


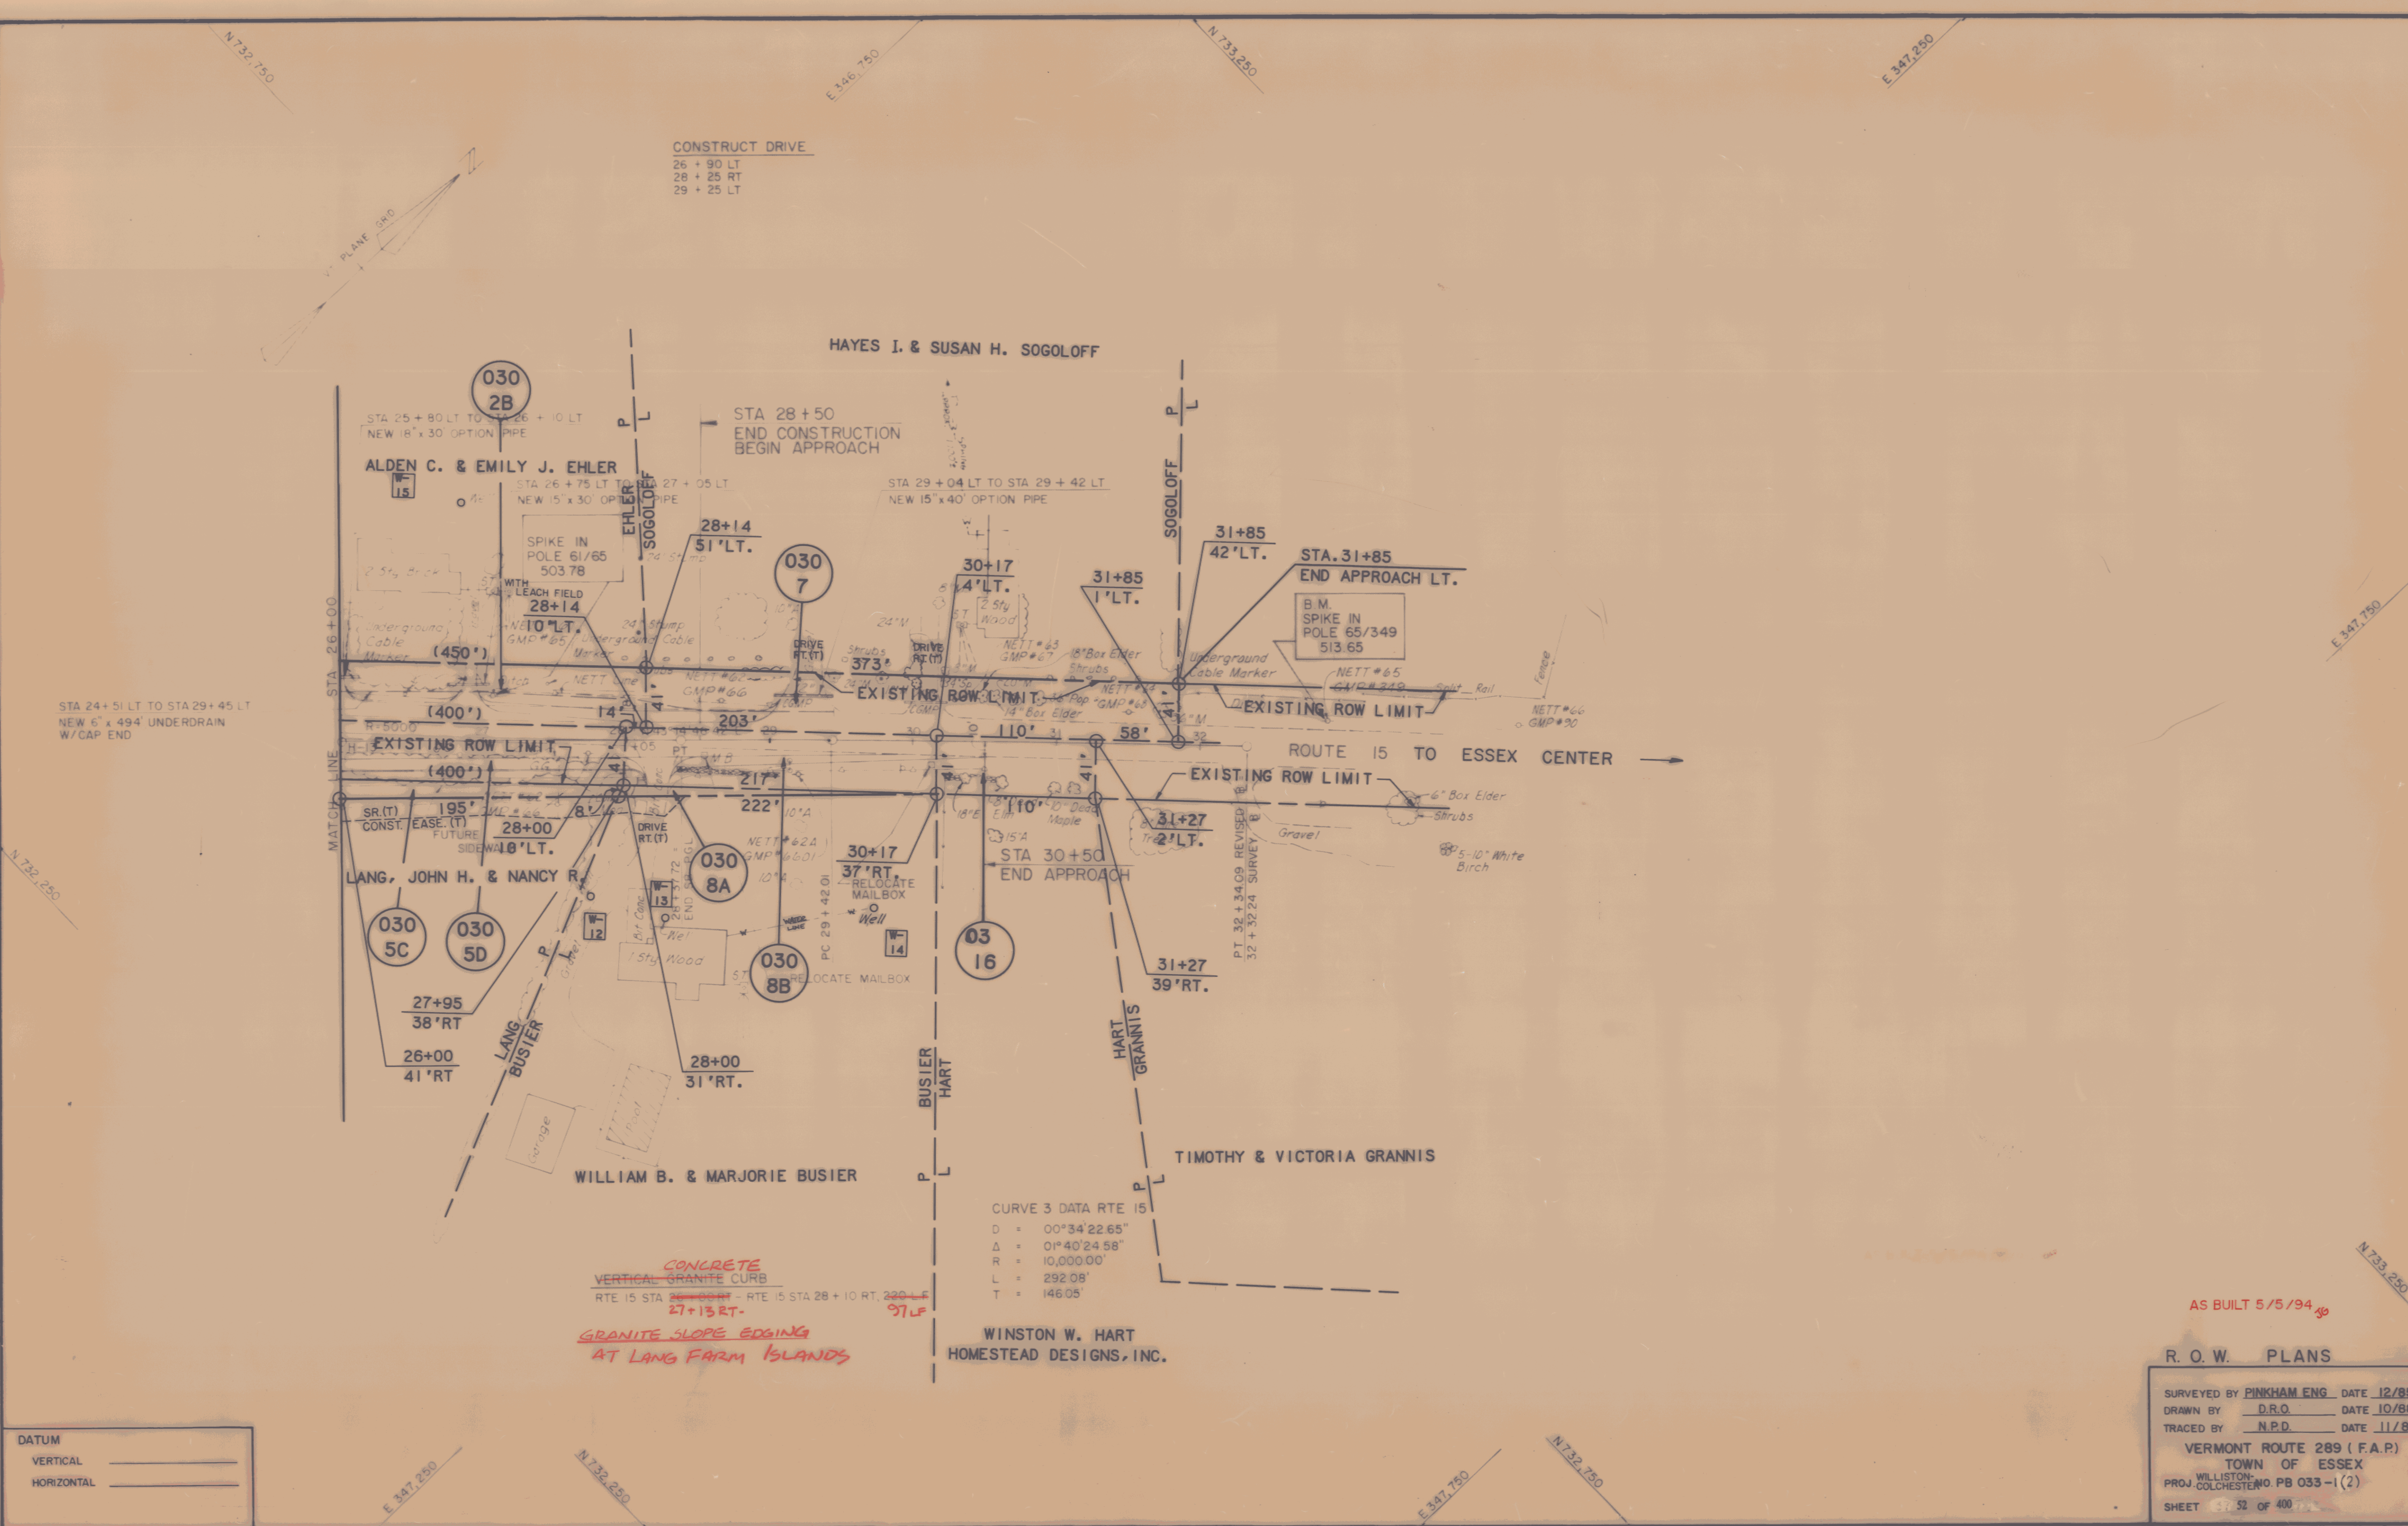

DATUM
VERTICAL _____
HORIZONTAL _____

AS BUILT 5/5/94₉₀

R. O. W. PLANS

SURVEYED BY PINKHAM, ENG.	DATE 12/85
DRAWN BY D.R.O.	DATE 10/88
TRACED BY N.P.D.	DATE 11/88

VERMONT ROUTE 289 (F.A.P.)
TOWN OF ESSEX
PROJ. COLCHESTER NO. PB 033-1(2)
SHEET 52 OF 400