


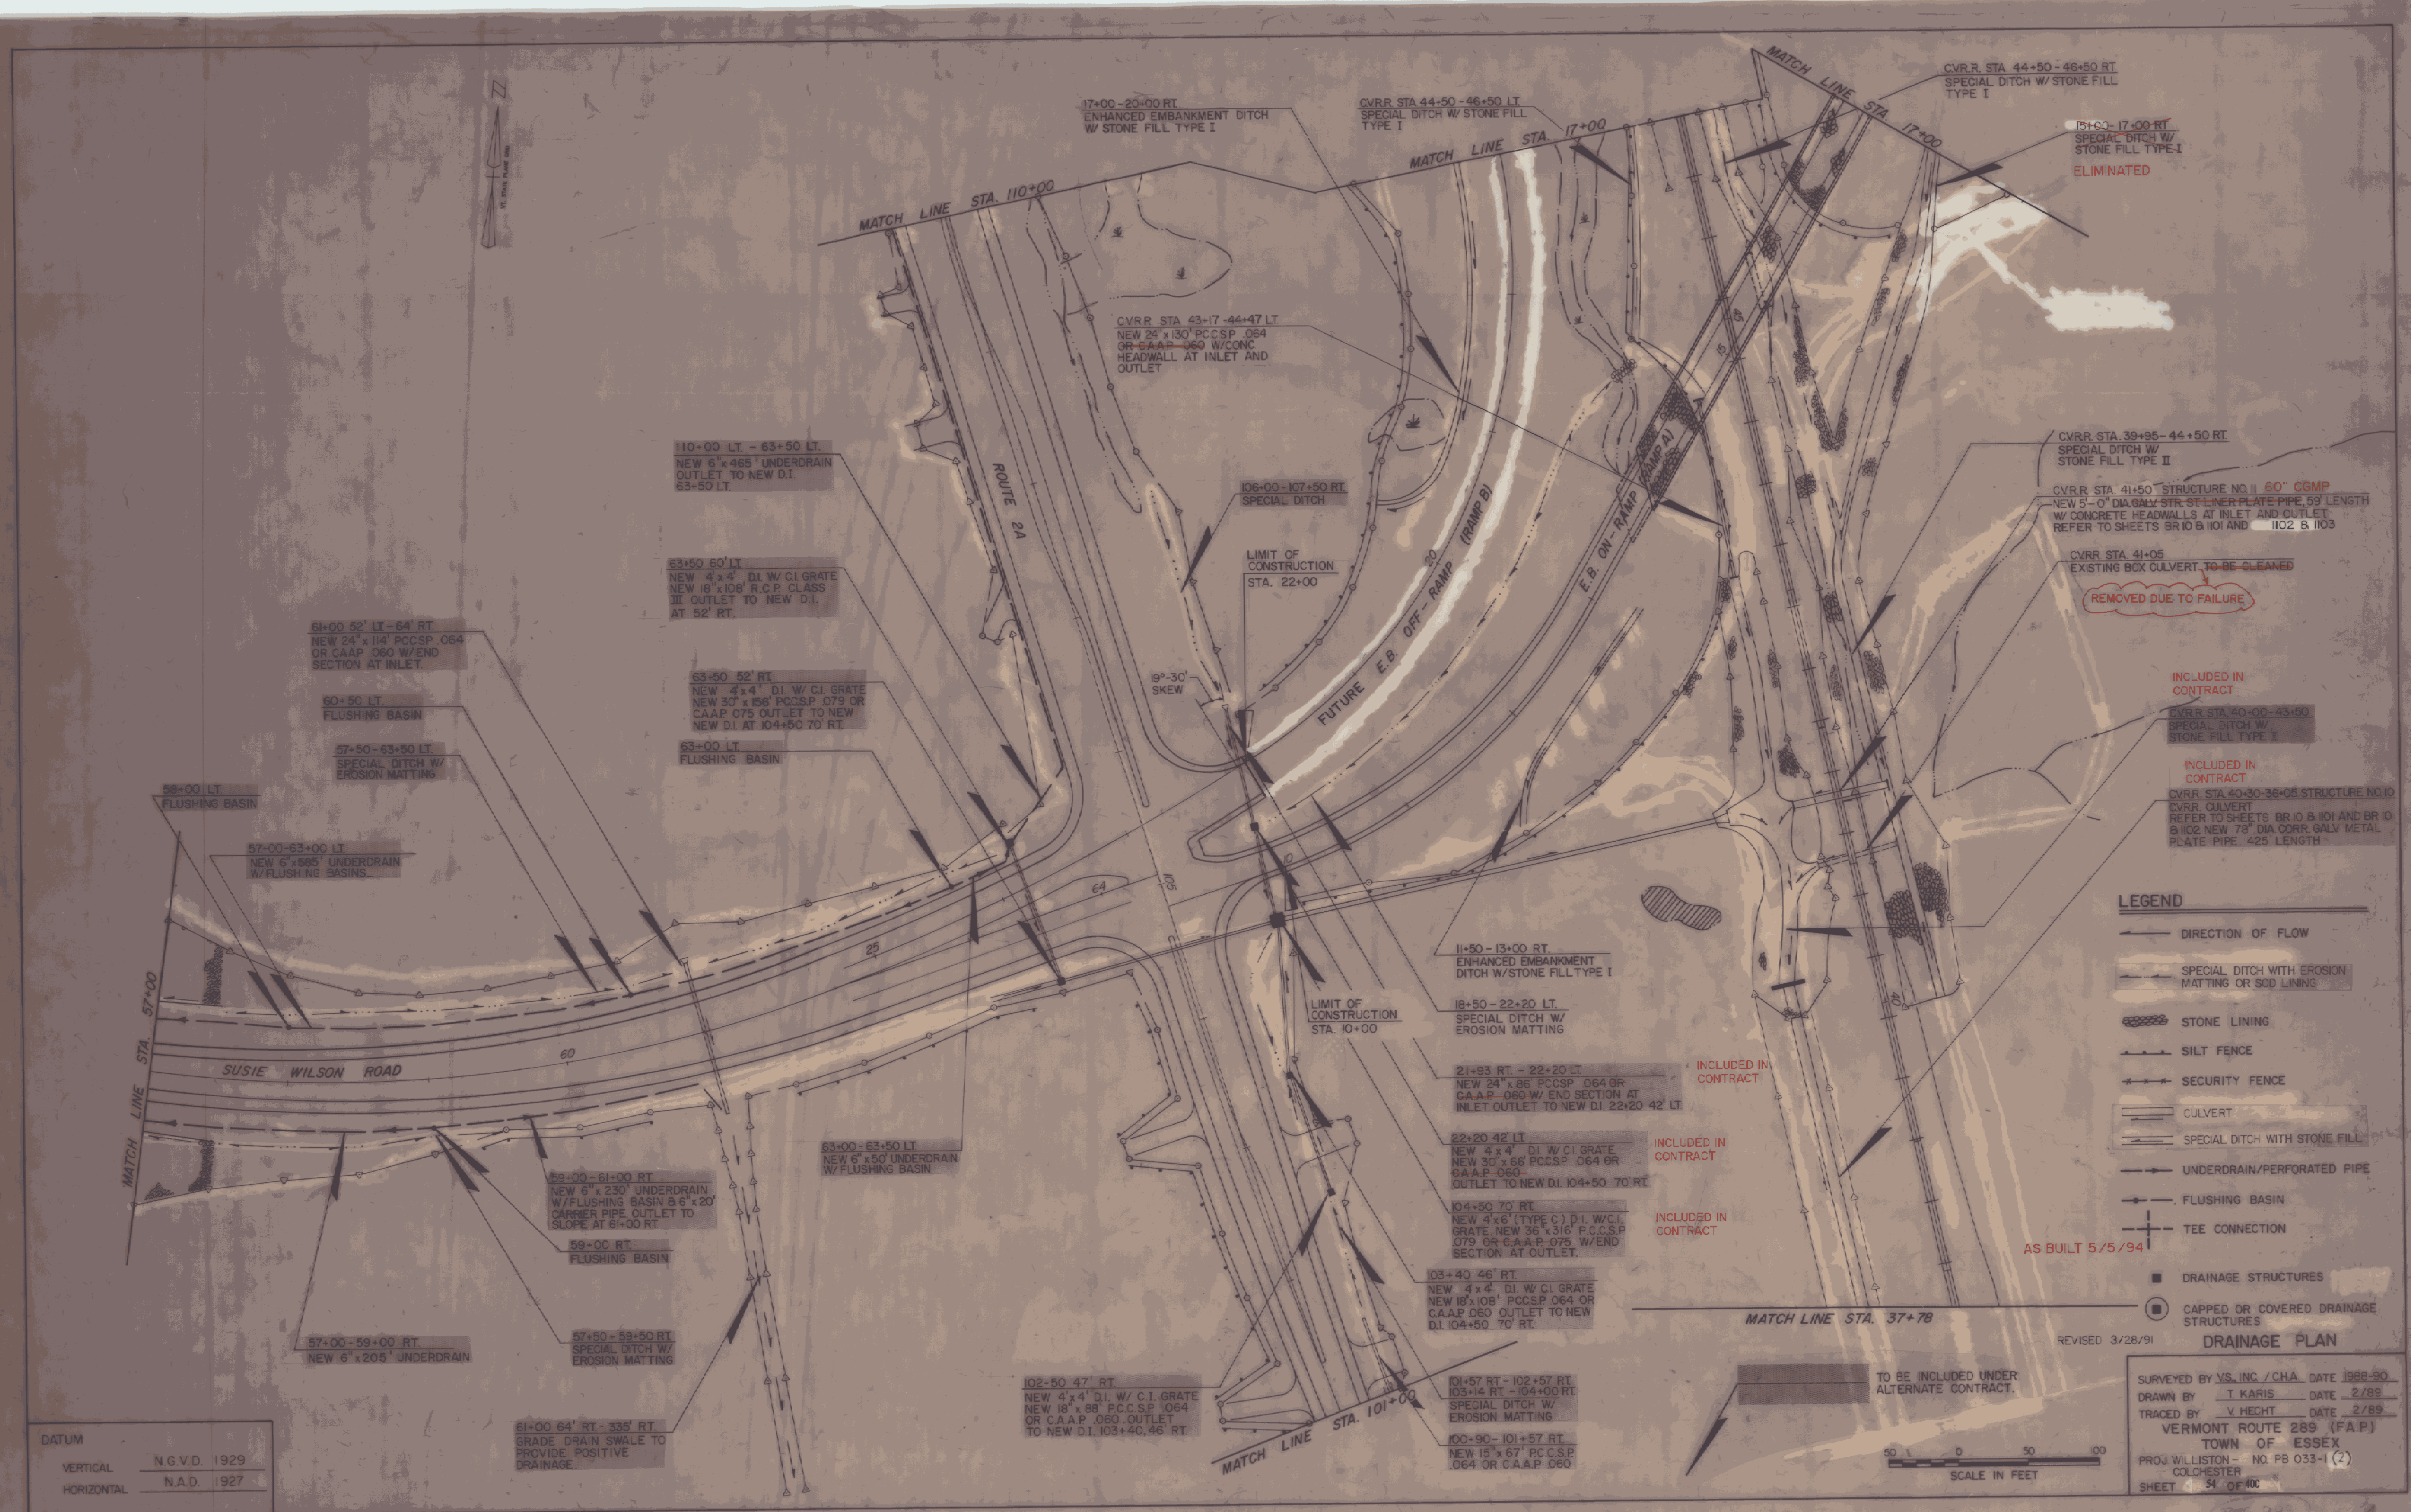

DATUM	
VERTICAL	N.G.V.D. 1929
HORIZONTAL	N.A.D. 1927

LEGEND

- DIRECTION OF FLOW
- SPECIAL DITCH WITH EROSION MATTING OR SOD LINING
- STONE LINING
- SILT FENCE
- SECURITY FENCE
- CULVERT
- SPECIAL DITCH WITH STONE FILL
- UNDERDRAIN/PERFORATED PIPE
- FLUSHING BASIN
- TEE CONNECTION
- AS BUILT 5/5/94
- DRAINAGE STRUCTURES
- CAPPED OR COVERED DRAINAGE STRUCTURES

DRAINAGE PLAN

SURVEYED BY VS, INC. / CHA. DATE 1988-90
DRAWN BY T. KARIS DATE 2/89
TRACED BY V. HECHT DATE 2/89
VERMONT ROUTE 289 (F.A.P.)
TOWN OF ESSEX
PROJ WILLISTON - NO. PB 033-1 (2)
COLCHESTER
SHEET 34 OF 400