


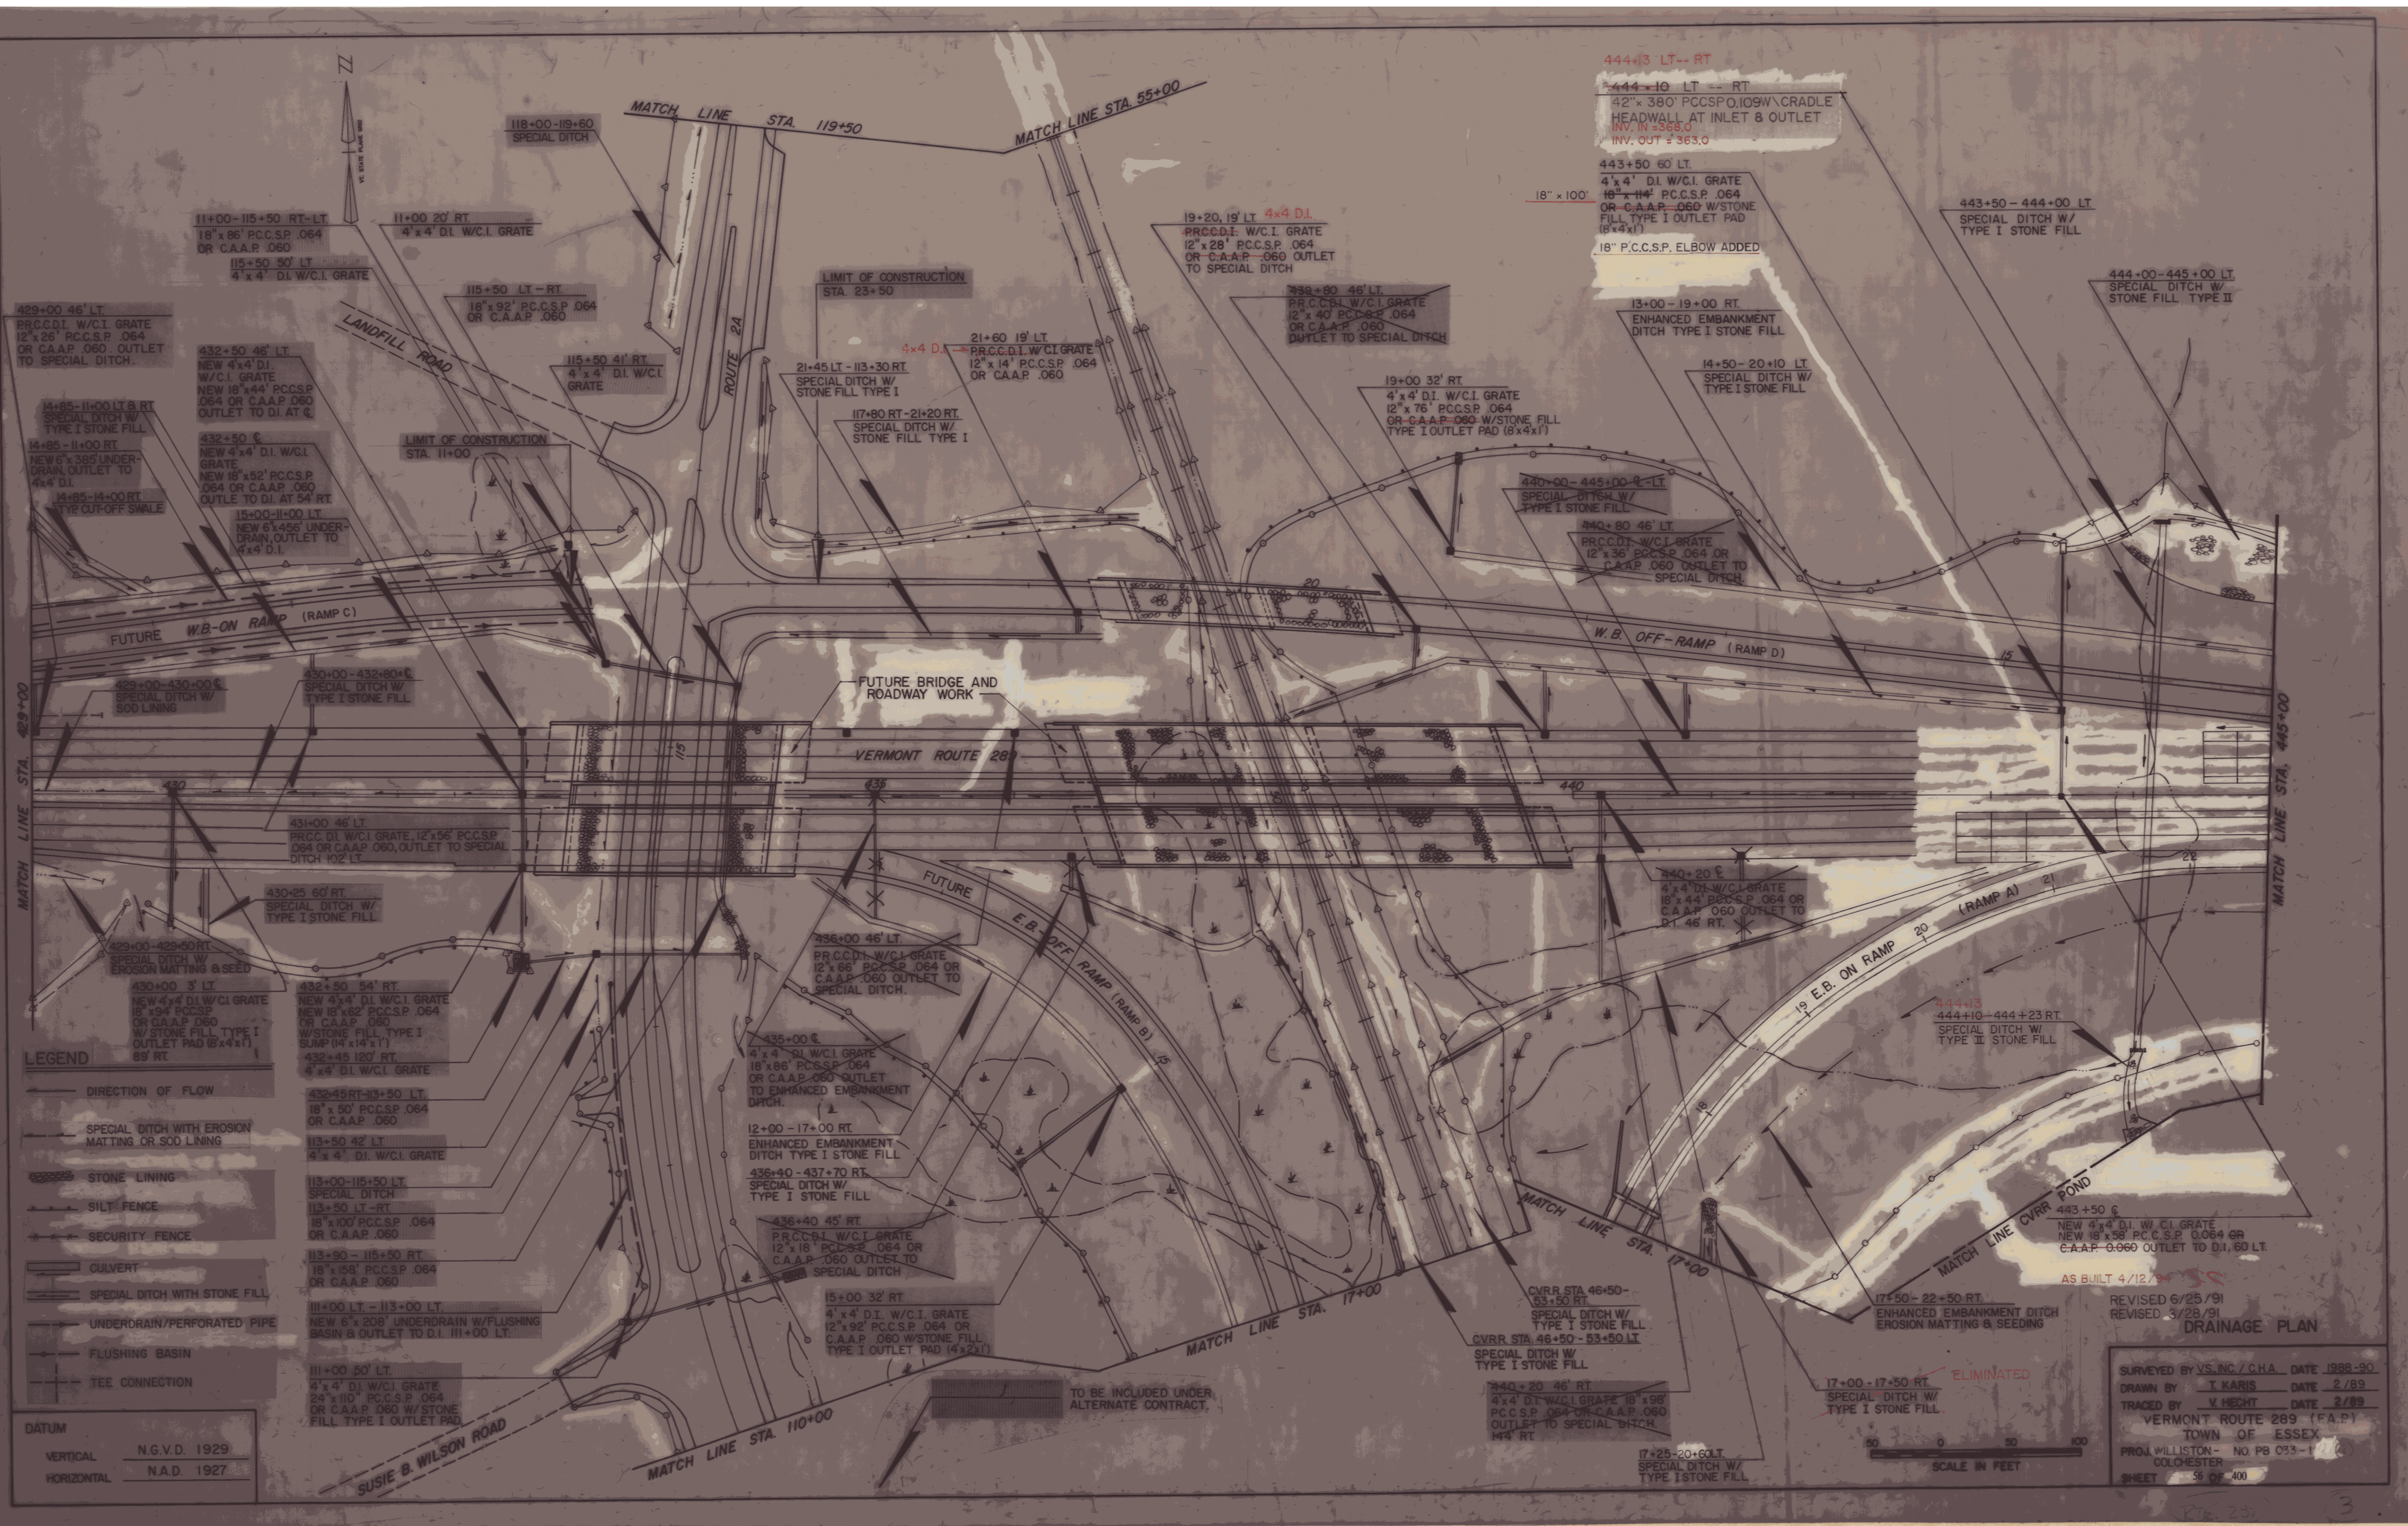

LEGEND

- DIRECTION OF FLOW
- SPECIAL DITCH WITH EROSION MATTING OR SOD LINING
- STONE LINING
- SILT FENCE
- SECURITY FENCE
- CULVERT
- SPECIAL DITCH WITH STONE FILL
- UNDERDRAIN/PERFORATED PIPE
- FLUSHING BASIN
- TEE CONNECTION
- DATUM
- VERTICAL N.G.V.D. 1929
- HORIZONTAL N.A.D. 1927

REVISOR 6/25/91  
REVISOR 3/28/91  
DRAINAGE PLAN  
SURVEYED BY V.S. INC./C.H.A. DATE 1988-90  
DRAWN BY T. K. R. S. DATE 2/89  
TRACED BY V. HECHT DATE 2/89  
VERMONT ROUTE 289 (F.A.P.)  
TOWN OF ESSEX  
PROJ. WILLISTON - NO. PB 033-1  
SHEET 39 OF 400