


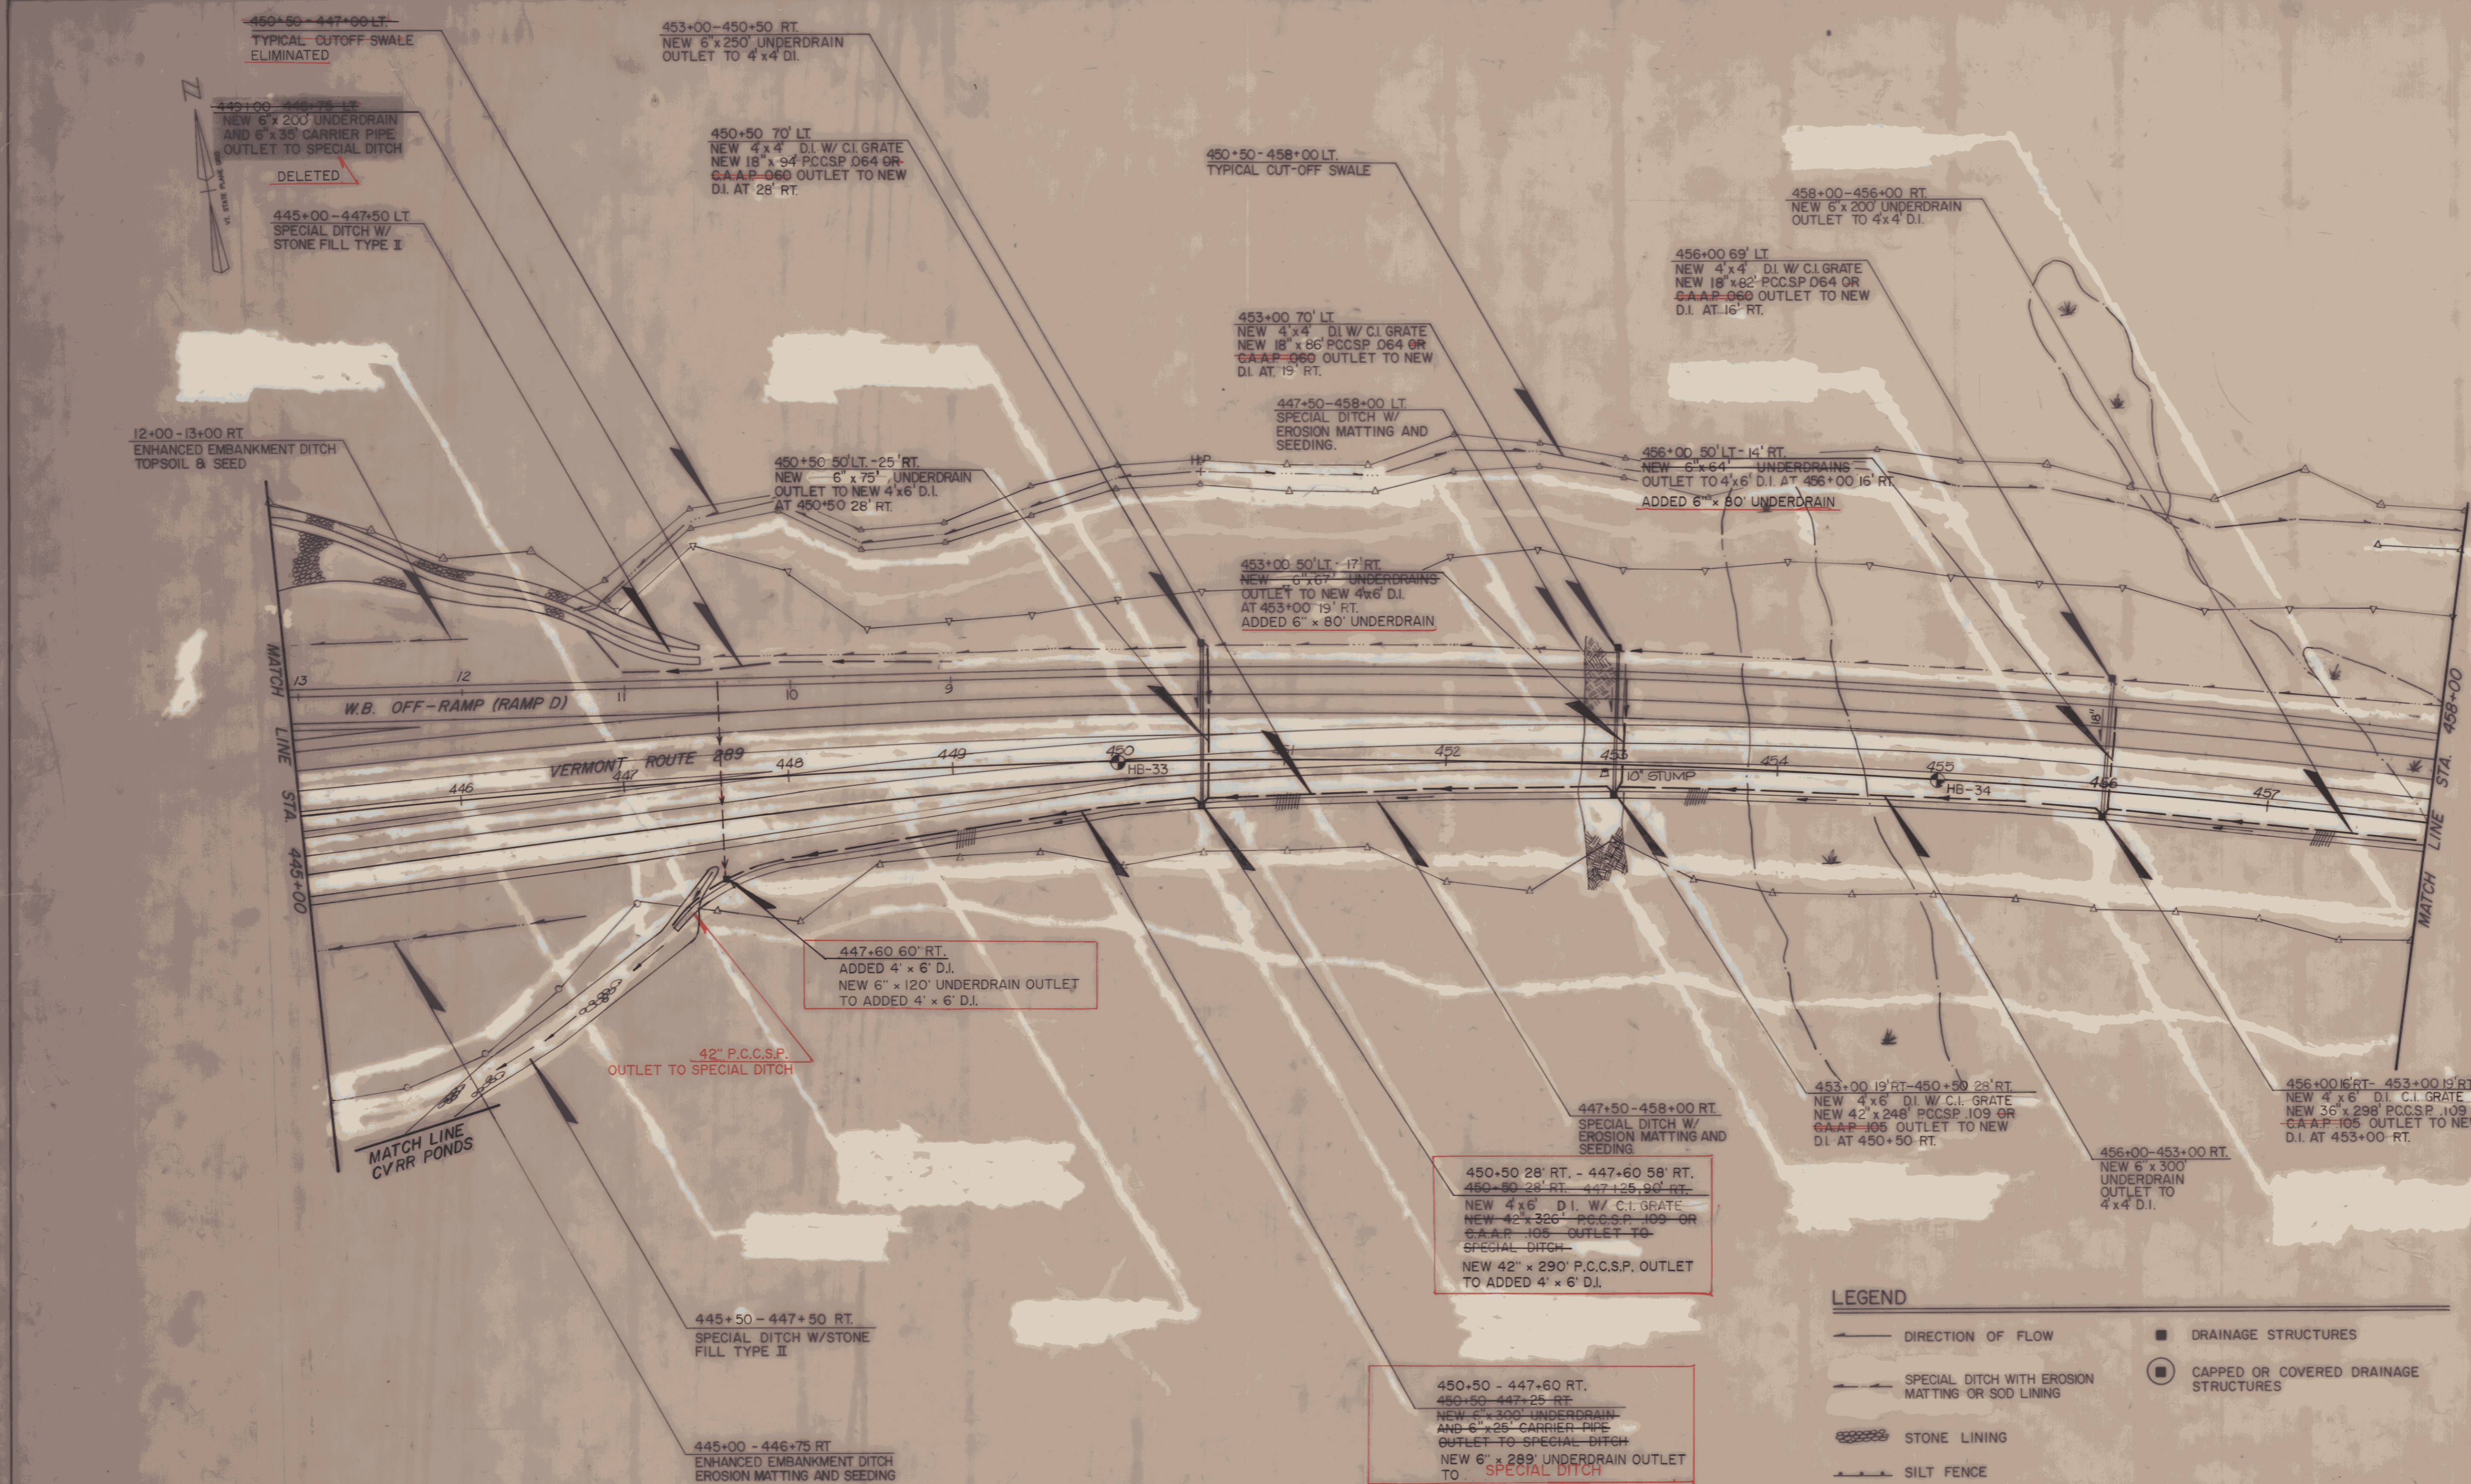

DATUM
VERTICAL N.G.V.D. 1929
HORIZONTAL N.A.D. 1927

- LEGEND**
- DIRECTION OF FLOW
 - SPECIAL DITCH WITH EROSION MATTING OR SOD LINING
 - STONE LINING
 - SILT FENCE
 - SECURITY FENCE
 - CULVERT
 - SPECIAL DITCH WITH STONE FILL
 - UNDERDRAIN/PERFORATED PIPE
 - FLUSHING BASIN
 - TEE CONNECTION
 - DRAINAGE STRUCTURES
 - CAPPED OR COVERED DRAINAGE STRUCTURES

50 0 50 100
SCALE IN FEET

AS BUILT 4/12/94
SC 36 8/1/94

REVISED 2/28/91
DRAINAGE PLAN

SURVEYED BY VS, INC./C.H.A. DATE 1988-90
DRAWN BY T. KARIS DATE 2/89
TRACED BY V. HECHT DATE 2/89
VERMONT ROUTE 289 (FA.R)
TOWN OF ESSEX
PROJ WILLISTON - NO. PB 033-1 (2)
COLCHESTER
SHEET 58 OF 400

716 233 7