



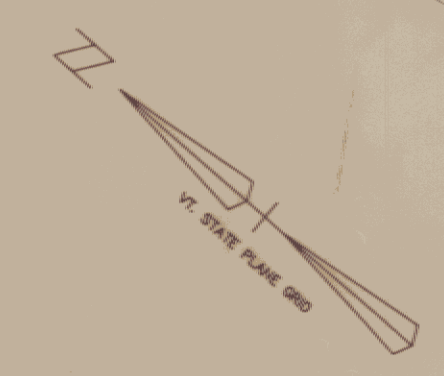

519+00 TO 520+00 LT.
CONSTRUCT SPECIAL
DITCH 4' WIDE
(NOT INCLUDED IN ESTIMATE)

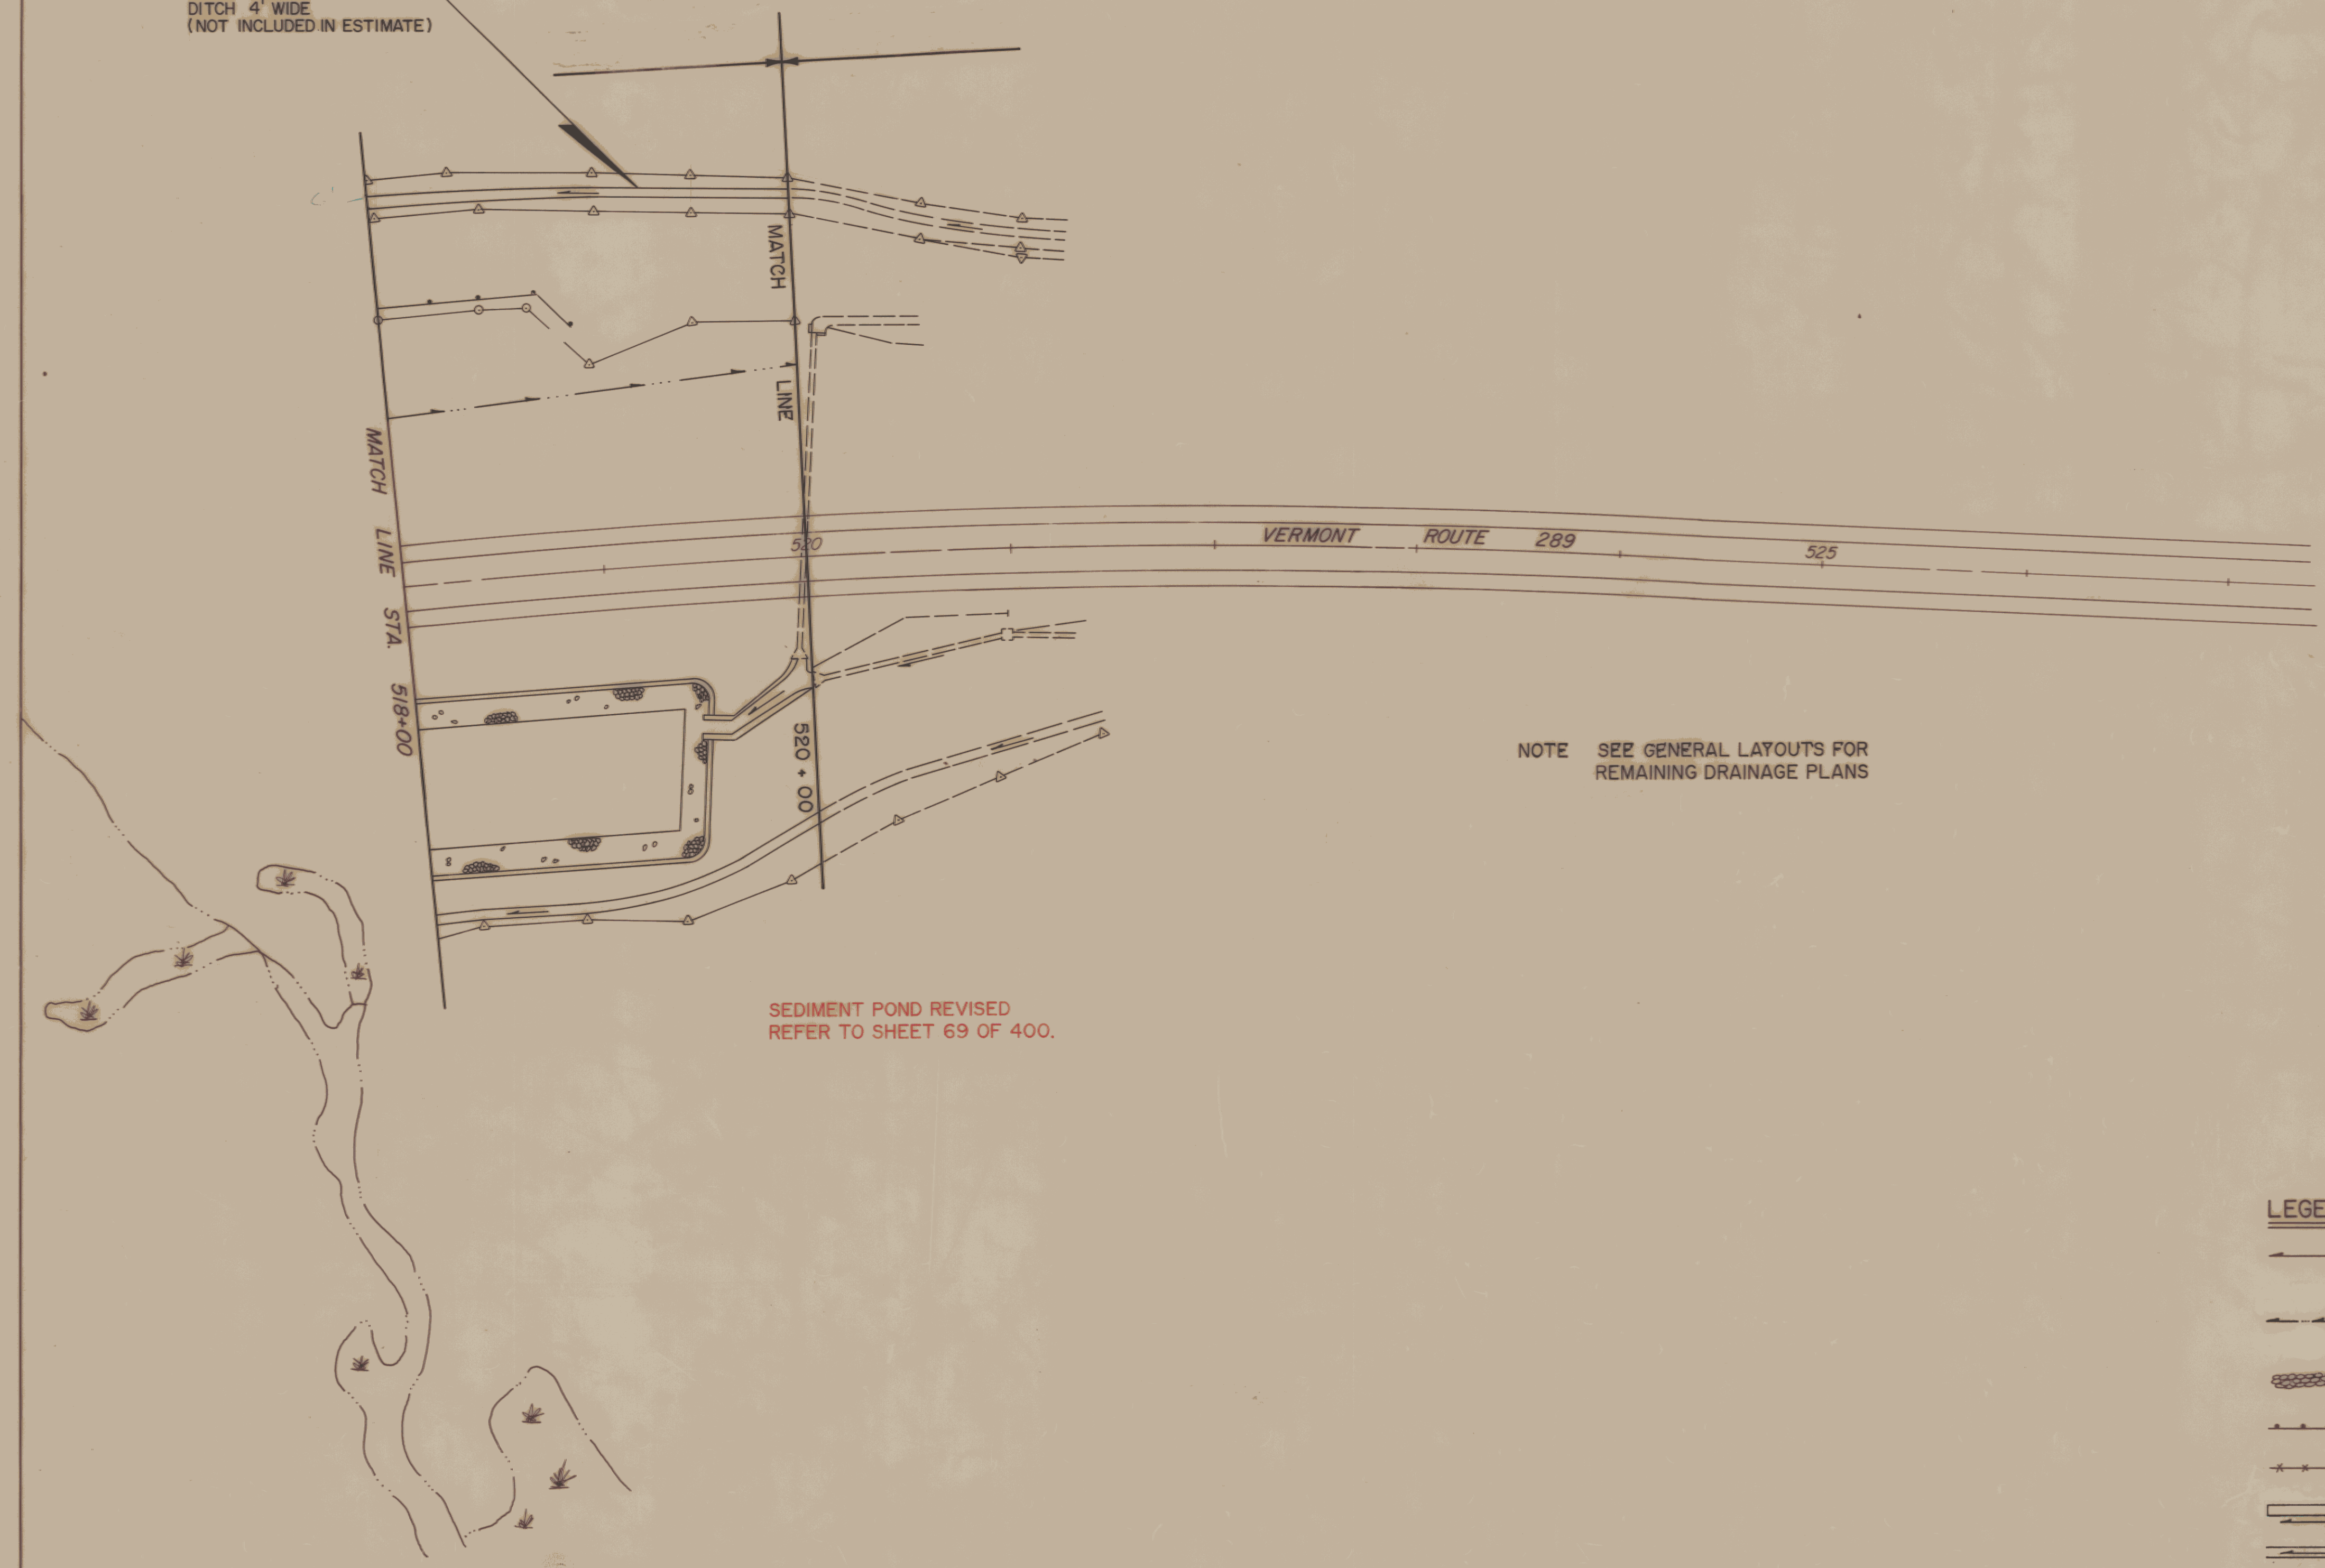


SEDIMENT POND REVISED
REFER TO SHEET 69 OF 400.

NOTE SEE GENERAL LAYOUTS FOR
REMAINING DRAINAGE PLANS

LEGEND

- DIRECTION OF FLOW
- SPECIAL DITCH WITH EROSION
MATTING OR SOD LINING
- STONE LINING
- SILT FENCE
- SECURITY FENCE
- CULVERT
- SPECIAL DITCH WITH STONE FILL
- UNDERDRAIN/PERFORATED PIPE
- FLUSHING BASIN
- TEE CONNECTION
- DRAINAGE STRUCTURES
- CAPPED OR COVERED DRAINAGE
STRUCTURES

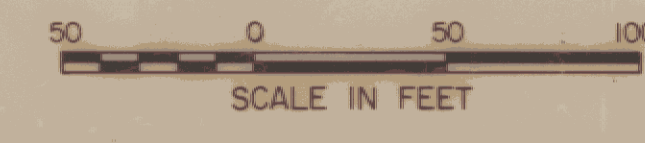

DATUM	
VERTICAL	N.G.V.D. 1929
HORIZONTAL	N.A.D. 1927

AS BUILT 5/4/94

DRAINAGE PLAN

SURVEYED BY VS, INC. / C.H.A. DATE 1988-90
DRAWN BY T. KARIS DATE 2/89
TRACED BY V. HECHT DATE 2/89
VERMONT ROUTE 289 (F.A.R.)
TOWN OF ESSEX
PROJ. WILLISTON - NO. PB 033-1(2)
COLCHESTER
SHEET 68 OF 400

17

17C 289

12