


PLAN	
SURVEYED	BY
NOTE BOOK	NO.
GRADES CHECKED	
RT. OF WAY CHECKED	

PROFILE	
SURVEYED	BY
NOTE BOOK	NO.
GRADES CHECKED	
PROCEDURE NOTATION CHECKED	

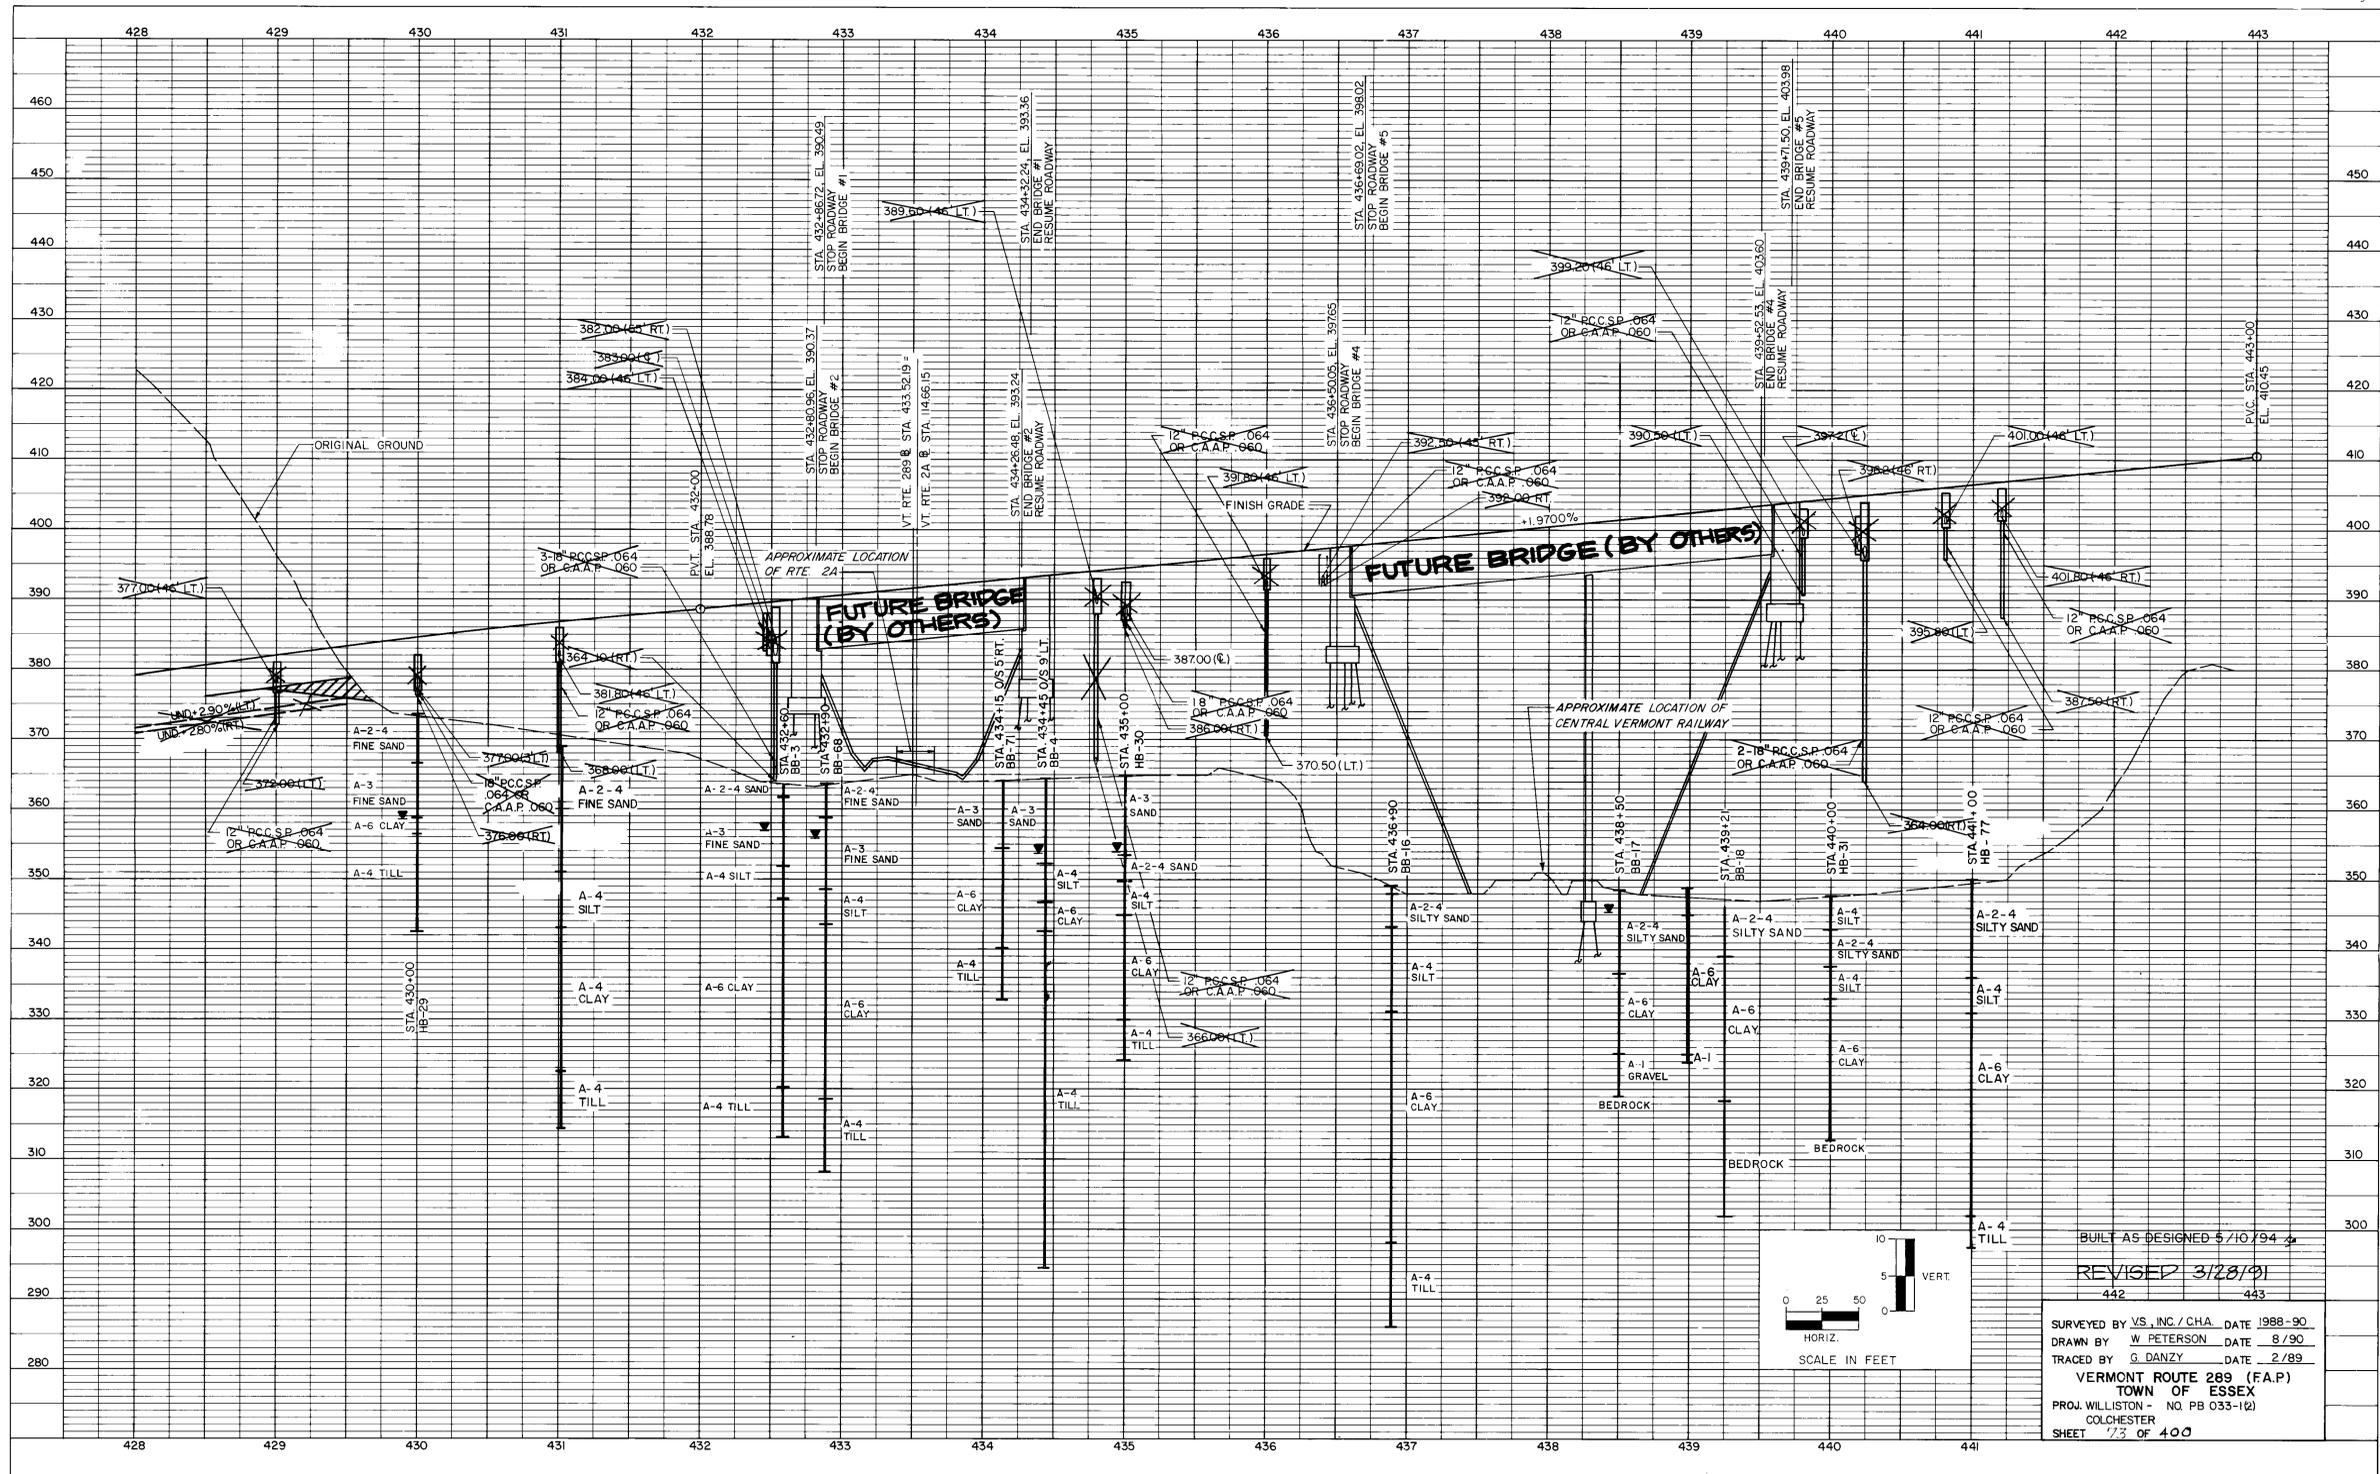

BUILT AS DESIGNED 5/10/94
 REVISED 3/28/91
 442 443
 SURVEYED BY VS, INC / CHA DATE 1988-90
 DRAWN BY W. PETERSON DATE 8/90
 TRACED BY G. DANZY DATE 2/89
 VERMONT ROUTE 289 (F.A.P.)
 TOWN OF ESSEX
 PROJ. WILLISTON - NO. PB 033-12
 COLCHESTER
 SHEET 1/3 OF 400