

PLAN	REVISED	BY	DATE
	NO. _____	_____	_____
ALIGNED CHECKED			
PI. UP. W. DESIGNED			

PROFILE	REVISED	BY	DATE
	NO. _____	_____	_____
GRADES CHECKED			
STRUCTURE NOTATIONS CHYD			

BRUNING 2/22/90



STA. 442+50 MEDIAN @ P.O.C. 22' RT. (ELEV. 409.46) =  
STA. 442+50 L.E.B. CROSSOVER (ELEV. 409.46)

PVC STA. 444+00  
EL. 412.42

PVI STA. 446+50  
ELEV. 417.34

PVT STA. 449+00  
EL. 427.55

STA. 451+44.48 MEDIAN @ P.O.C. 5' RT. (ELEV. 451.89) =  
STA. 451+44.48 L.E.B. CROSSOVER (ELEV. 451.89) =  
STA. 451+44.48 W.S. ROUTE 289 RT. 27' (ELEV. 451.19)

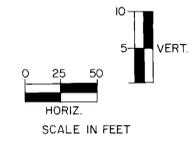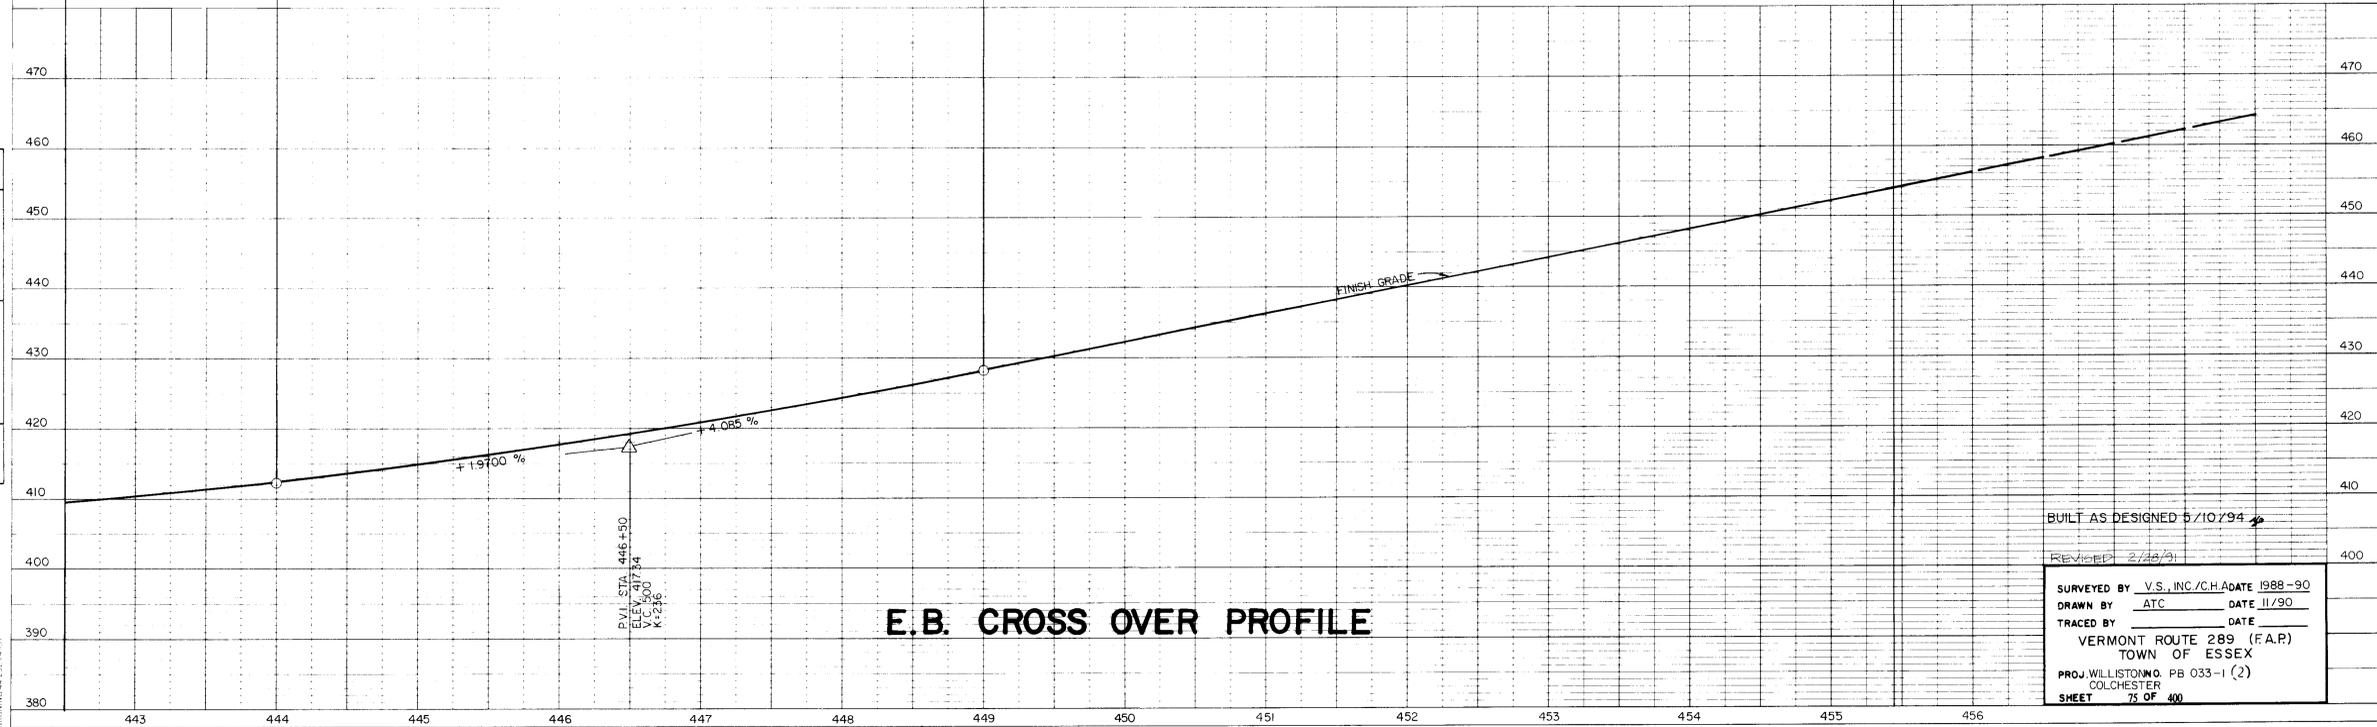

BUILT AS DESIGNED 5/10/94

REVISION 2/28/91

SURVEYED BY	V.S. INC./C.H. ADAMS	DATE	1988-90
DRAWN BY	ATC	DATE	11/90
TRACED BY		DATE	
VERMONT ROUTE 289 (F.A.P.)			
TOWN OF ESSEX			
PROJ. WILLISTON RD. PB 033-1 (2)			
COLCHESTER			
SHEET 15 OF 400			