



PLAN
 SURVEYED BY: _____
 PLOTTED BY: _____
 DATE: _____
 CHECKED BY: _____
 DATE: _____
 NO. _____

PROFILE
 SURVEYED BY: _____
 PLOTTED BY: _____
 DATE: _____
 CHECKED BY: _____
 DATE: _____
 NO. _____

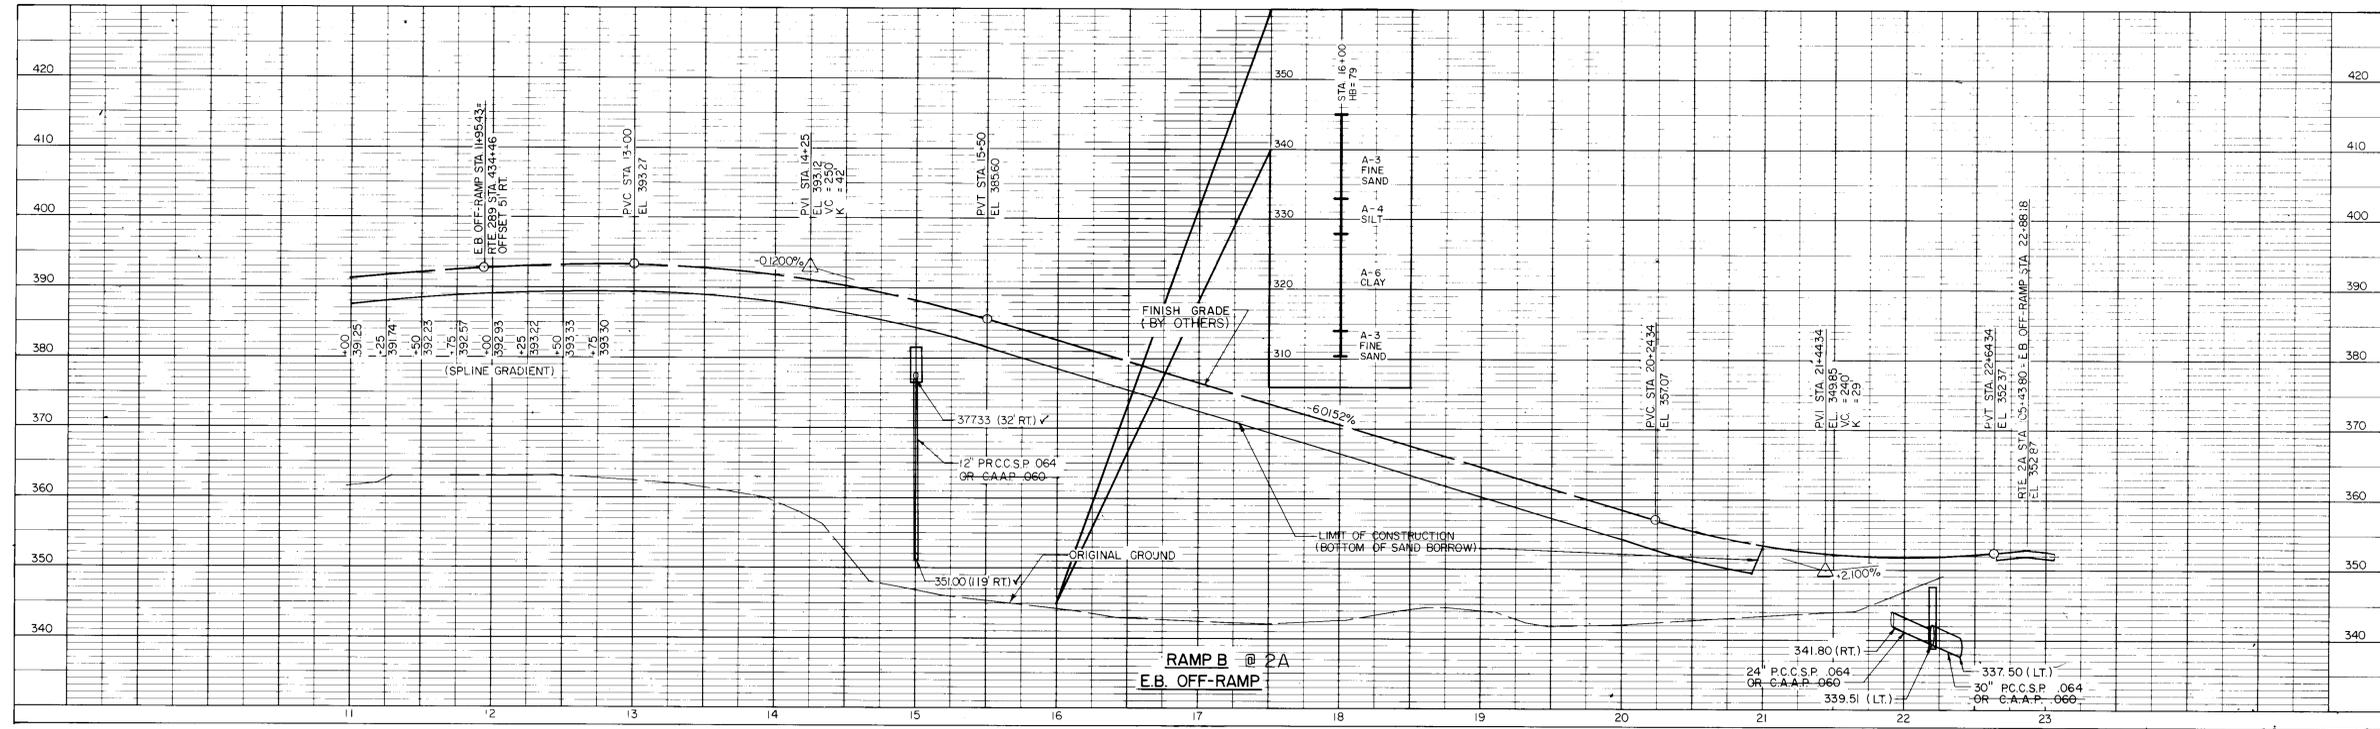

DATUM
 VERTICAL N.G.V.D. 1929
 HORIZONTAL N.A.D. 1927

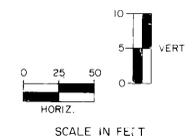

AS BUILT 5/9/94
 REVISED 3/28/31
 SURVEYED BY V.S., INC./C.H.A. DATE 1988-90
 DRAWN BY T. KARIS DATE 2/89
 TRACED BY V. HECHT DATE 2/89
 VERMONT ROUTE 289 (FA.P)
 TOWN OF ESSEX
 PROJ WILLISTON NO. PB 033-1 '2)
 COLCHESTER
 SHEET 84 OF 400