

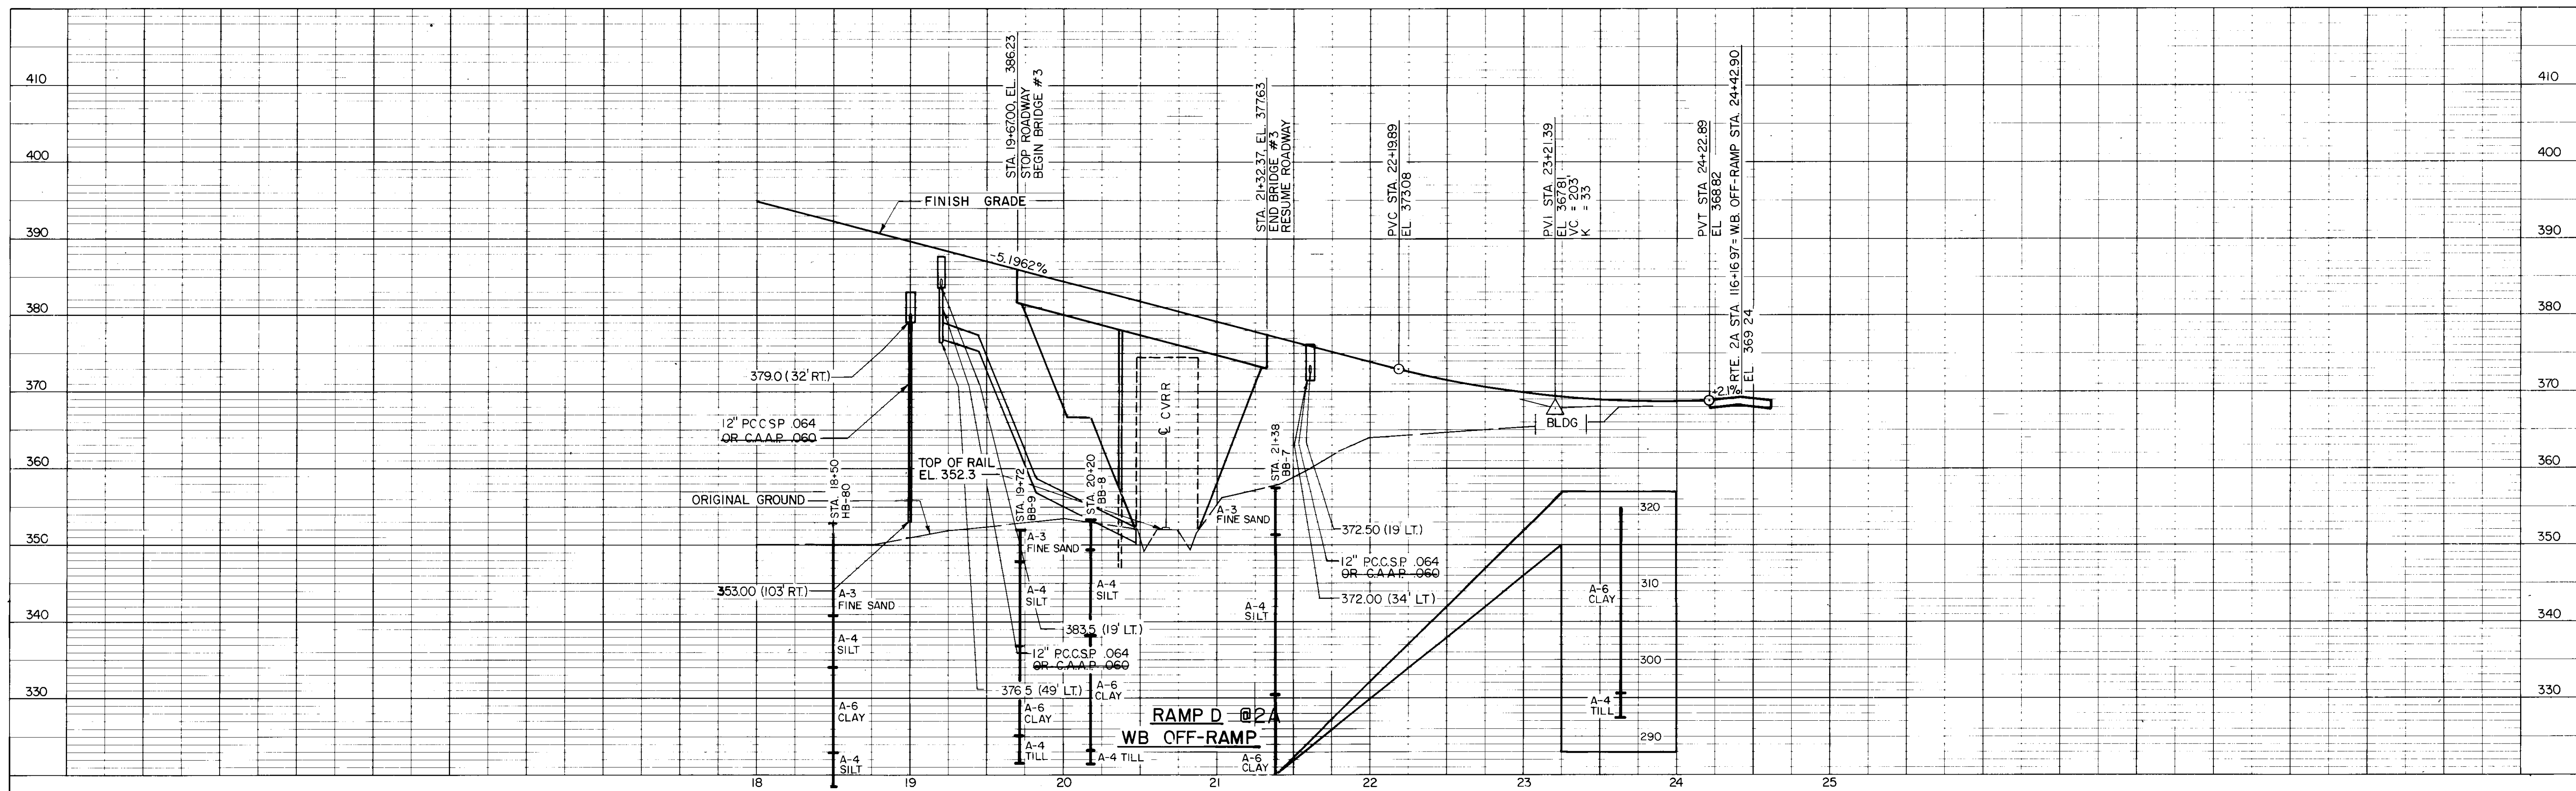


PLAN	DESIGNED	DATE
	BY	
NOTE BOOK	NOTED	
	BY	

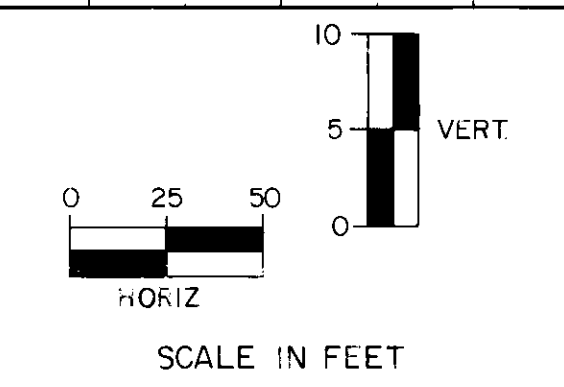

PROFILE	DESIGNED	DATE
	BY	
NOTE BOOK	NOTED	
	BY	

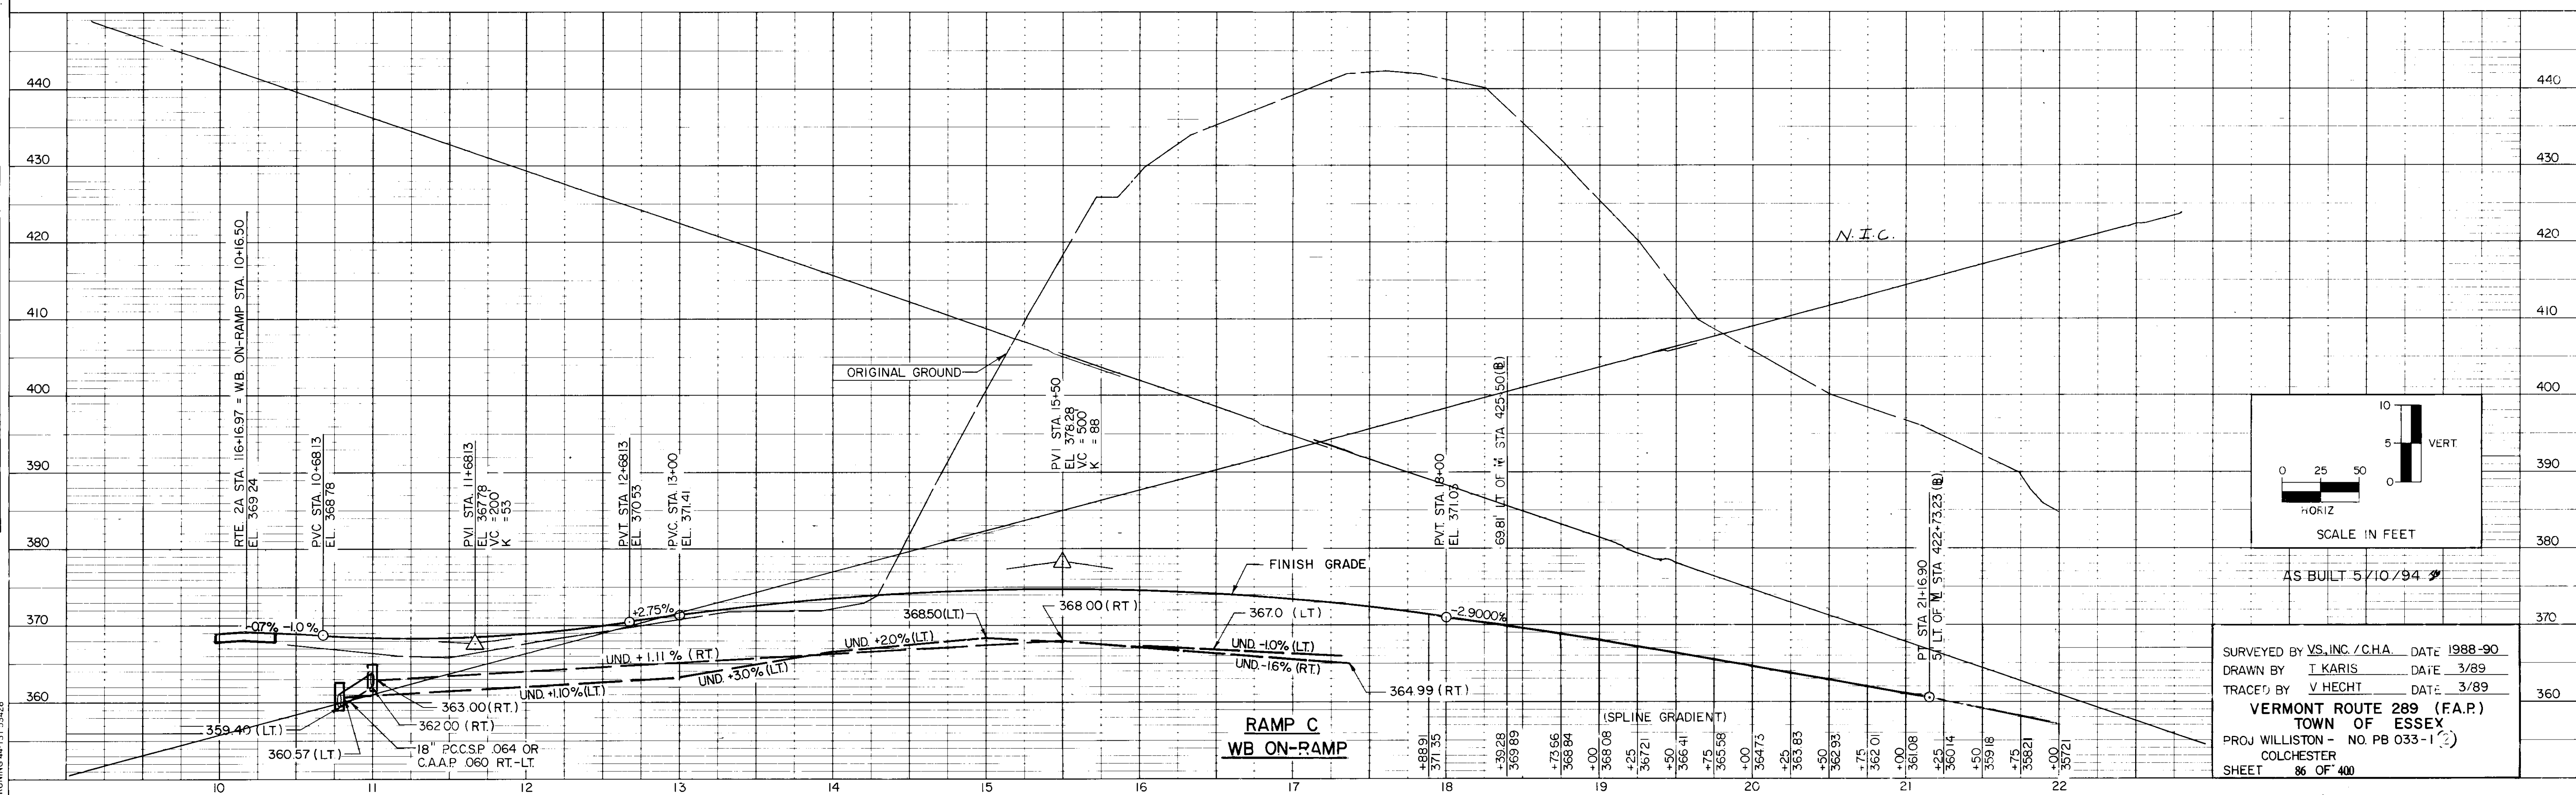

AS BUILT 5/10/94

SURVEYED BY VS, INC. / C.H.A. DATE 1988-90
 DRAWN BY T. KARIS DATE 3/89
 TRACED BY V. HECHT DATE 3/89
 VERMONT ROUTE 289 (F.A.P.)
 TOWN OF ESSEX
 PROJ WILLISTON - NO. PB 033-1
 COLCHESTER
 SHEET 86 OF 400