

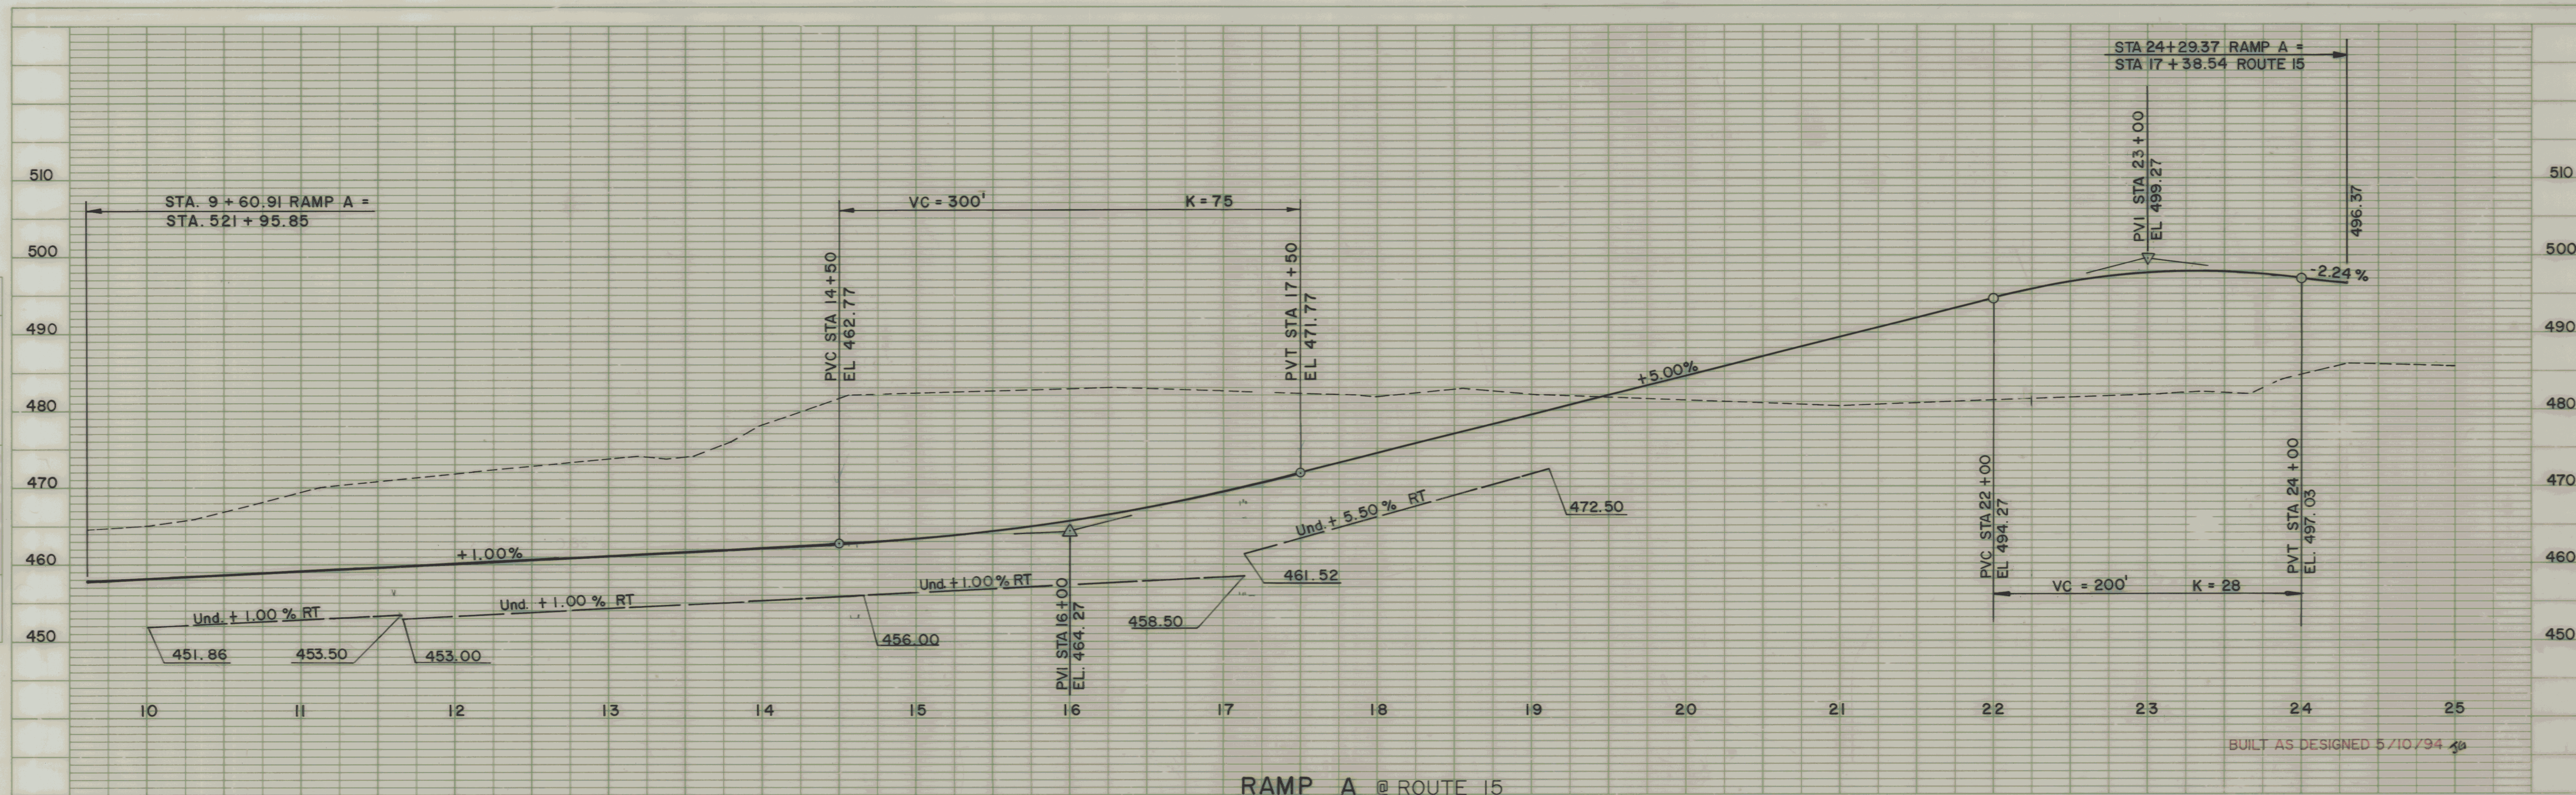


PROFILE	SURVEYED	DATE
NOTE BOOK	PLotted	
NO.	RECORD	
	B.M. & NOTED	
	STRUCTURE NOTATIONS SHOWN	

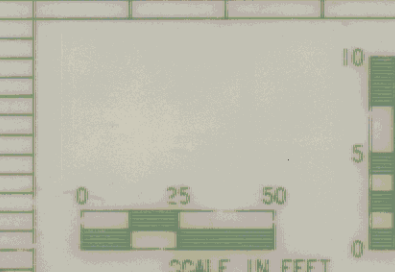

PROFILE	SURVEYED	DATE
NOTE BOOK	PLotted	
NO.	RECORD	
	B.M. & NOTED	
	STRUCTURE NOTATIONS SHOWN	

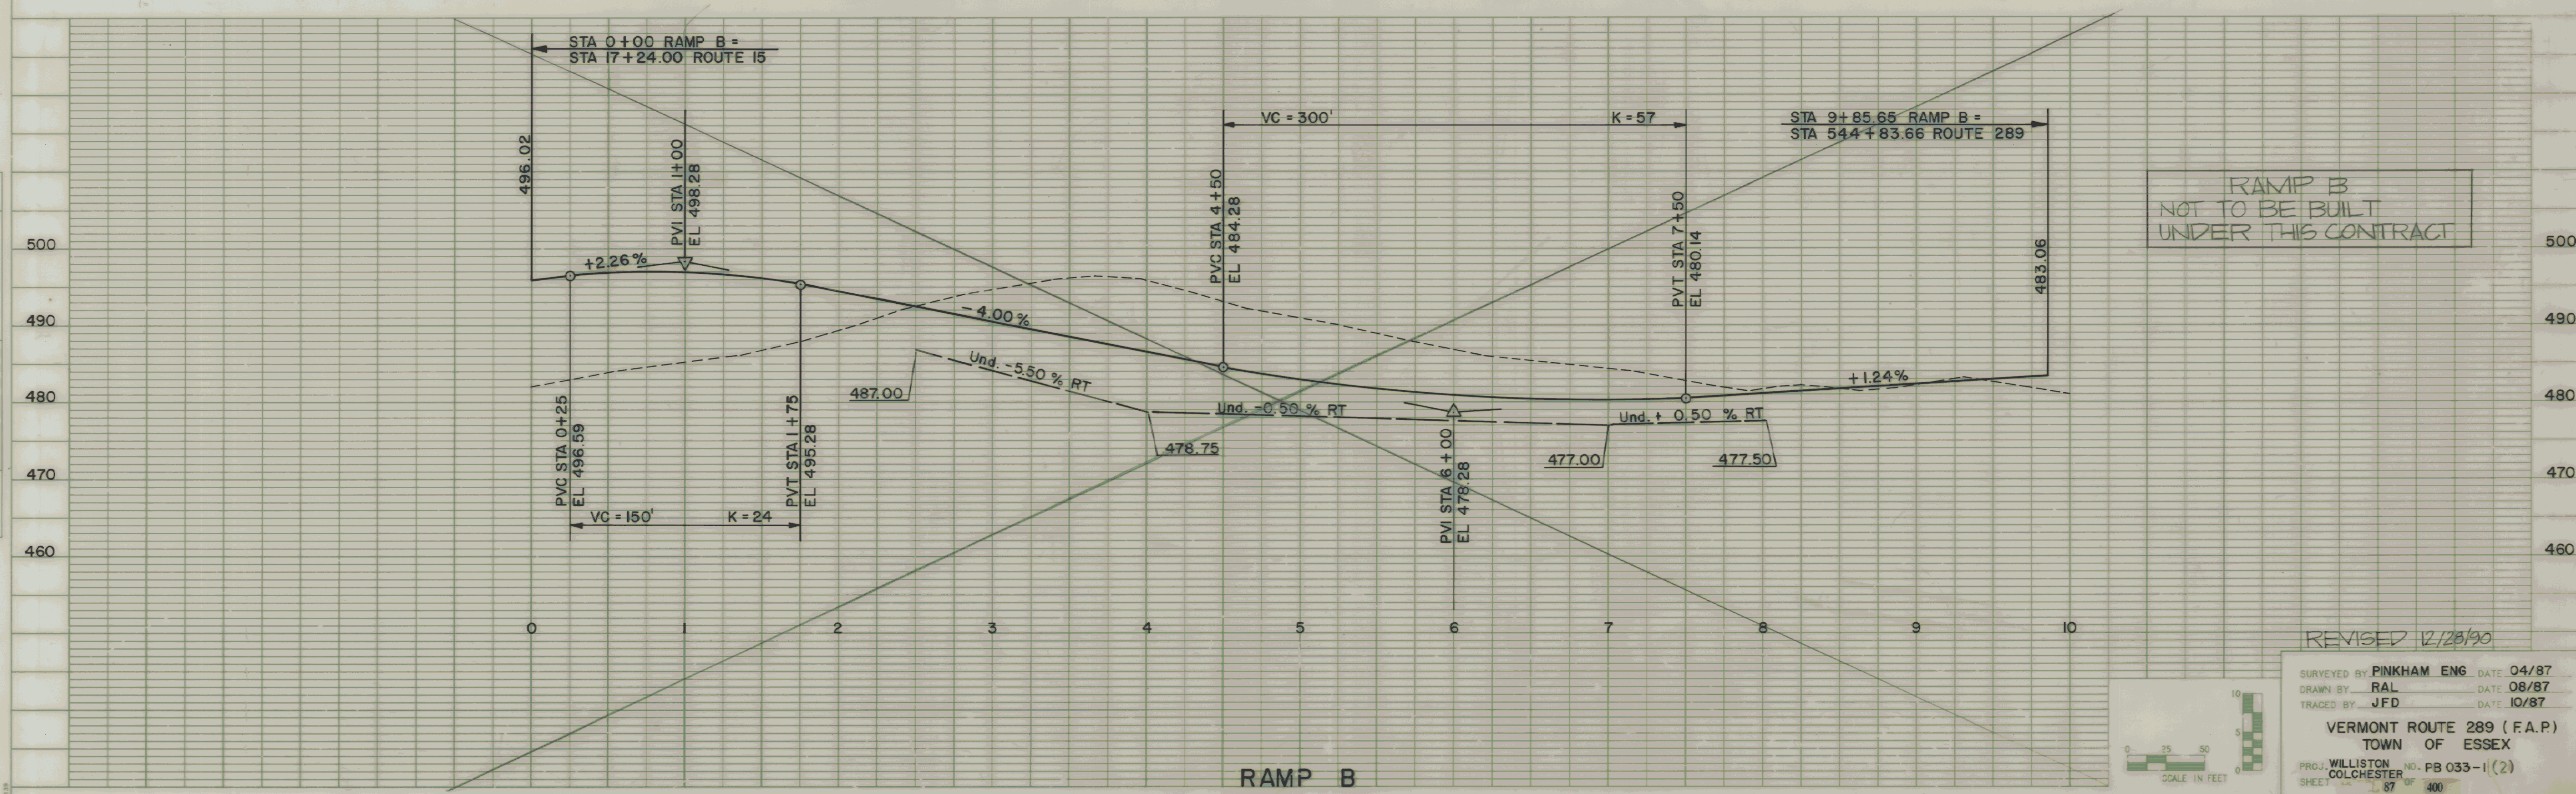

REVISED 12/28/90

SURVEYED BY PINKHAM ENG DATE 04/87
 DRAWN BY RAL DATE 08/87
 TRACED BY JFD DATE 10/87

VERMONT ROUTE 289 (F.A.P.)
 TOWN OF ESSEX

PROJ. WILLISTON NO. PB 033-1(2)
 COLCHESTER OF 400
 SHEET 87

ROUTE 15 INTERCHANGE