



DATE	
BY	
PROF. FILE	
NO.	
DATE	
BY	
PROF. FILE	
NO.	

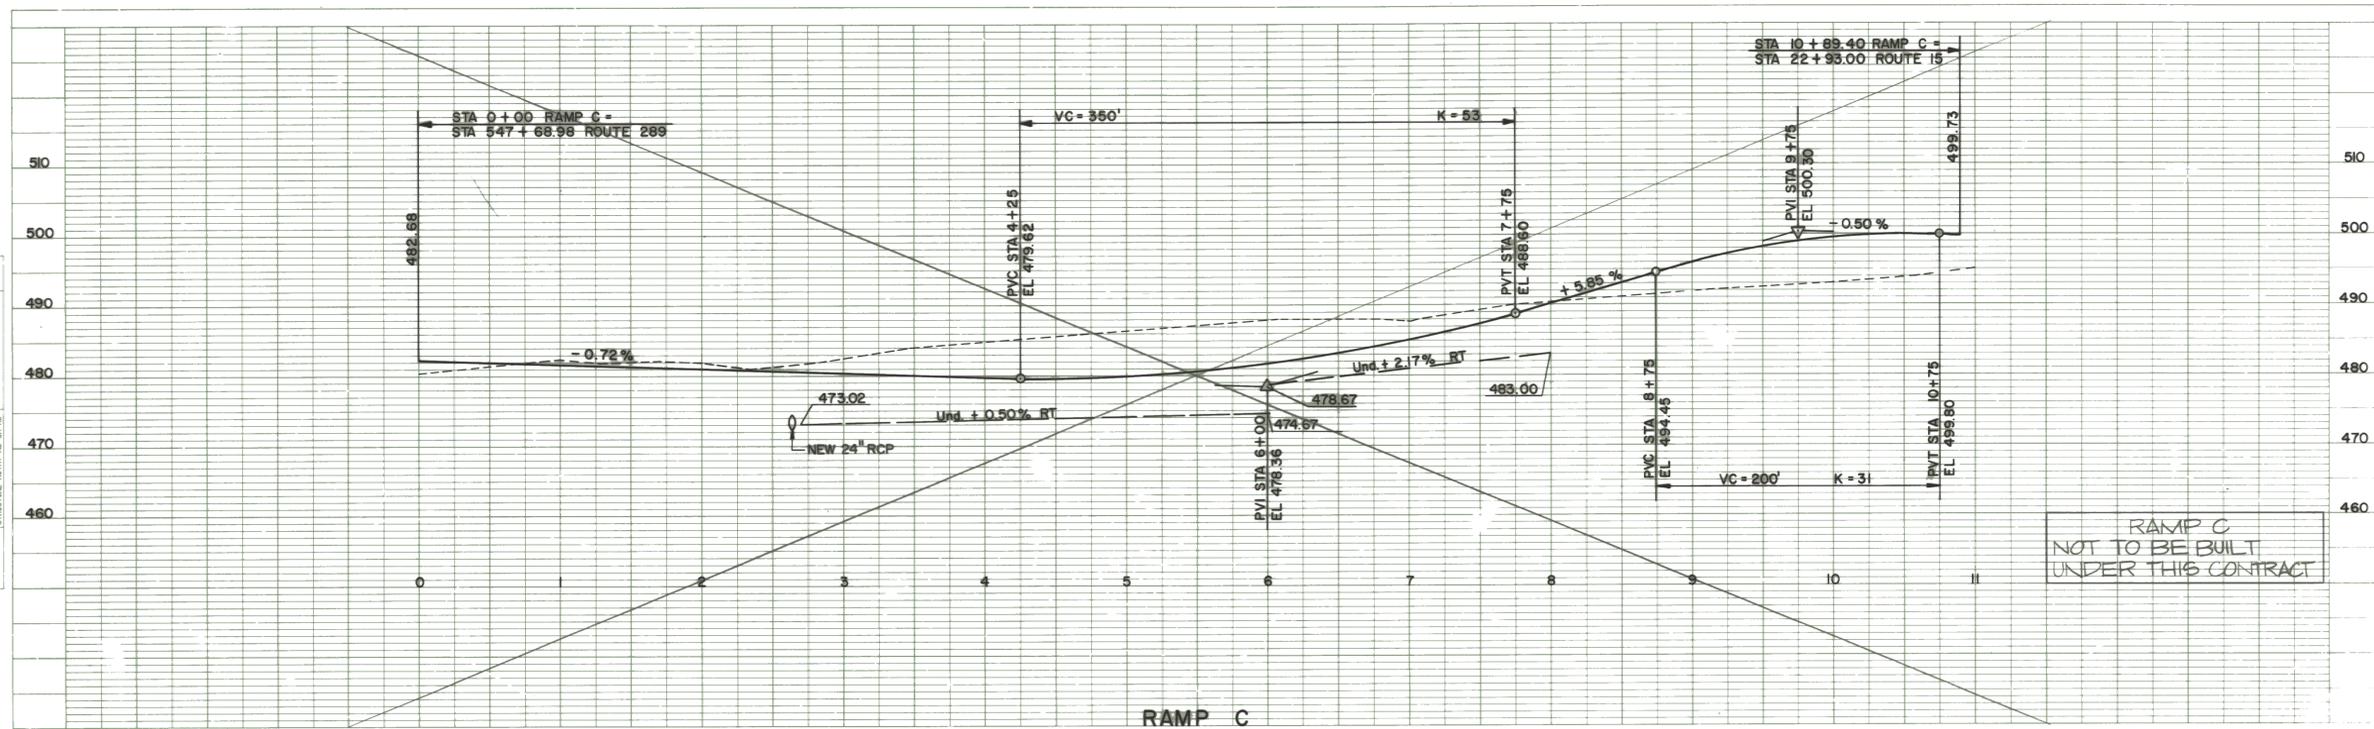


RAMP C
NOT TO BE BUILT
UNDER THIS CONTRACT

DATE	
BY	
PROF. FILE	
NO.	
DATE	
BY	
PROF. FILE	
NO.	

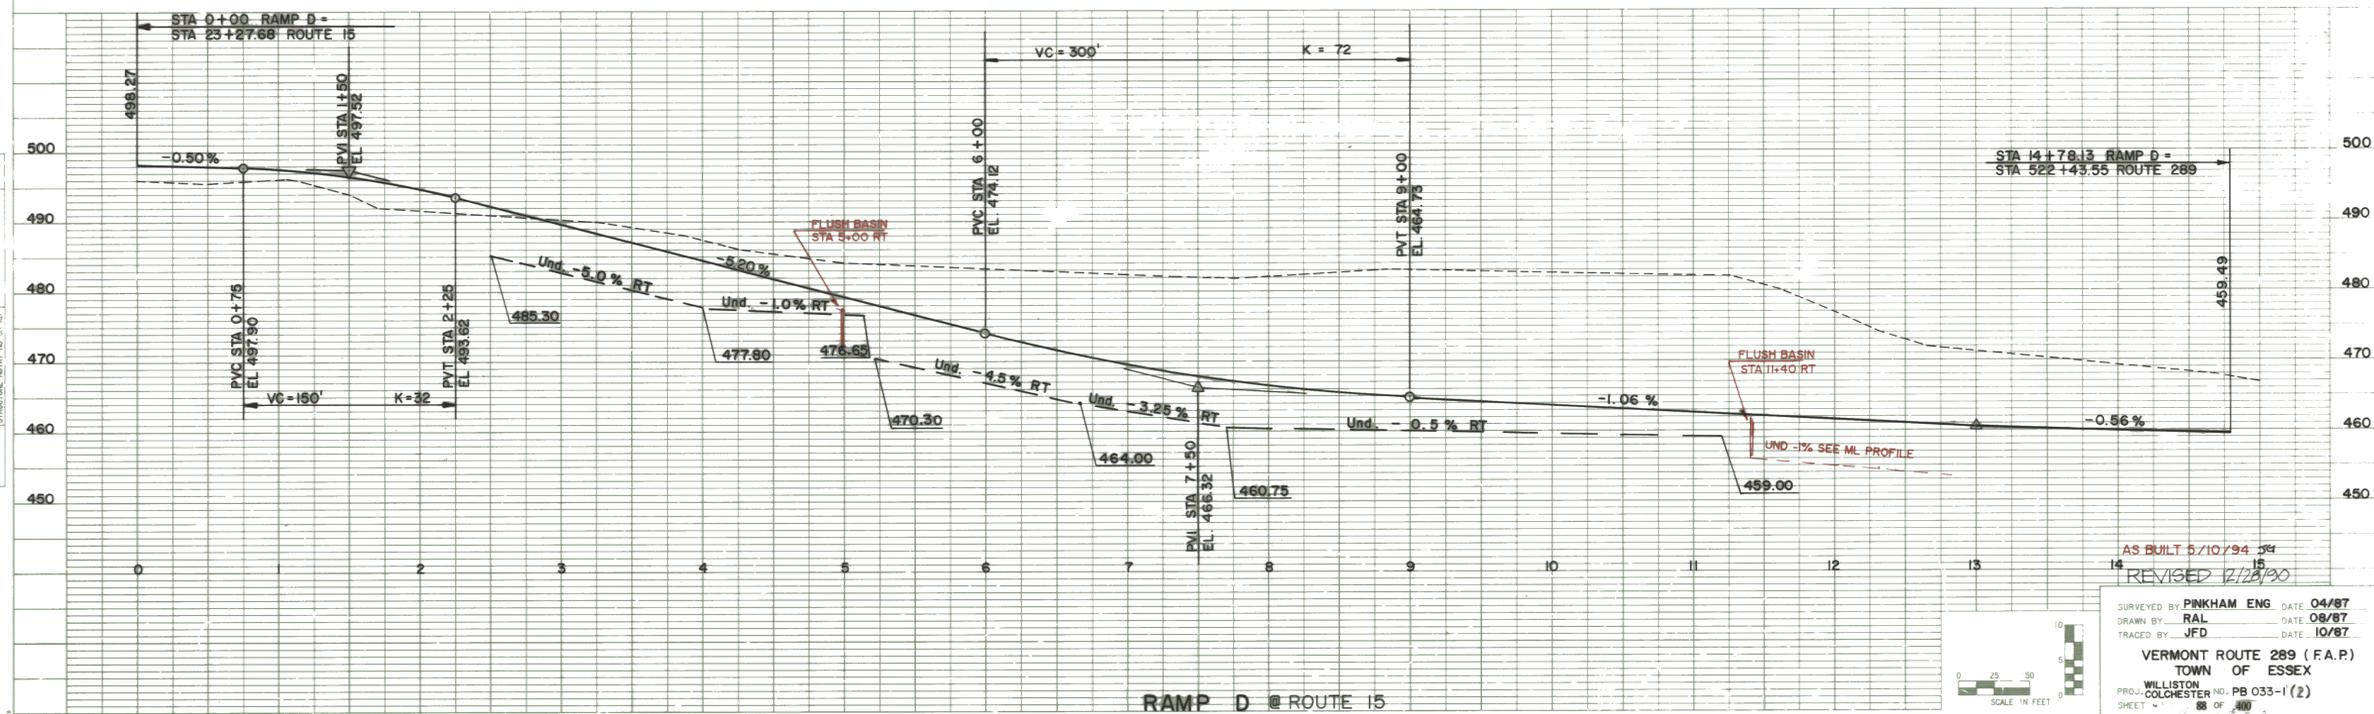

AS BUILT 5/10/94
REVISED 12/28/90

SURVEYED BY: PINKHAM ENG DATE: 04/87
 DRAWN BY: RAL DATE: 08/87
 TRACED BY: JFD DATE: 10/87
 VERMONT ROUTE 289 (F.A.P.)
 TOWN OF ESSEX
 PROJ. WILLISTON NO. PB 033-1 (2)
 COLCHESTER
 SHEET 88 OF 88

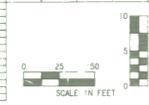

RAMP D @ ROUTE 15

ROUTE 15 INTERCHANGE