

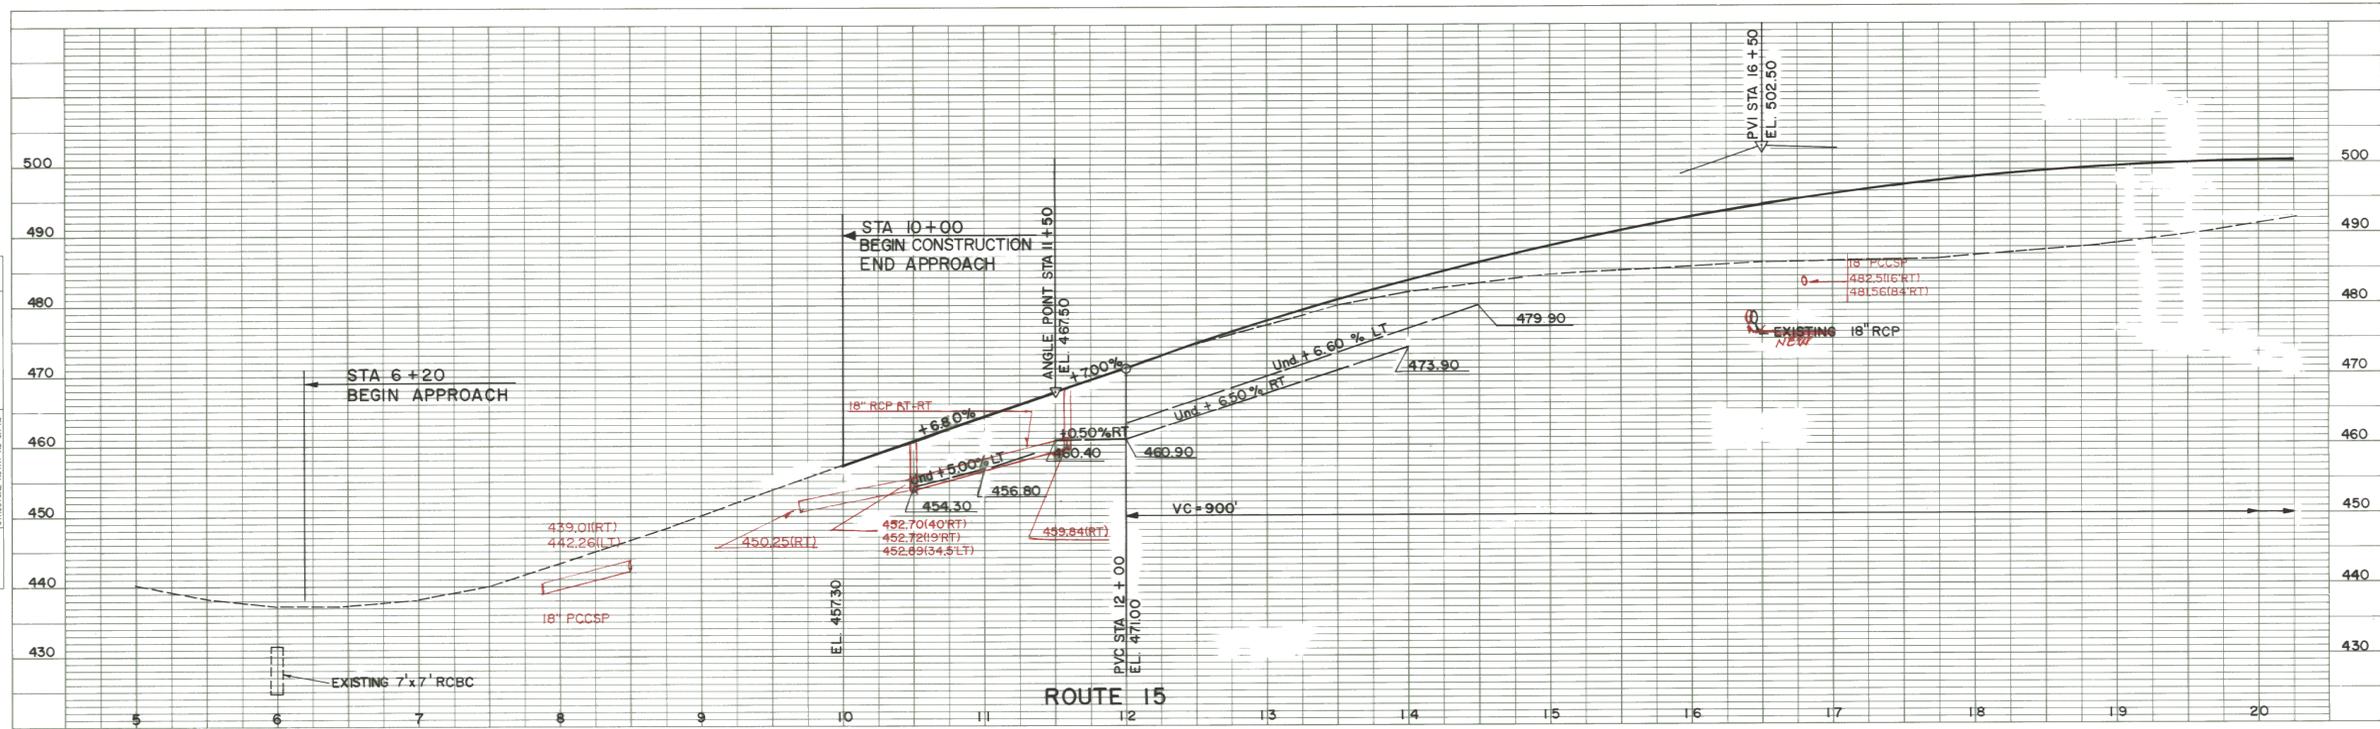


DATE	
BY	
PROF. NO.	
DATE	
BY	
PROF. NO.	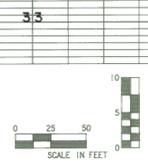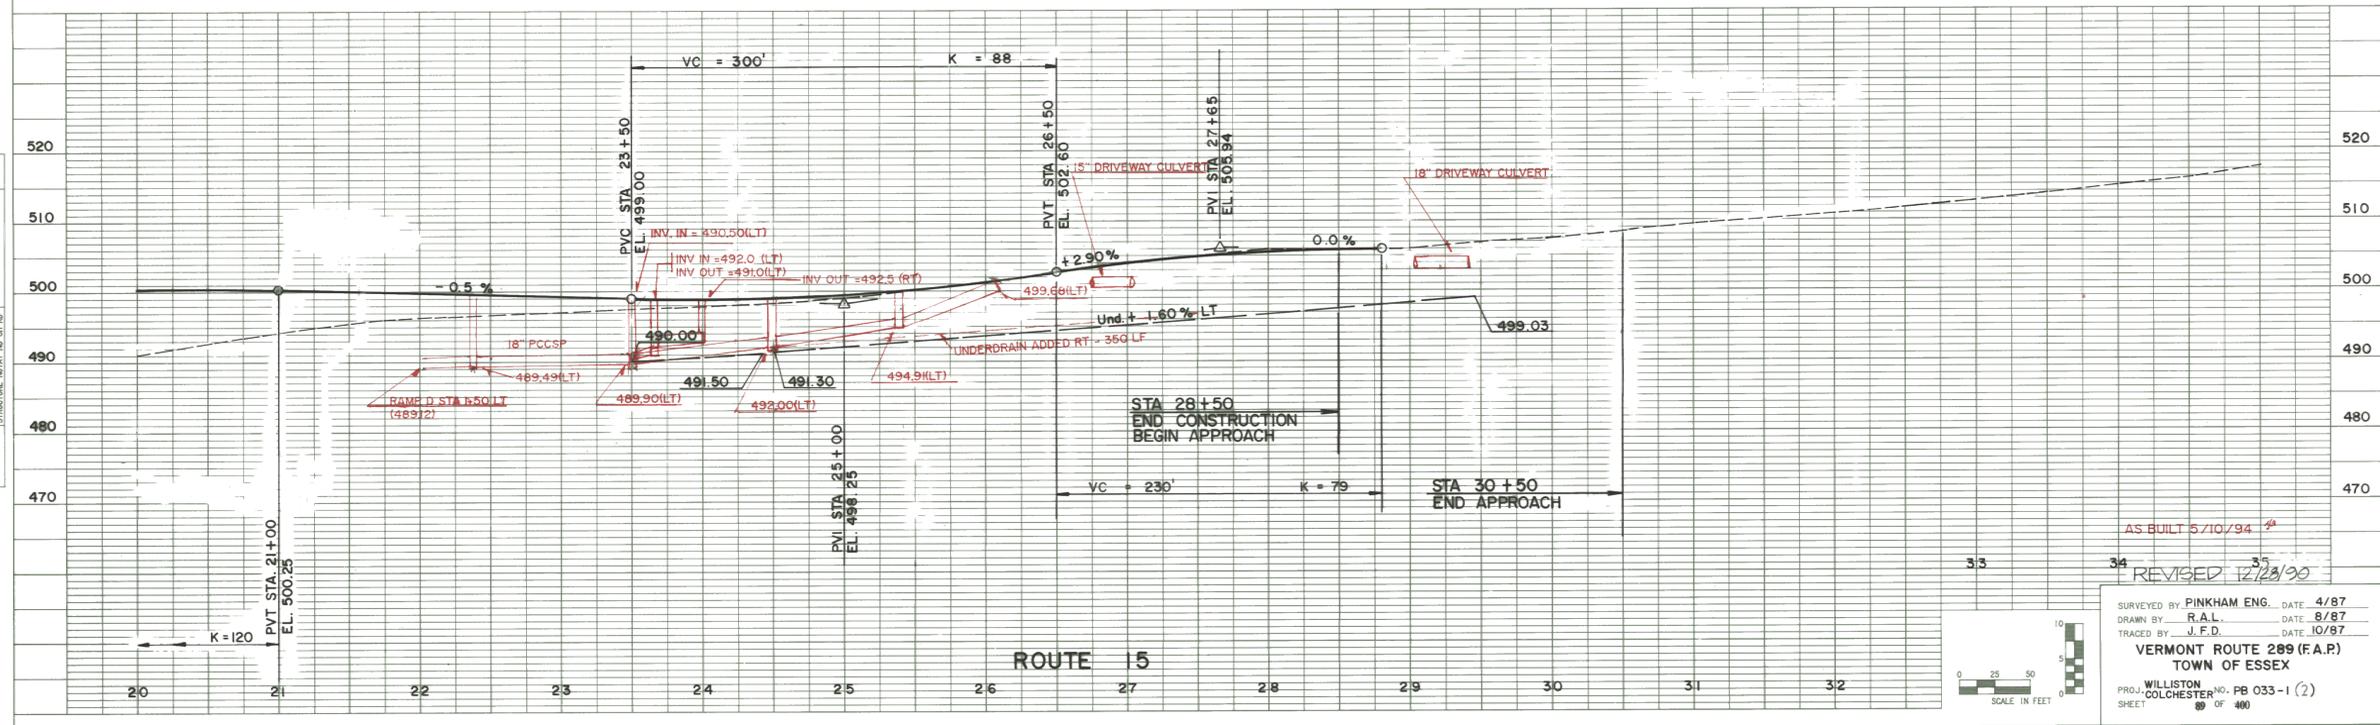
AS BUILT 5/10/94
 REVISED 12/23/90
 SURVEYED BY PINKHAM ENG. DATE 4/87
 DRAWN BY R.A.L. DATE 8/87
 TRACED BY J.F.D. DATE 10/87
 VERMONT ROUTE 209 (F.A.P.)
 TOWN OF ESSEX
 PROJ. WILLISTON COLCHESTER NO. PB 033-1 (2)
 SHEET 33 OF 400