
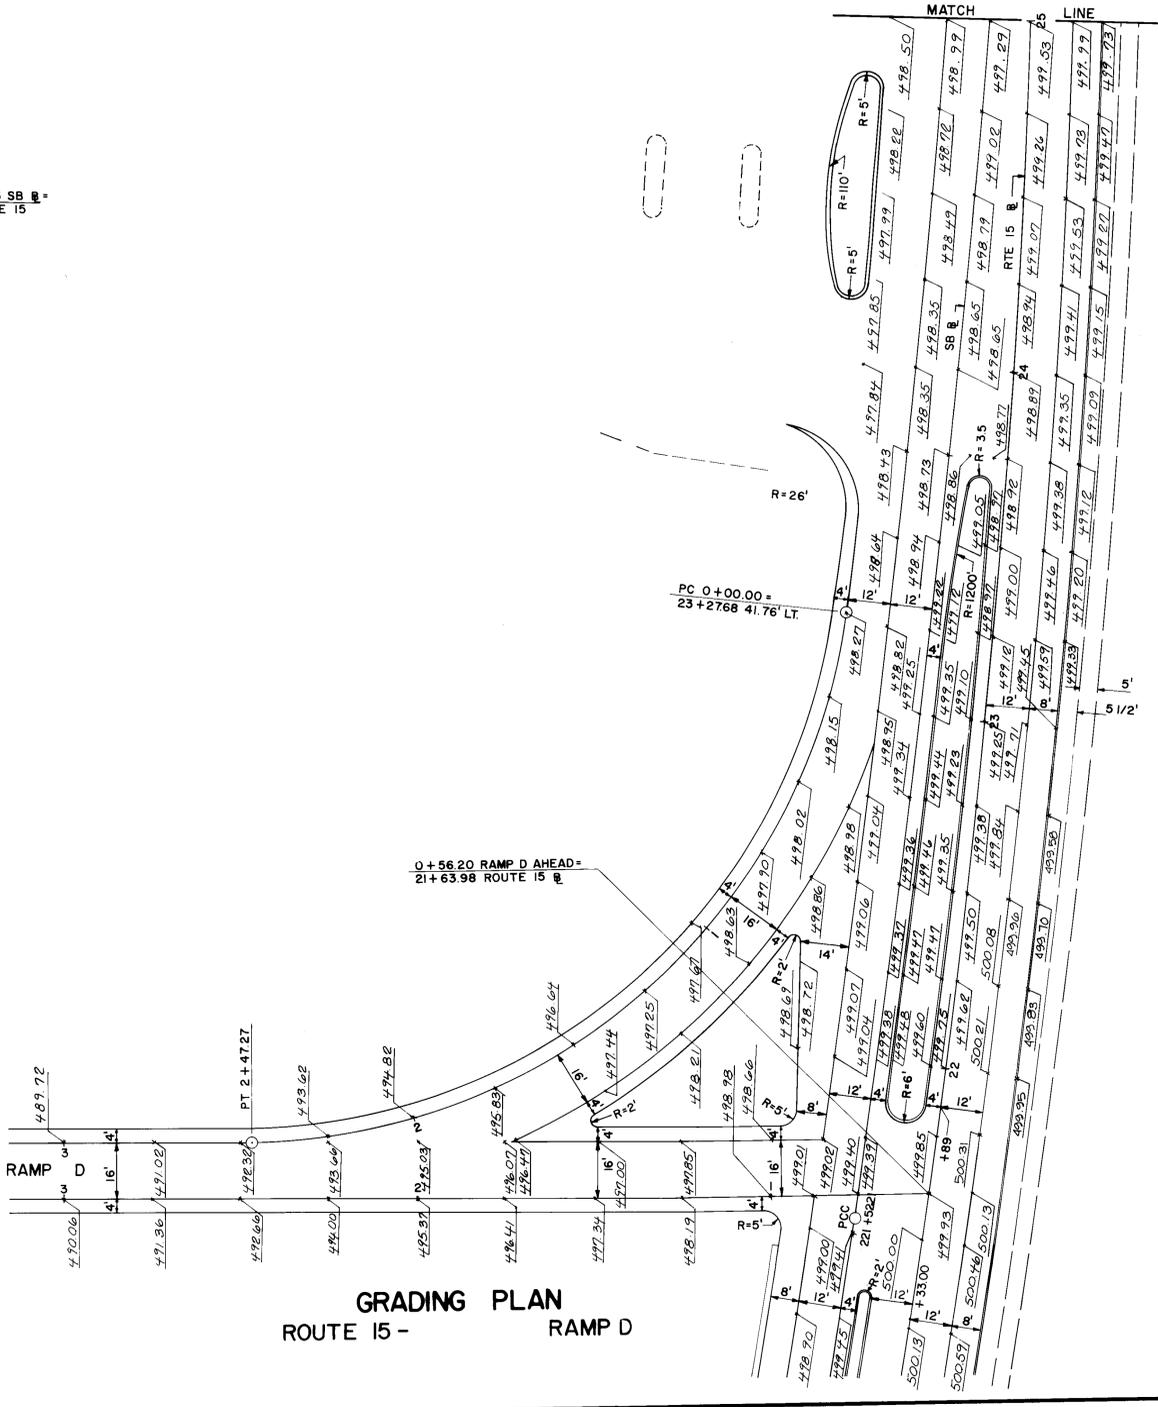


DATUM
 VERTICAL _____
 HORIZONTAL _____

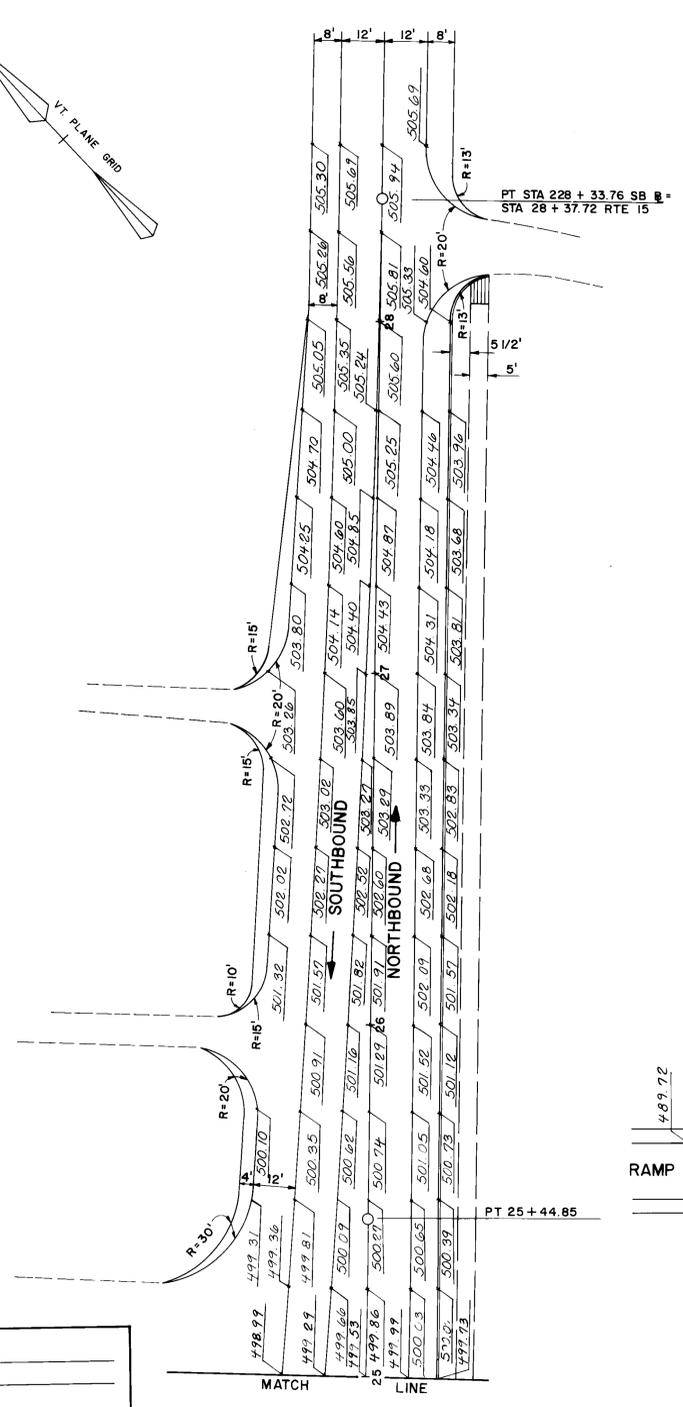

GRADING PLAN
 ROUTE 15 - RAMP D

BUILT AS DESIGNED 4/19/94
 REVISED 12/28/90

SURVEYED BY _____	DATE _____
DRAWN BY R.A.L. M.M.N.	DATE 4/88
TRACED BY N.P.D.	DATE 5/88
VERMONT ROUTE 289 (F.A.P.)	
TOWN OF ESSEX	
PROJ WILLISTON NO. PB 033-1 (2)	
COLCHESTER	
SHEET 94 OF 400	