




ABBREVIATIONS AND SYMBOLS

- SWEL 4" SOLID WHITE EDGE LINE (PAINT)
- SYEL 4" SOLID YELLOW EDGE LINE (PAINT)
- BWLL 4" BROKEN WHITE LANE LINE (10'/30' SPACING) (PAINT)
- SWLL 4" SOLID WHITE LANE LINE (PAINT)
- DYCL 4" DOUBLE YELLOW CENTER LINE (PAINT)
- SWCL 4" SOLID WHITE CHANNELIZATION LINE (PAINT)
- SYCL 4" SOLID YELLOW CHANNELIZATION LINE (PAINT)
- SWCHL 8" SOLID WHITE CHANNELIZATION LINE (DURABLE)

- WTL 8" WHITE TRANSVERSE LINE (5' C-C @ 45°) (DURABLE)
- YTL 8" YELLOW TRANSVERSE LINE (DURABLE)
- SL 24" STOP LINE (DURABLE)
- DYL 4" DOUBLE YELLOW LINE (DURABLE)

- TYPE I DELINEATOR
- TYPE II DELINEATOR
- ▲ TYPE III DELINEATOR
- ↑ SIGN POST
- ↓ OVERHEAD SIGN

TYPICAL SPACING (FOR DETAILS SEE VAOT STANDARD E-191)
(NOT TO SCALE)

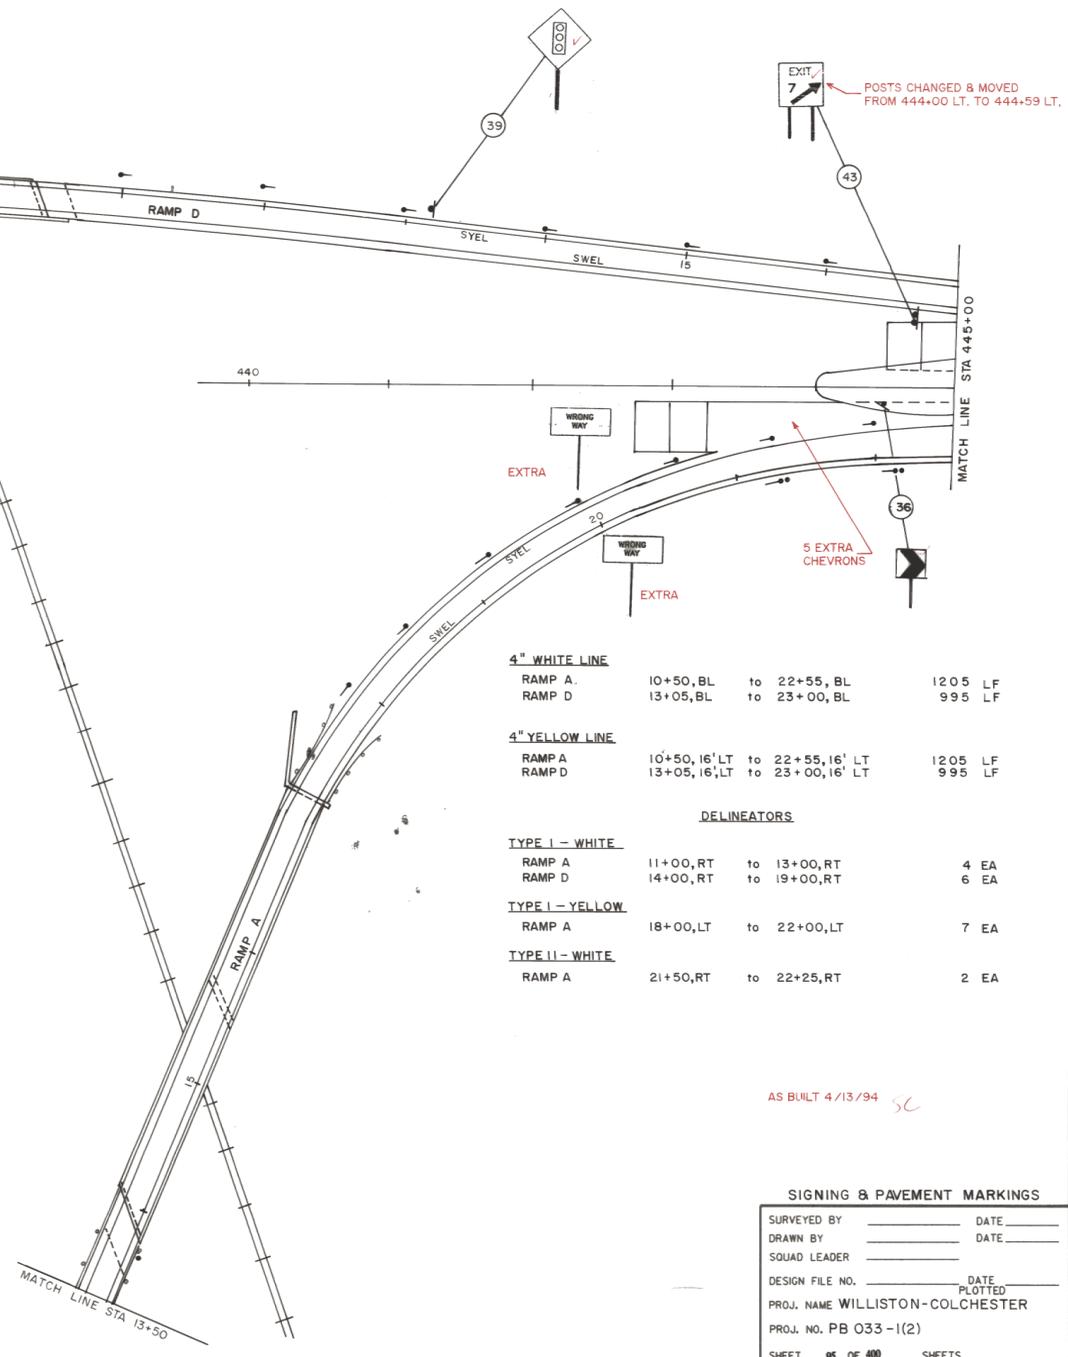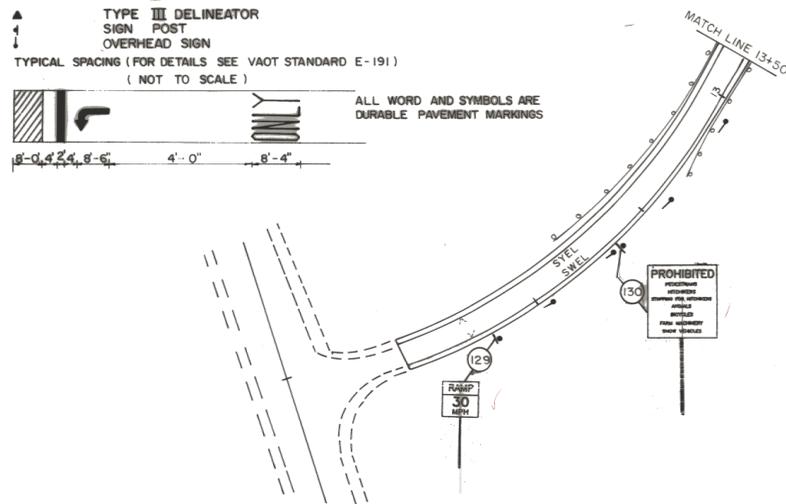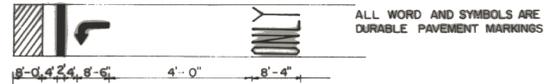

4" WHITE LINE			
RAMP A	10+50, BL	to 22+55, BL	1205 LF
RAMP D	13+05, BL	to 23+00, BL	995 LF

4" YELLOW LINE			
RAMP A	10+50, 16' LT	to 22+55, 16' LT	1205 LF
RAMP D	13+05, 16' LT	to 23+00, 16' LT	995 LF

DELINEATORS			
TYPE I - WHITE			
RAMP A	11+00, RT	to 13+00, RT	4 EA
RAMP D	14+00, RT	to 19+00, RT	6 EA
TYPE I - YELLOW			
RAMP A	18+00, LT	to 22+00, LT	7 EA
TYPE II - WHITE			
RAMP A	21+50, RT	to 22+25, RT	2 EA

AS BUILT 4/13/94 SC

SIGNING & PAVEMENT MARKINGS

SURVEYED BY _____ DATE _____
 DRAWN BY _____ DATE _____
 SQUAD LEADER _____
 DESIGN FILE NO. _____ DATE _____
 PLOTTED _____
 PROJ. NAME WILLISTON-COLCHESTER
 PROJ. NO. PB 033-1(2)
 SHEET 95 OF 400 SHEETS

DATUM
 VERTICAL _____
 HORIZONTAL _____