

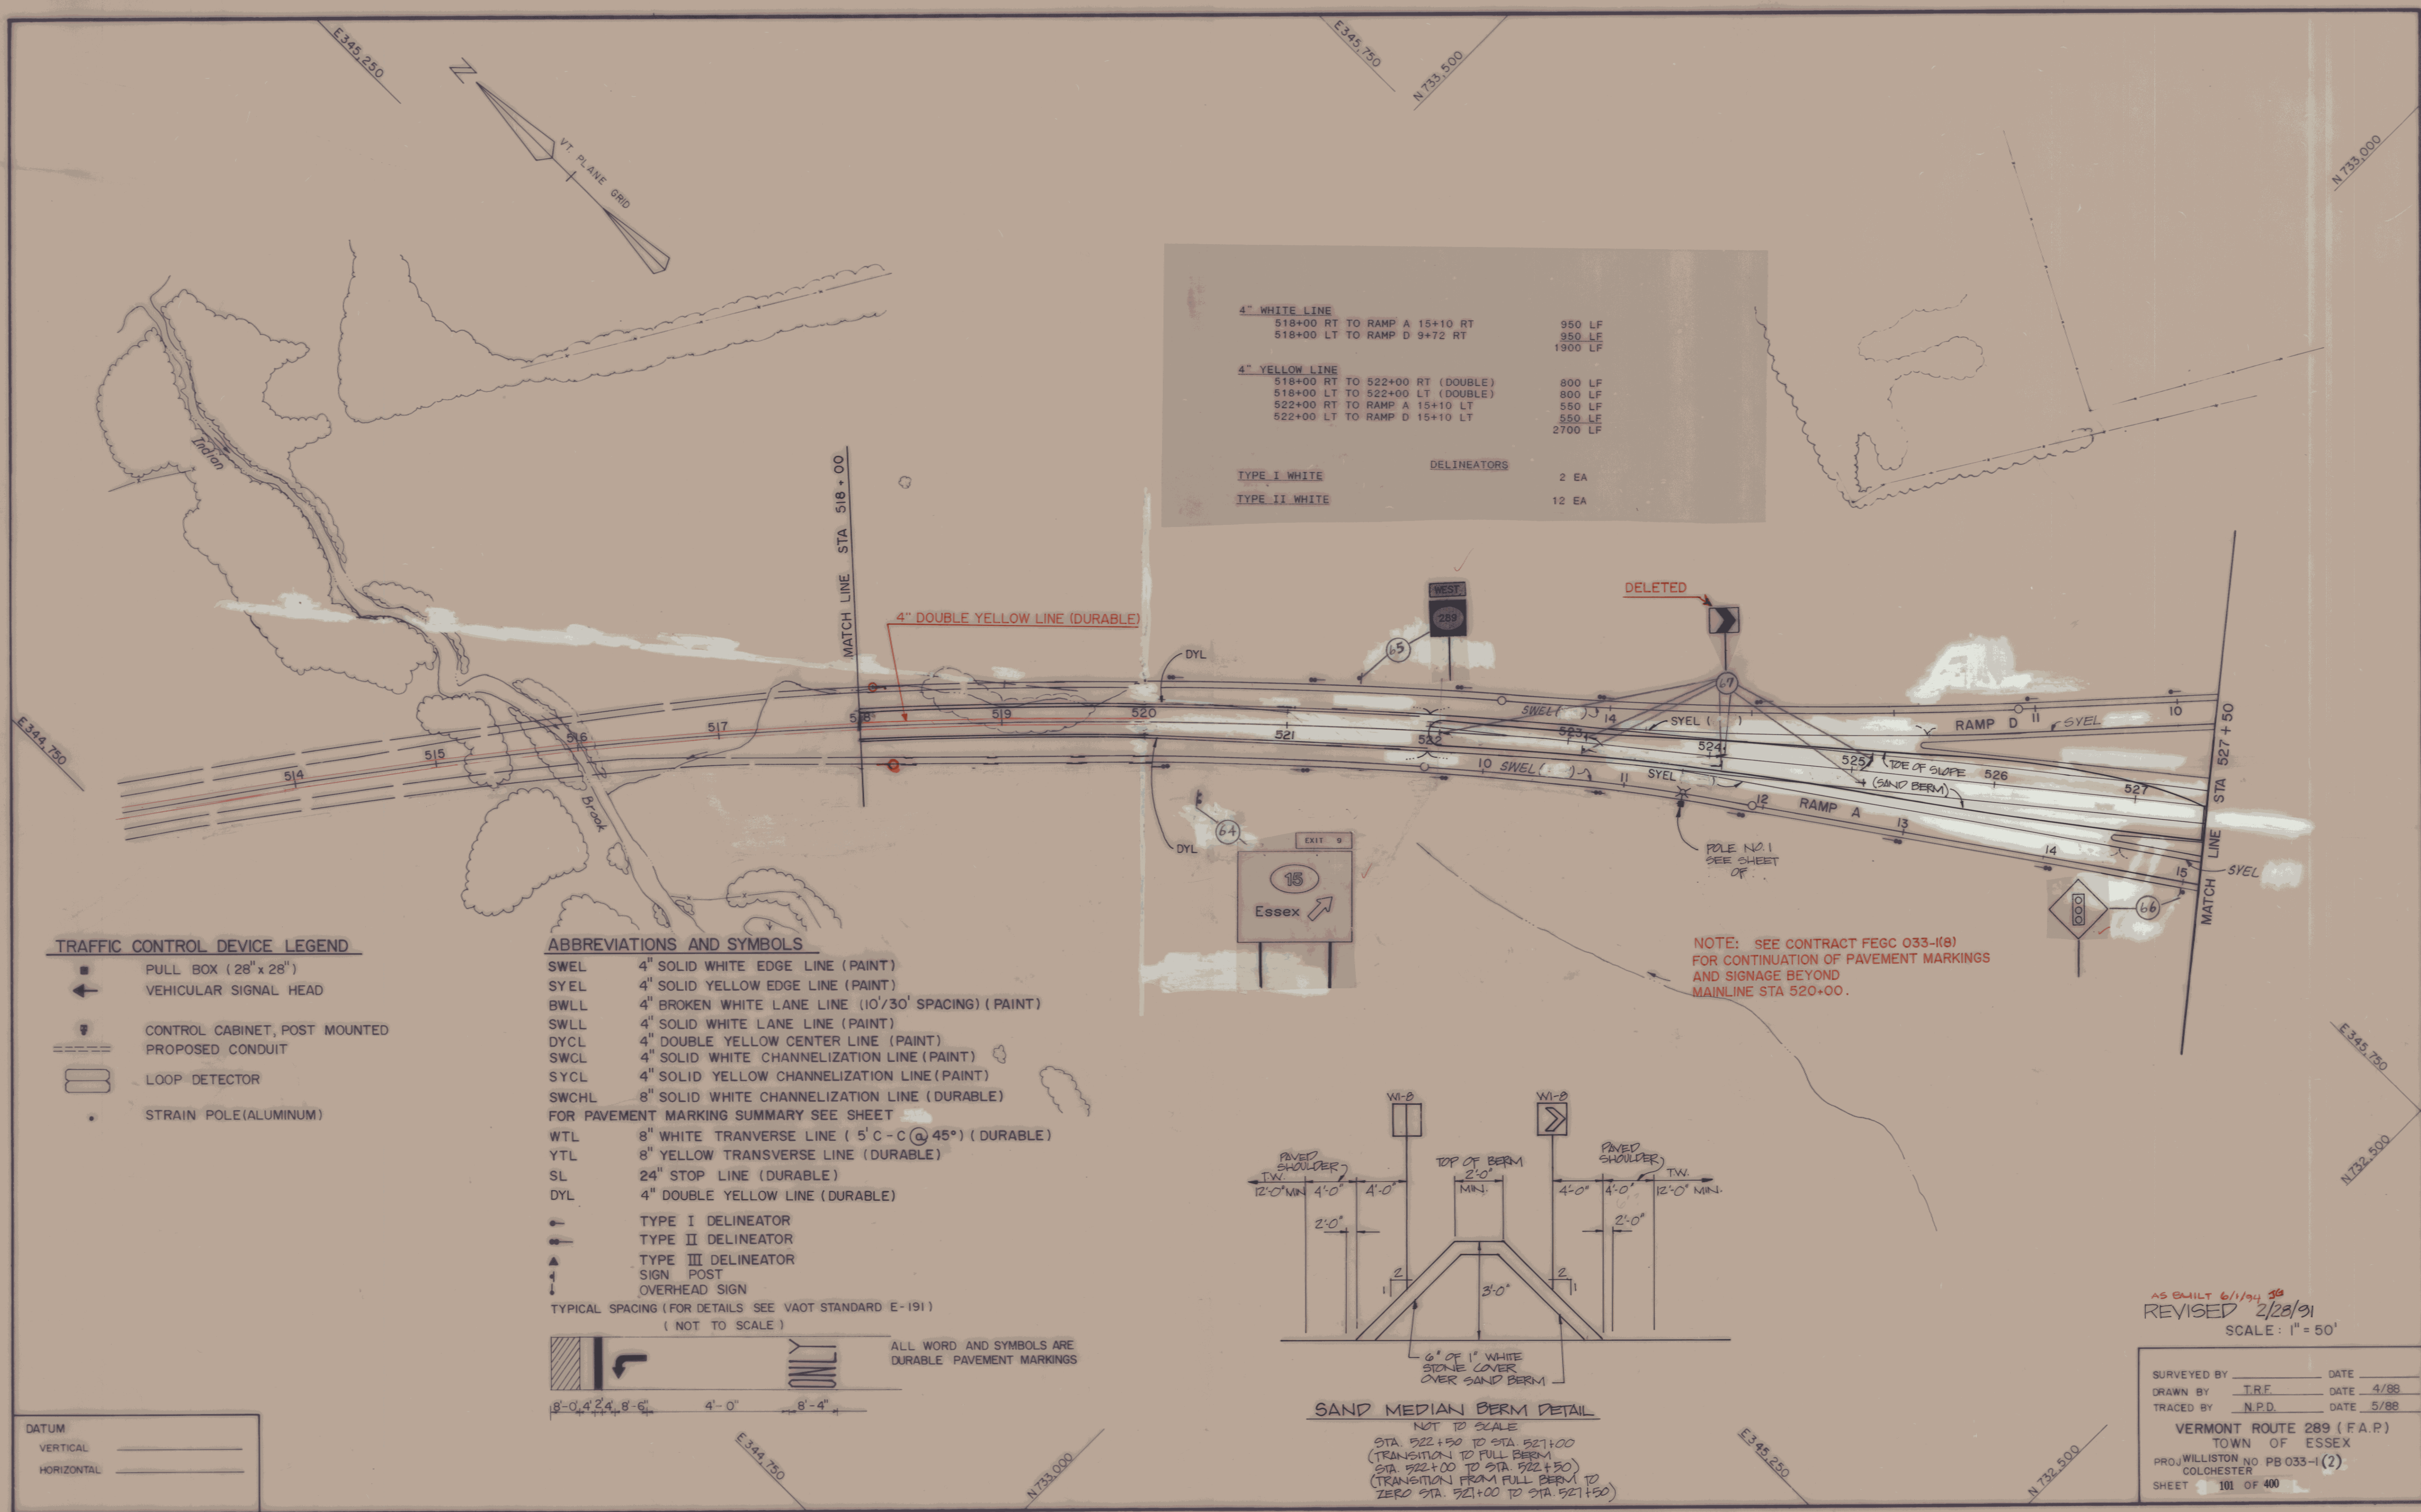


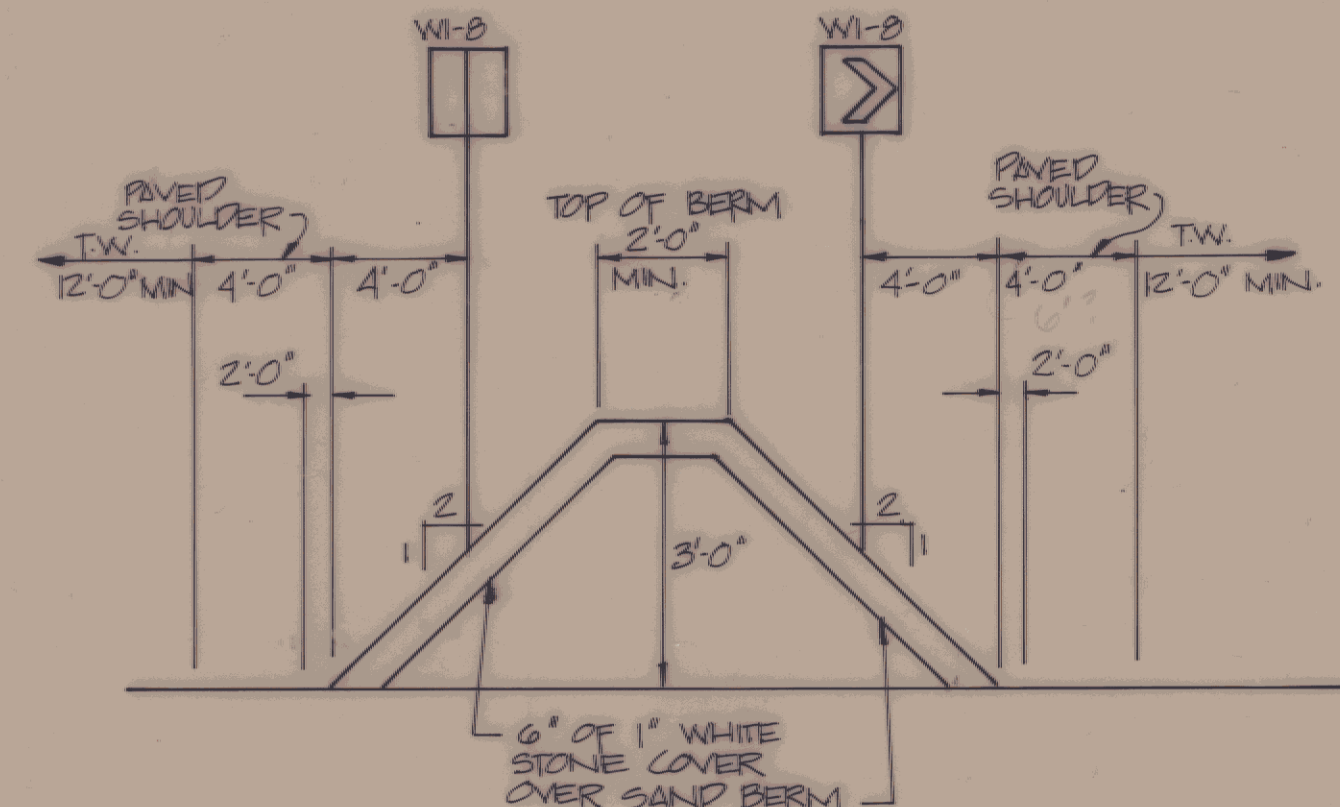

4" WHITE LINE		
518+00 RT TO RAMP A 15+10 RT	950 LF	
518+00 LT TO RAMP D 9+72 RT	950 LF	
	1900 LF	
4" YELLOW LINE		
518+00 RT TO 522+00 RT (DOUBLE)	800 LF	
518+00 LT TO 522+00 LT (DOUBLE)	800 LF	
522+00 RT TO RAMP A 15+10 LT	550 LF	
522+00 LT TO RAMP D 15+10 LT	550 LF	
	2700 LF	
DELINEATORS		
TYPE I WHITE	2 EA	
TYPE II WHITE	12 EA	

- TRAFFIC CONTROL DEVICE LEGEND**
- PULL BOX (28" x 28")
 - VEHICULAR SIGNAL HEAD
 - CONTROL CABINET, POST MOUNTED
 - PROPOSED CONDUIT
 - LOOP DETECTOR
 - STRAIN POLE (ALUMINUM)

- ABBREVIATIONS AND SYMBOLS**
- SWEL 4" SOLID WHITE EDGE LINE (PAINT)
 - SYEL 4" SOLID YELLOW EDGE LINE (PAINT)
 - BWLL 4" BROKEN WHITE LANE LINE (10'/30' SPACING) (PAINT)
 - SWLL 4" SOLID WHITE LANE LINE (PAINT)
 - DYCL 4" DOUBLE YELLOW CENTER LINE (PAINT)
 - SWCL 4" SOLID WHITE CHANNELIZATION LINE (PAINT)
 - SYCL 4" SOLID YELLOW CHANNELIZATION LINE (PAINT)
 - SWCHL 8" SOLID WHITE CHANNELIZATION LINE (DURABLE)
 - FOR PAVEMENT MARKING SUMMARY SEE SHEET
 - WTL 8" WHITE TRANSVERSE LINE (5' C-C @ 45°) (DURABLE)
 - YTL 8" YELLOW TRANSVERSE LINE (DURABLE)
 - SL 24" STOP LINE (DURABLE)
 - DYL 4" DOUBLE YELLOW LINE (DURABLE)
 - TYPE I DELINEATOR
 - TYPE II DELINEATOR
 - TYPE III DELINEATOR
 - SIGN POST
 - OVERHEAD SIGN
 - TYPICAL SPACING (FOR DETAILS SEE VAOT STANDARD E-191)
 - (NOT TO SCALE)

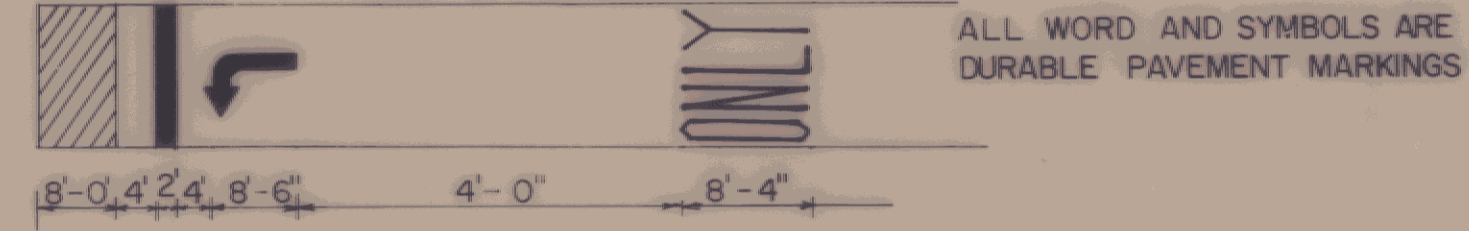

SAND MEDIAN BERM DETAIL

NOT TO SCALE
STA 522+50 TO STA 521+00
(TRANSITION TO FULL BERM)
STA 522+00 TO STA 522+50
(TRANSITION FROM FULL BERM TO
ZERO STA. 521+00 TO STA 521+50)

NOTE: SEE CONTRACT FECC 033-1(8)
FOR CONTINUATION OF PAVEMENT MARKINGS
AND SIGNAGE BEYOND
MAINLINE STA 520+00.

AS BUILT 6/1/91
REVISED 2/28/91
SCALE: 1" = 50'

SURVEYED BY	DATE
DRAWN BY T.R.F.	DATE 4/88
TRACED BY N.P.D.	DATE 5/88
VERMONT ROUTE 289 (F.A.P.)	
TOWN OF ESSEX	
PROJ. WILLISTON NO. PB 033-1 (2)	
COLCHESTER	
SHEET 101 OF 400	