


NOTE:
SEE LANG FARM ACCESS ROAD PLANS FOR REVISIONS TO SIGNS AND PAVEMENT MARKINGS.

4" WHITE LINE		
10+00 RT TO 15+45 RT		545 LF
10+00 LT TO 15+45 LT		545 LF
26+00 RT TO 30+00 RT		400 LF
26+00 LT TO 28+65 LT		285 LF
		1775 LF
4" YELLOW LINE		
10+00 TO 14+00 (DOUBLE)		800 LF
14+00 TO 15+45 (DIVIDED LINE)		290 LF
26+00 TO 28+00 (DIVIDED LINE)		400 LF
28+00 TO 30+50 (DOUBLE)		500 LF
		1990 LF

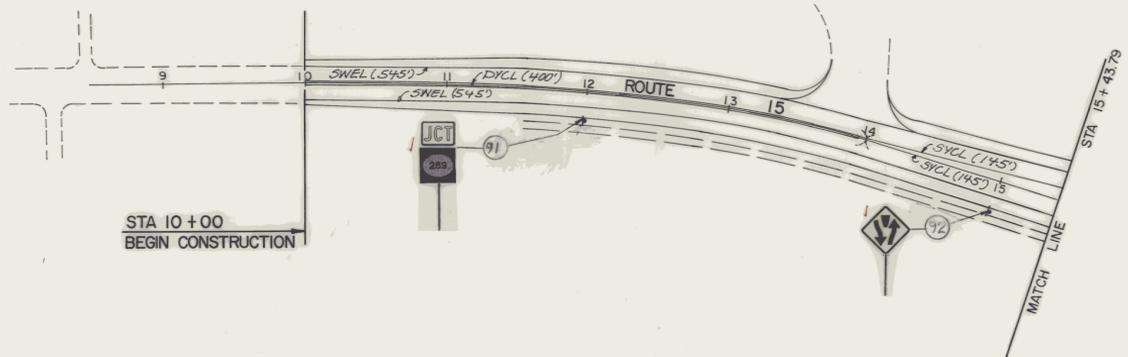

AS BUILT 4/13/94 SC

SCALE: 1" = 50'

DATUM
VERTICAL _____
HORIZONTAL _____

SURVEYED BY _____ DATE _____
DRAWN BY I.R.F. DATE 4/88
TRACED BY N.P.D. DATE 5/88
VERMONT ROUTE 289 (F.A.P.)
TOWN OF ESSEX
PROJ WILLISTON NO. PB 033-1 (2)
COLCHESTER
SHEET 103 OF 400