
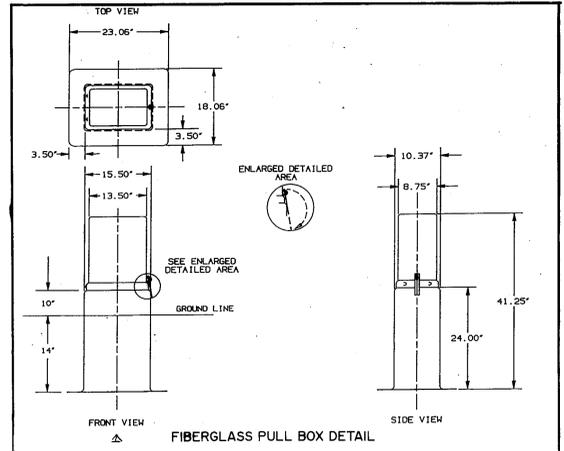
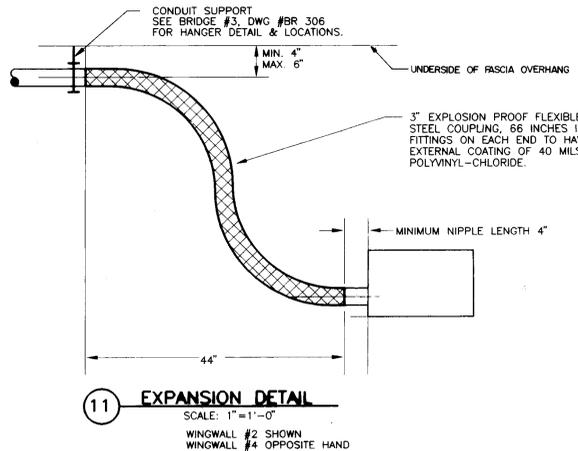
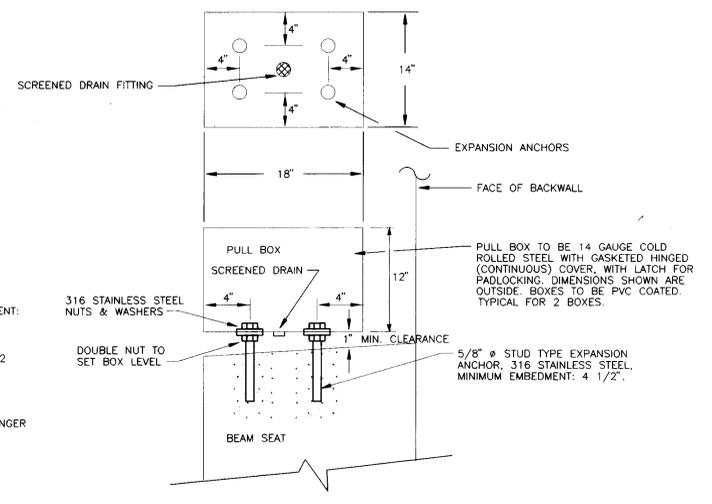
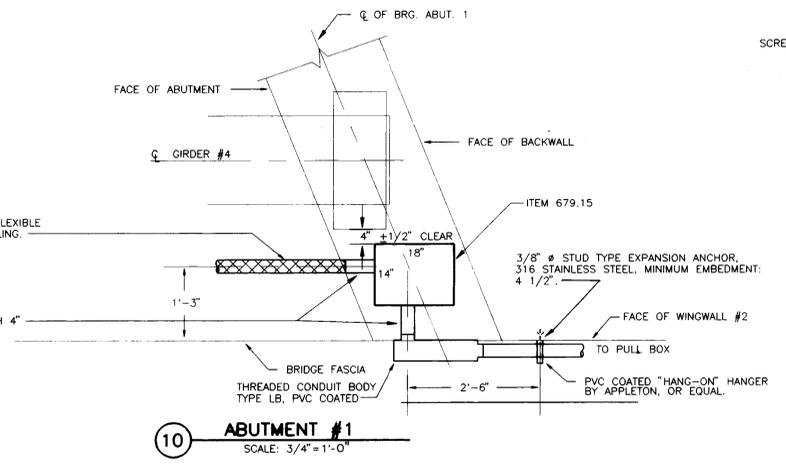


- NOTES:**
- FOR ADDITIONAL ABUTMENT AND WINGWALL DETAILS SEE BRIDGE NO. 3 DRAWINGS.
 - CONTRACTOR TO ADJUST POSITION OF SUPPORT AND ATTACHMENT AS REQUIRED TO CLEAR STRUCTURAL REINFORCING.
 - ALL WORK THIS SHEET TO BE INCLUDED IN ITEM 679.15 UNLESS OTHERWISE NOTED.
 - PVC COATED ITEMS: ALL CONDUIT, HANGERS, FITTINGS, METAL PULL BOXES, EXCEPT THE FLEXIBLE STAINLESS STEEL COUPLINGS, SHALL RECEIVE AN EXTERNAL MINIMUM 40 MIL PVC COATING, PER NEMA STANDARD #RH-1. ONLY TOOLS MADE FOR USE WITH PVC COATED CONDUIT, ETC. SHALL BE USED IN THE INSTALLATION. ALL NICKS, ETC. TO BE TOUCHED UP WITH FIELD KITS.
 - PVC CONDUIT ON THE BRIDGE OVER CVRR SHALL BE SCHEDULE 80 RIGID PVC AND SHALL BE UNIFORM BETWEEN PULL BOXES.

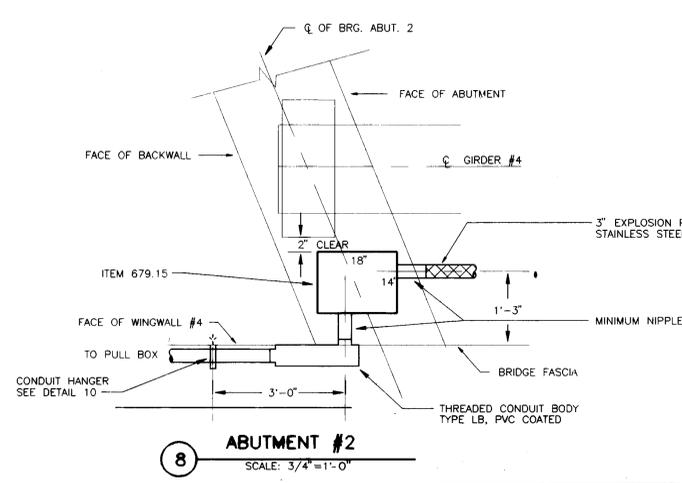

DATUM
VERTICAL N.G.V.D. 1929
HORIZONTAL N.A.D. 1927

BUILT AS DESIGNED 4/19/94

REVISD 5/15/91 - ADDED DETAILS

ALTERATION OF THIS DOCUMENT, EXCEPT BY A LICENSED PROFESSIONAL ENGINEER, IS ILLEGAL.

STATE OF VERMONT
REGISTERED PROFESSIONAL ENGINEER
No. 1005249

SURVEYED BY _____ DATE _____
DRAWN BY RAC DATE 9/90
TRACED BY _____ DATE _____
VERMONT ROUTE 289 (F.A.P.)
TOWN OF ESSEX
PROJ. WILLISTON- NO. PB 033-1(1)
COLCHESTER
SHEET 115 OF 400