


RAMP A

FINAL SURVEY
 REVISIONS
 DATE
 BY
 NO. OF SHEETS
 DATE CHECKED

ORIGINAL SURVEY
 REVISIONS
 DATE
 BY
 NO. OF SHEETS
 DATE CHECKED

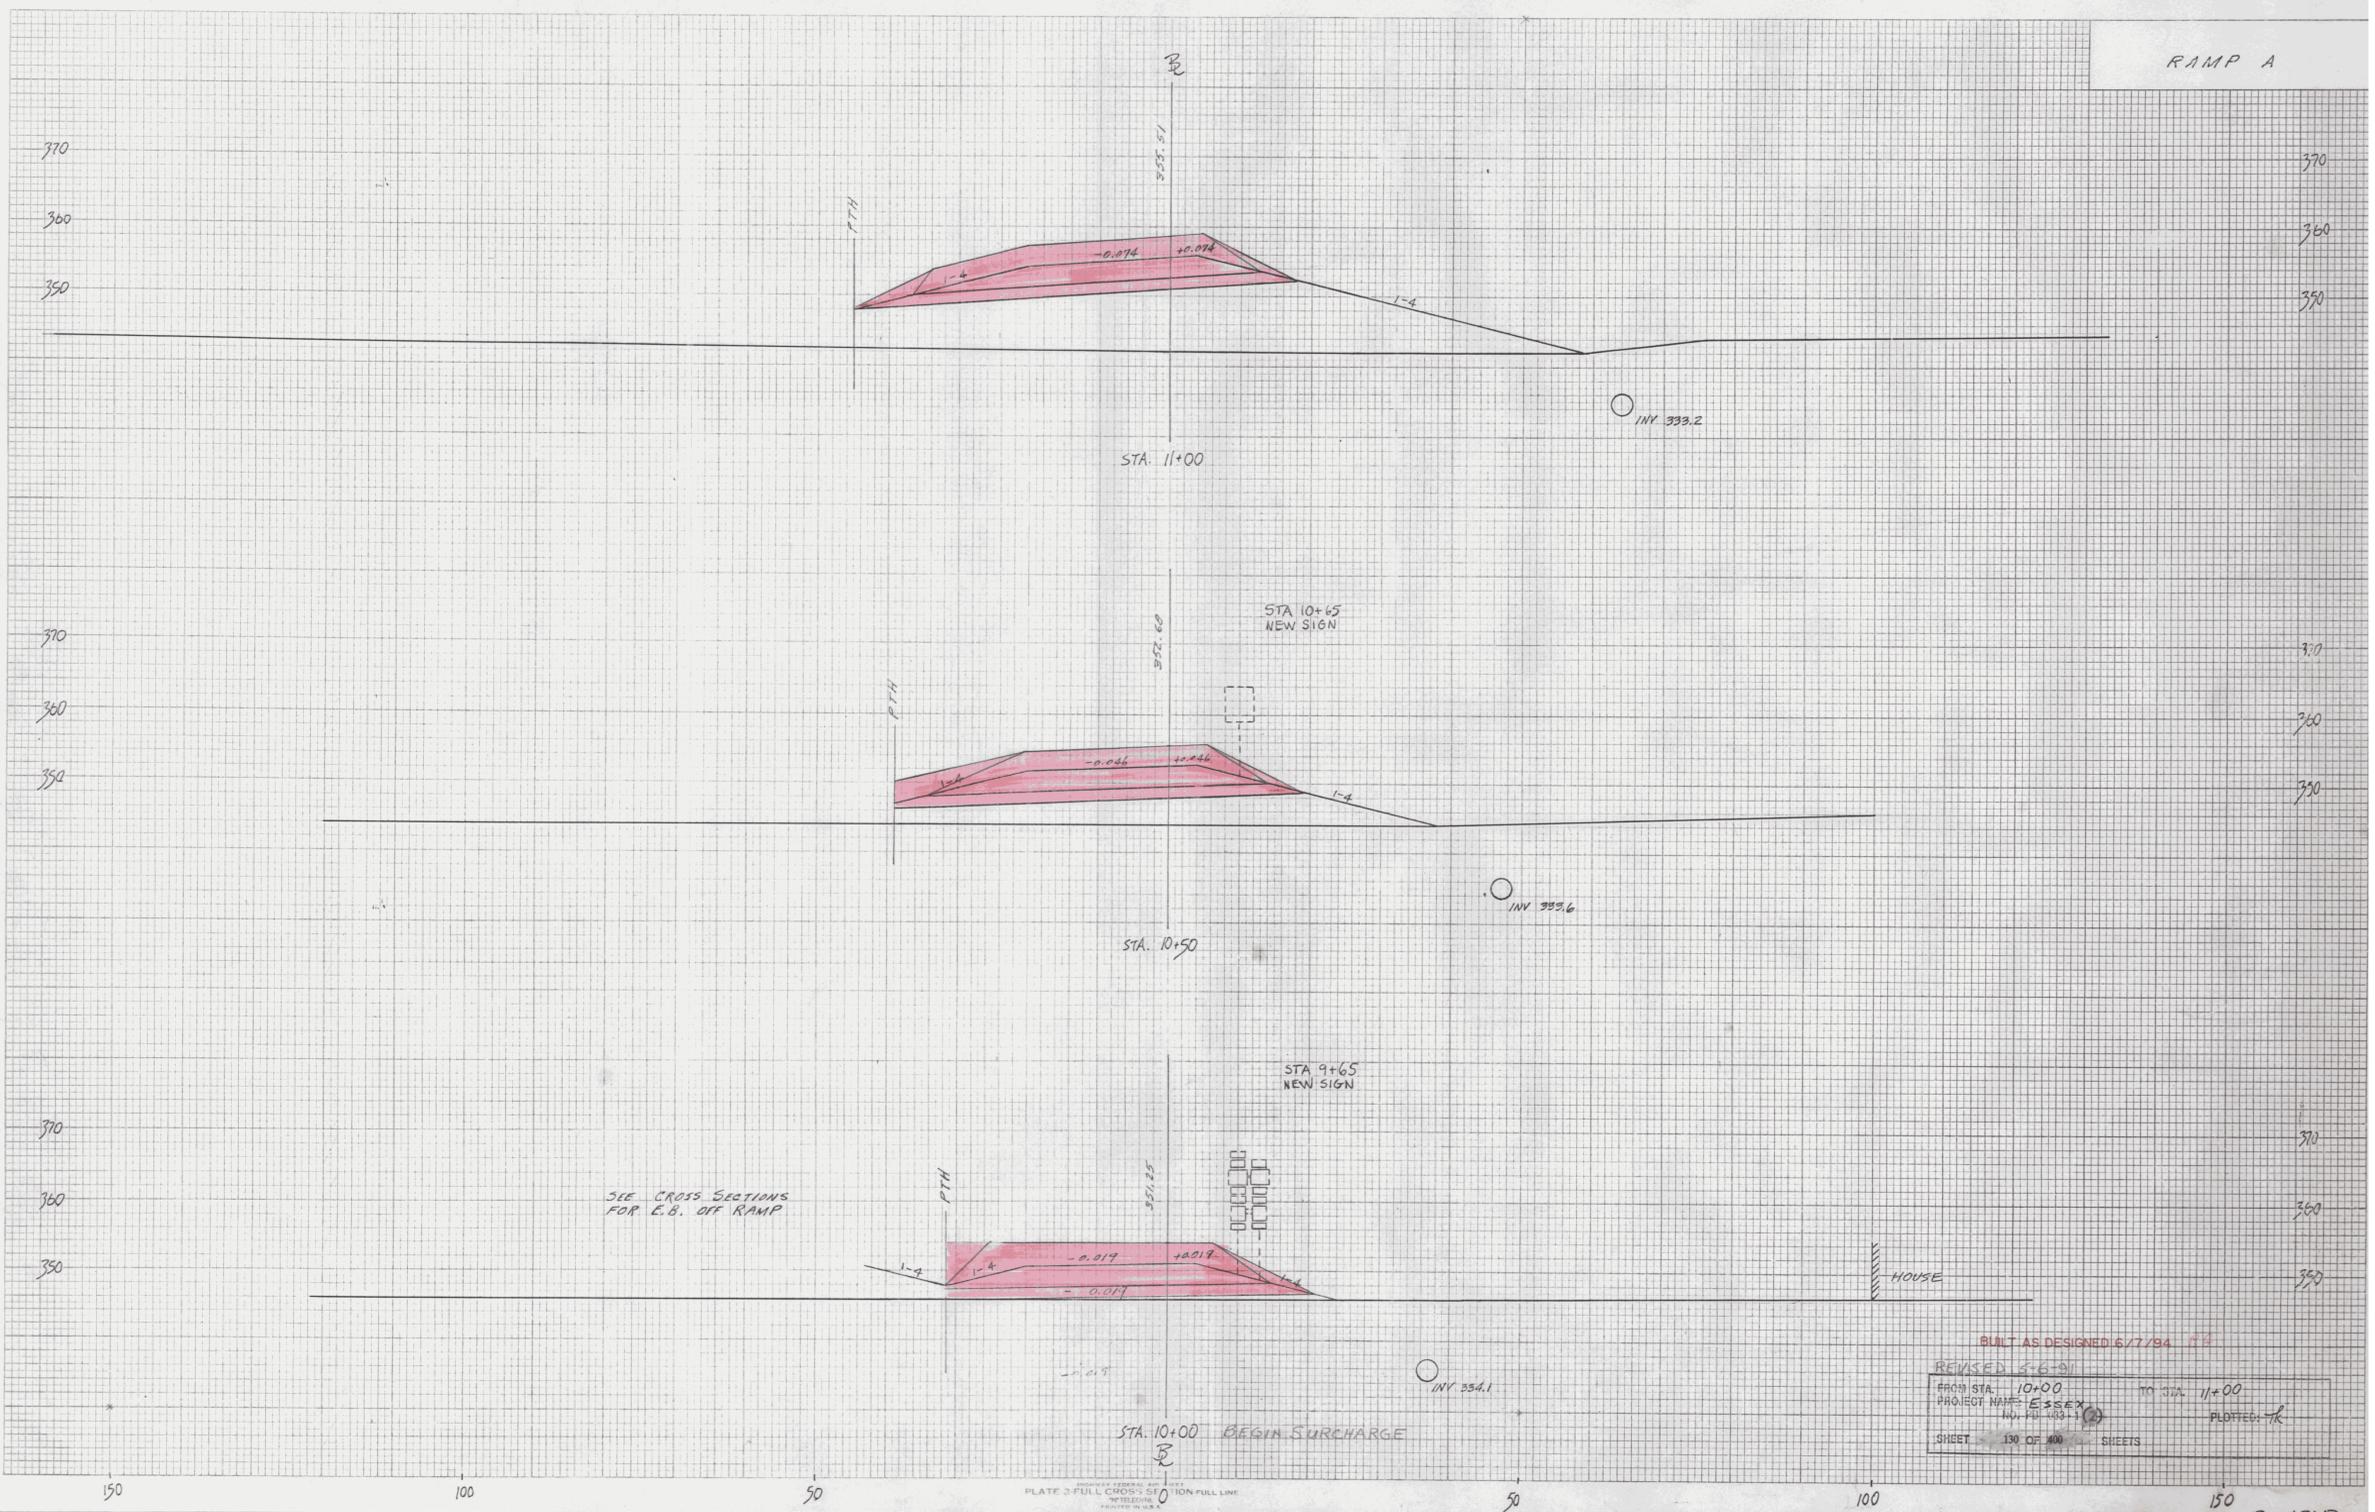

BUILT AS DESIGNED 6/7/94
 REVISED 6-6-01
 FROM STA. 10+00 TO STA. 11+00
 PROJECT NAME: ESSEX
 NO. 100-1
 SHEET 130 OF 100 SHEETS
 PLOTTED: R

PLATE 3 FULL CROSS OF 10" FULL LINE
 PRINTED IN U.S.A.

ES - ON RAMP