


RAMP A

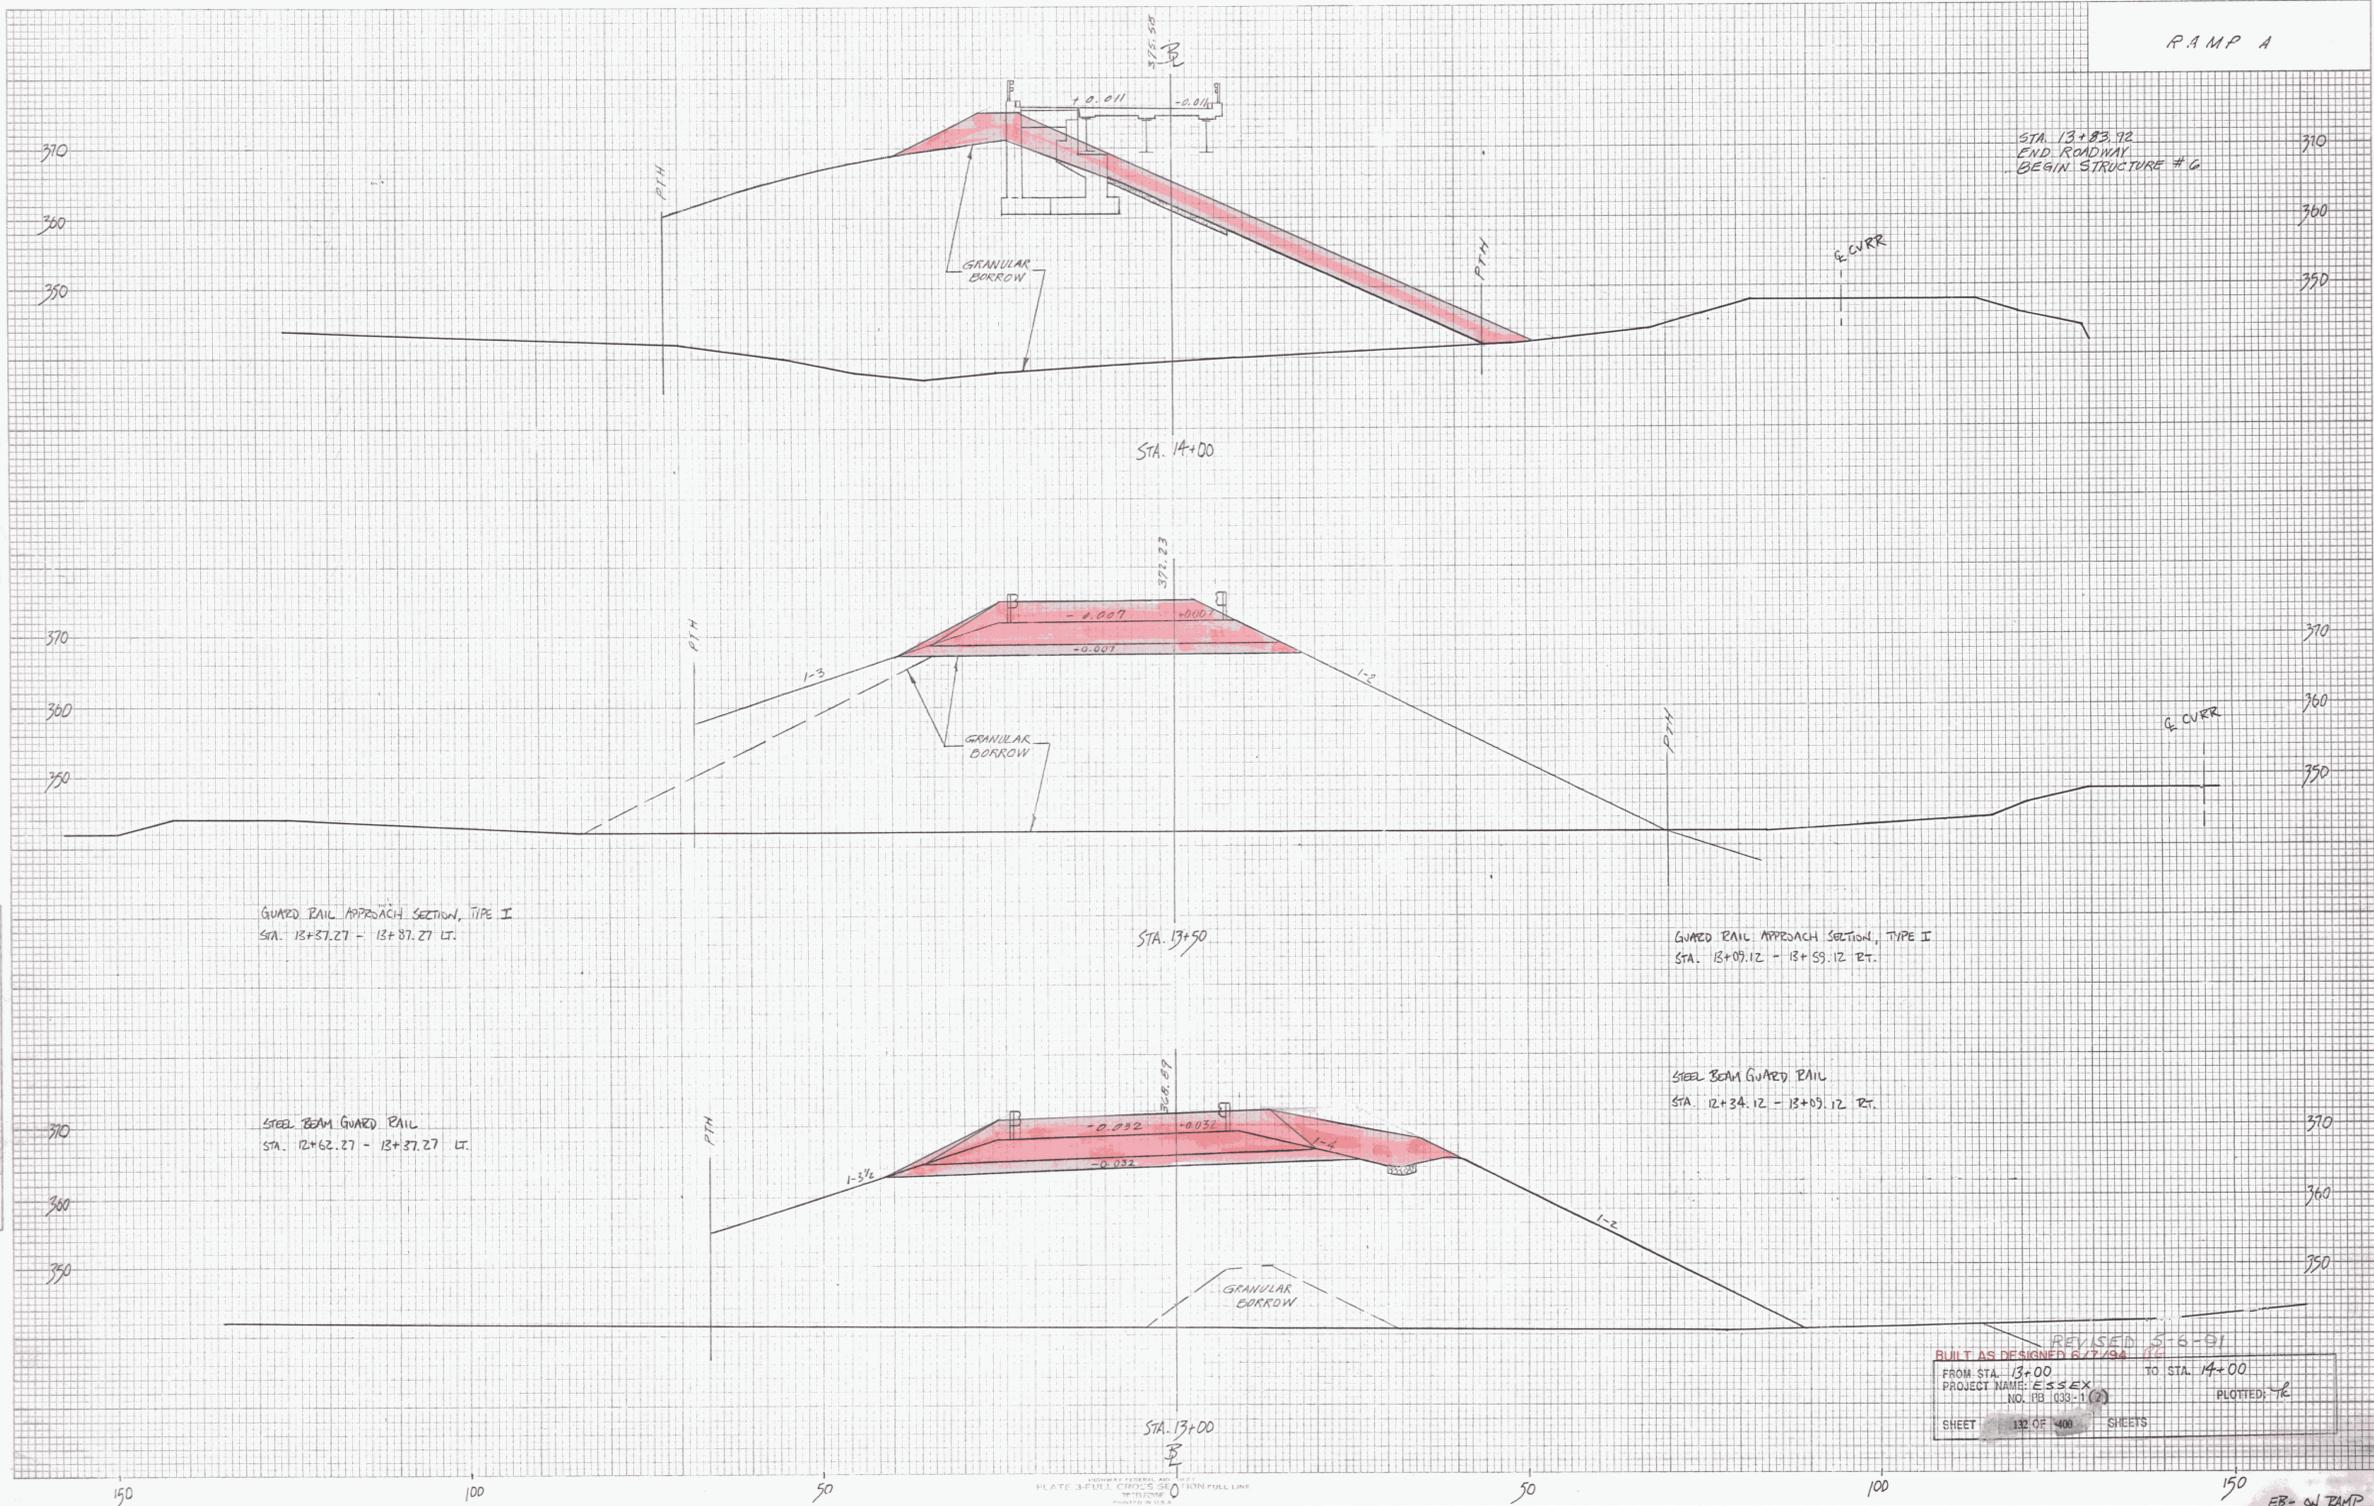

FINAL SURVEY
 DRAWING NO. 1033-11 (2)
 DATE DESIGNED: 6/7/94

ORIGINAL SURVEY
 DRAWING NO. 1033-11 (2)
 DATE DESIGNED: 6/7/94

GUARD RAIL APPROACH SECTION, TYPE I
 STA. 13+51.27 - 13+57.27 LT.

STEEL BEAM GUARD RAIL
 STA. 12+62.27 - 13+37.27 LT.

GUARD RAIL APPROACH SECTION, TYPE I
 STA. 13+09.12 - 13+59.12 RT.

STEEL BEAM GUARD RAIL
 STA. 12+34.12 - 13+09.12 RT.

REVISION 5-B-91
 BUILT AS DESIGNED 6/7/94
 FROM STA. 13+00 TO STA. 14+00
 PROJECT NAME: ESSEX
 NO. PB 1033-11 (2)
 SHEET 132 OF 400 SHEETS
 PLOTTED: 7/2

EB - ON RAMP