


RAMP A

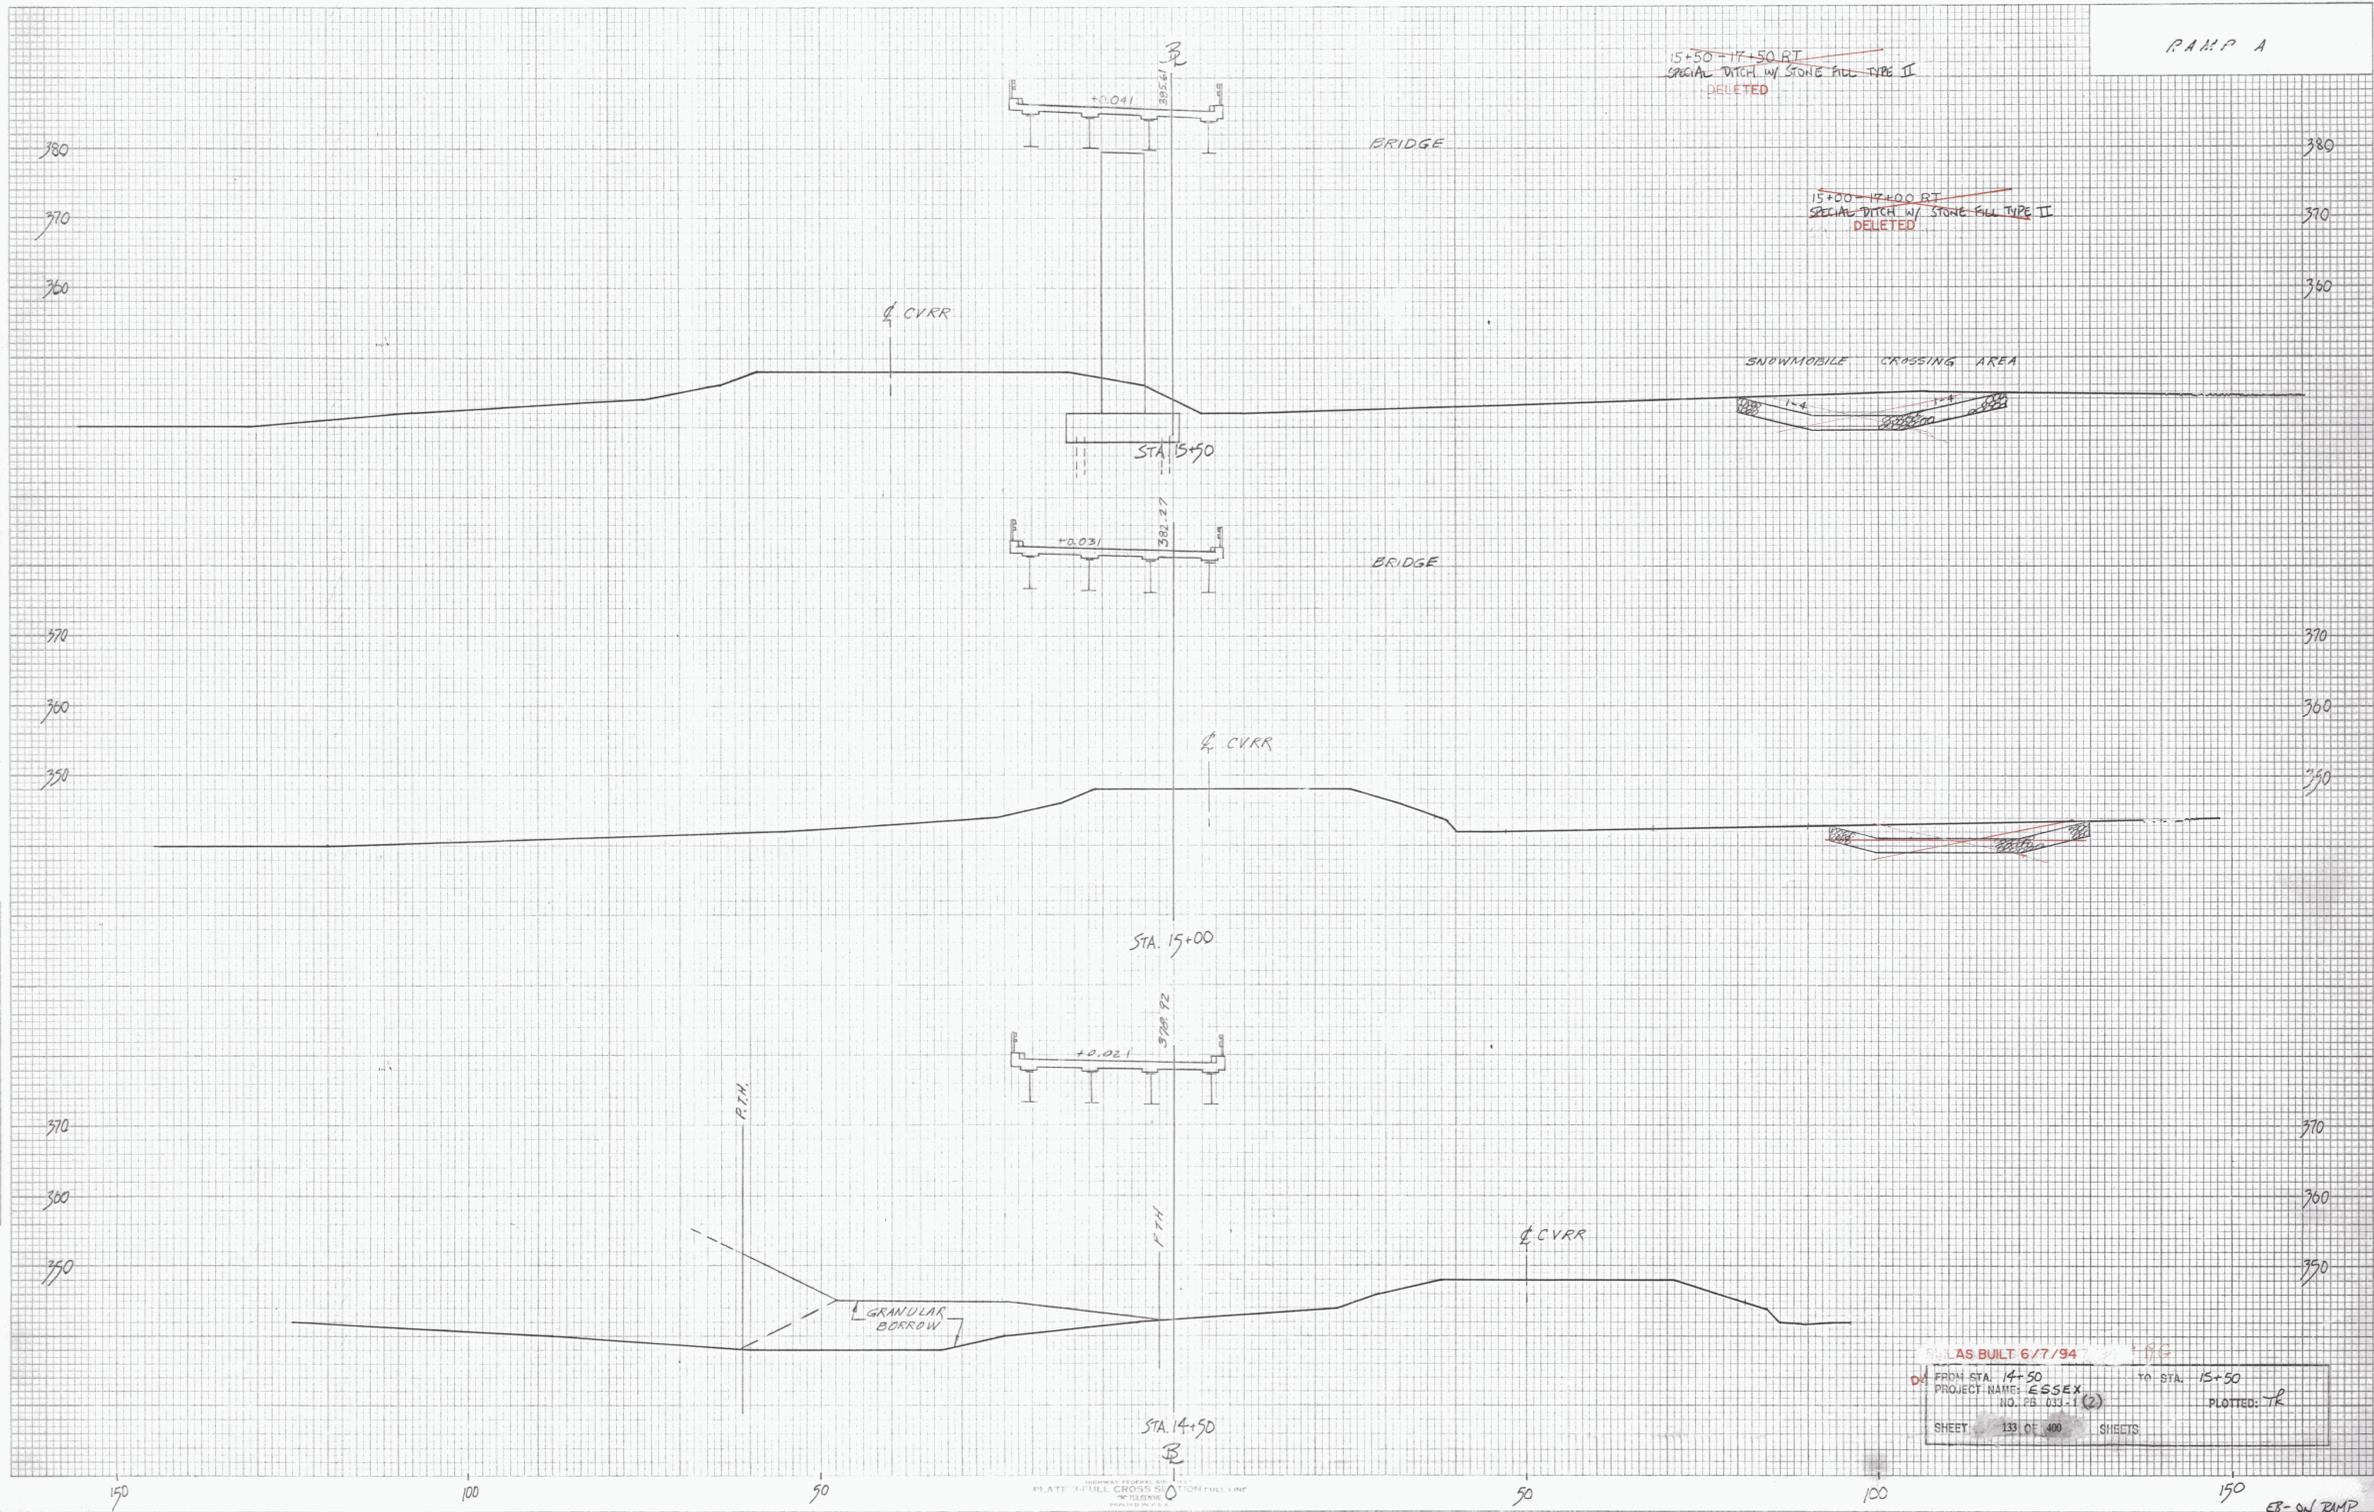

~~15+50-17+50 RT
SPECIAL DITCH W/ STONE FILL TYPE II
DELETED~~

~~15+00-17+00 RT
SPECIAL DITCH W/ STONE FILL TYPE II
DELETED~~

CL CVRR

STA 15+50

BRIDGE

CL CVRR

STA 15+00

CL CVRR

STA 14+50

GRANULAR BORROW

AS BUILT 6/7/94
 FROM STA: 14+50 TO STA: 15+50
 PROJECT NAME: ESSEX
 NO. 78-033-1 (2)
 SHEET 133 OF 400 SHEETS
 PLOTTED: TR

PLATE 3-7 FULL CROSS SECTION FULL LINE

ES-SN RAMP

FINAL SURVEY
 DATE: _____
 BY: _____
 CHECKED: _____
 NO. _____

ORIGINAL SURVEY
 DATE: _____
 BY: _____
 CHECKED: _____
 NO. _____