


RAMP A

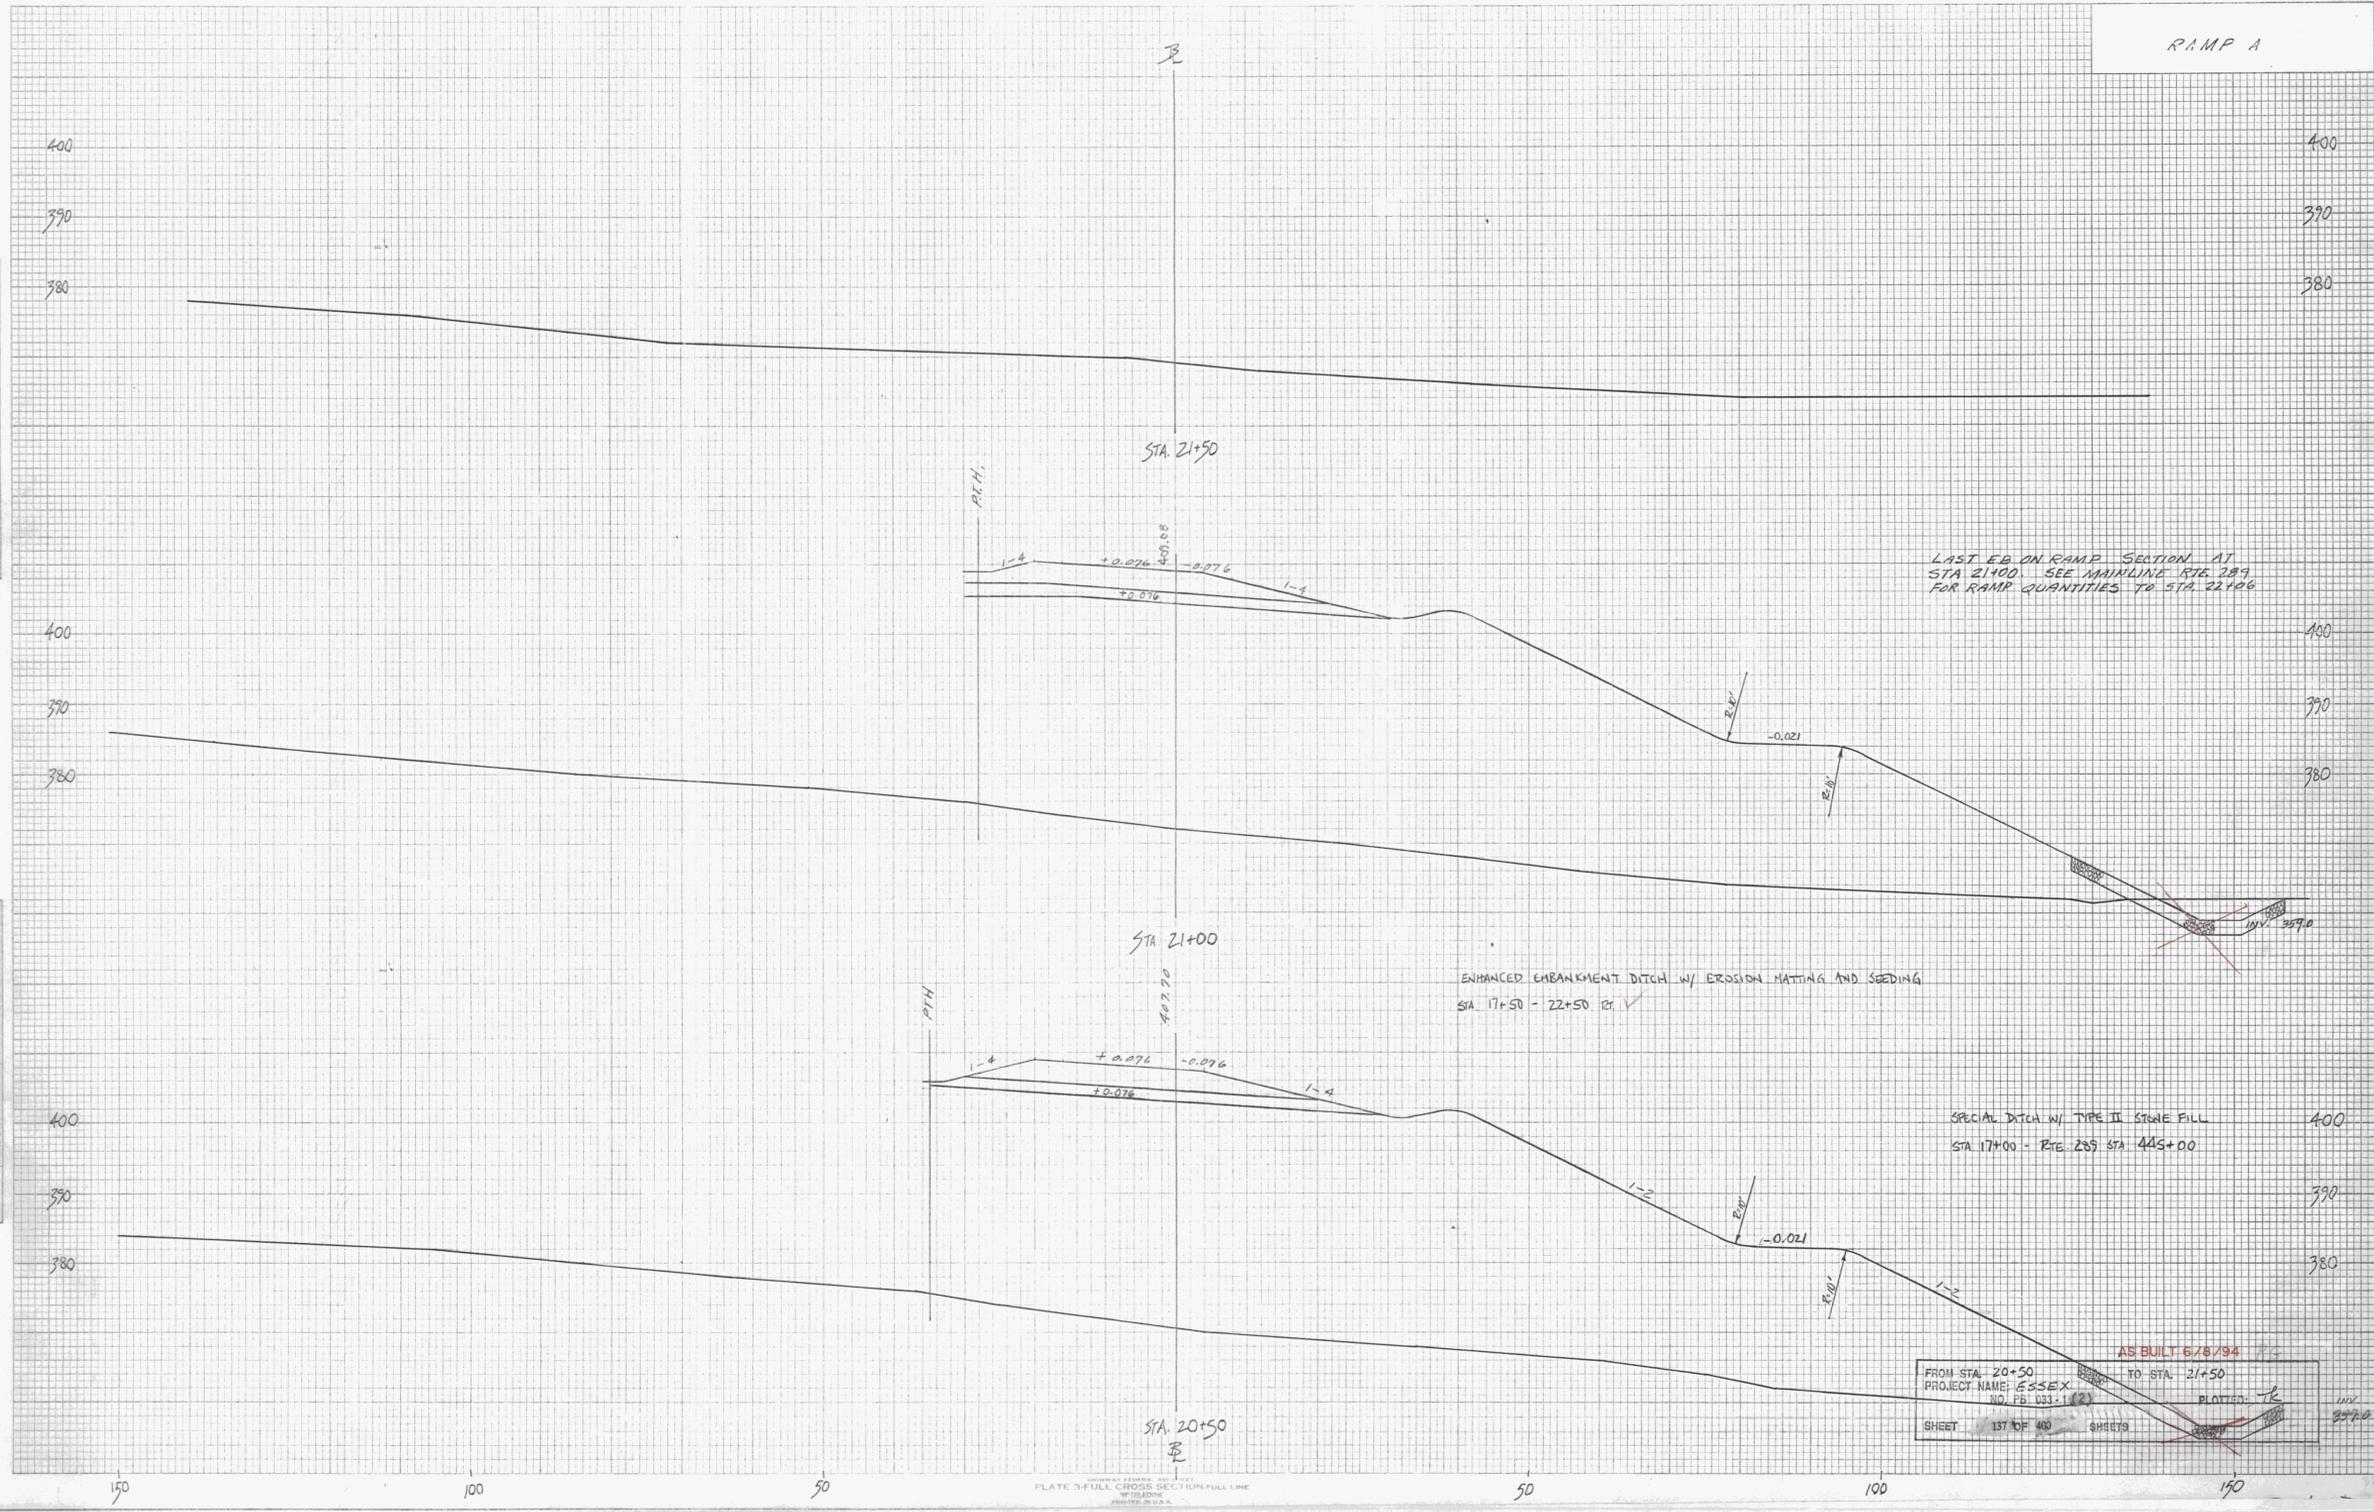

ORIGINAL SURVEY
 DATE: _____
 BY: _____
 REVISIONS:
 NO. DATE DESCRIPTION
 1. _____
 2. _____
 3. _____

ORIGINAL SURVEY
 DATE: _____
 BY: _____
 REVISIONS:
 NO. DATE DESCRIPTION
 1. _____
 2. _____
 3. _____